

5610 RD.
24354



7-B

-019
.90A.

234.96
-020
.45A.

236.03

-021
.60A.

237.75

-022

238

-045
.56A.

-076
1.28A.

-075 .17A.
243.71

-047
.68A

245.25

33

-023
50A.

-016
178.84
206.84
216.74
202.1


-017
25A.
212.27

-018
44A.

275x75 = 20,625 sq ft
750
A 26x75
10
A 28x75
10
750
22,125
22,125 ÷ 43560 = 51 AC

-042
1.11A.
659.30²⁰
-043
50A
51AC

5610
APPROVED
LORAIN CO.
MAP DEPT.
DATE 2-2-72
07-00-034B
BY LWHall

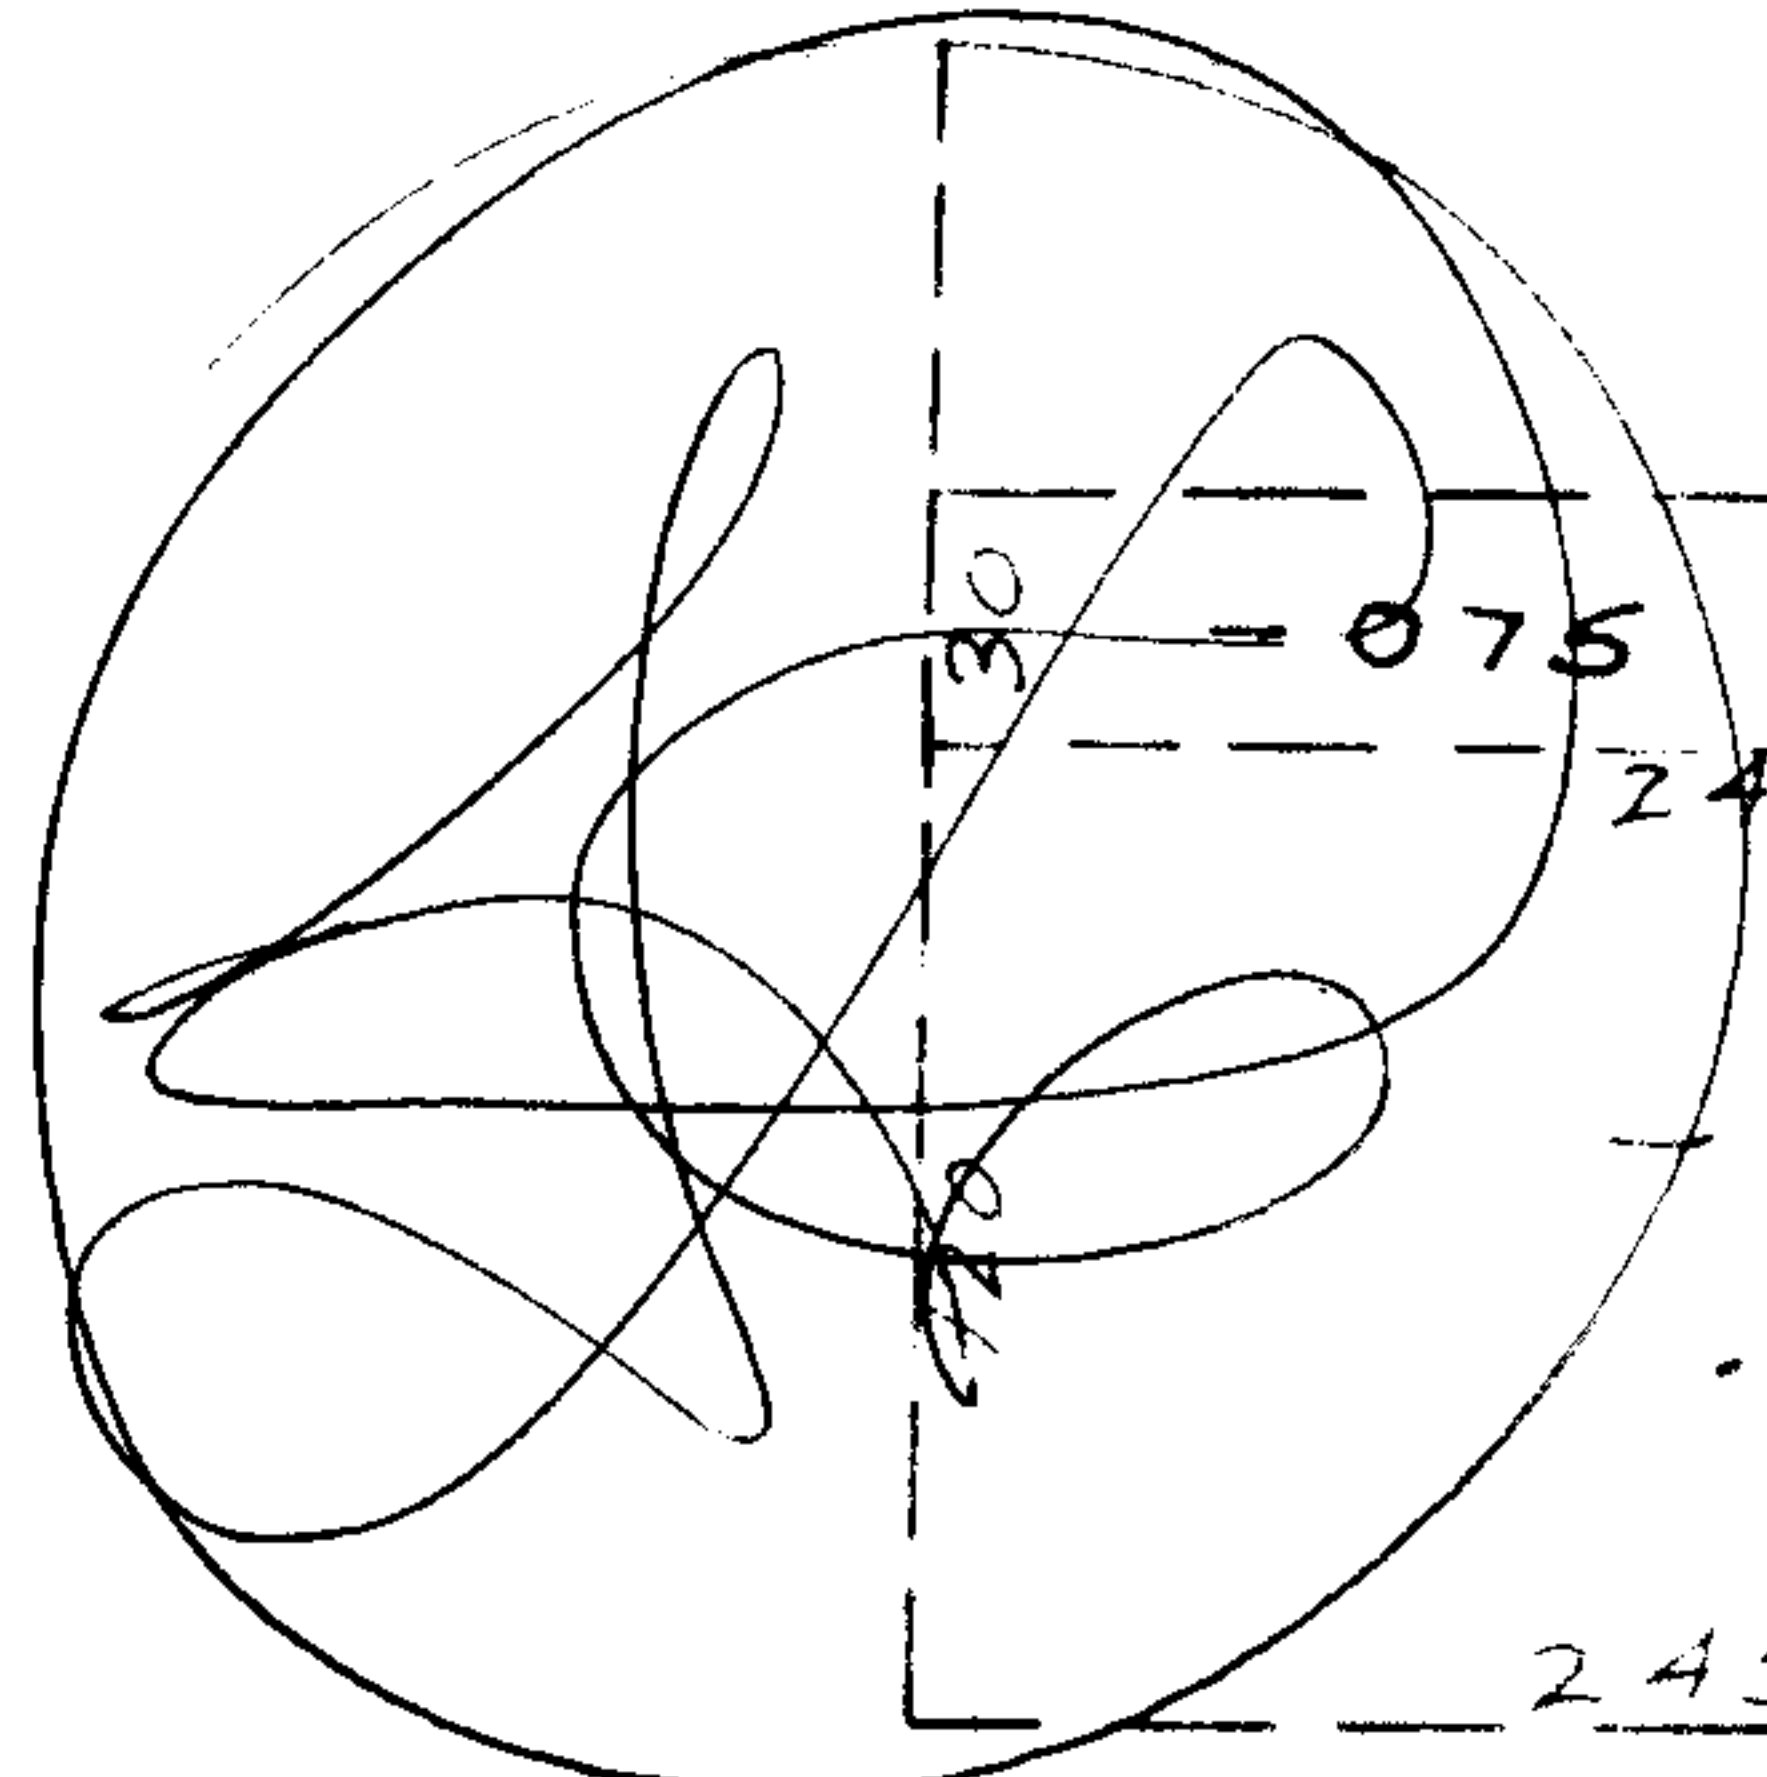

MAR 17 ENT'D

Pt. - C78
Pt 14 55A

7-00-034B

1485
1778
5537