


5612

BURSLEY

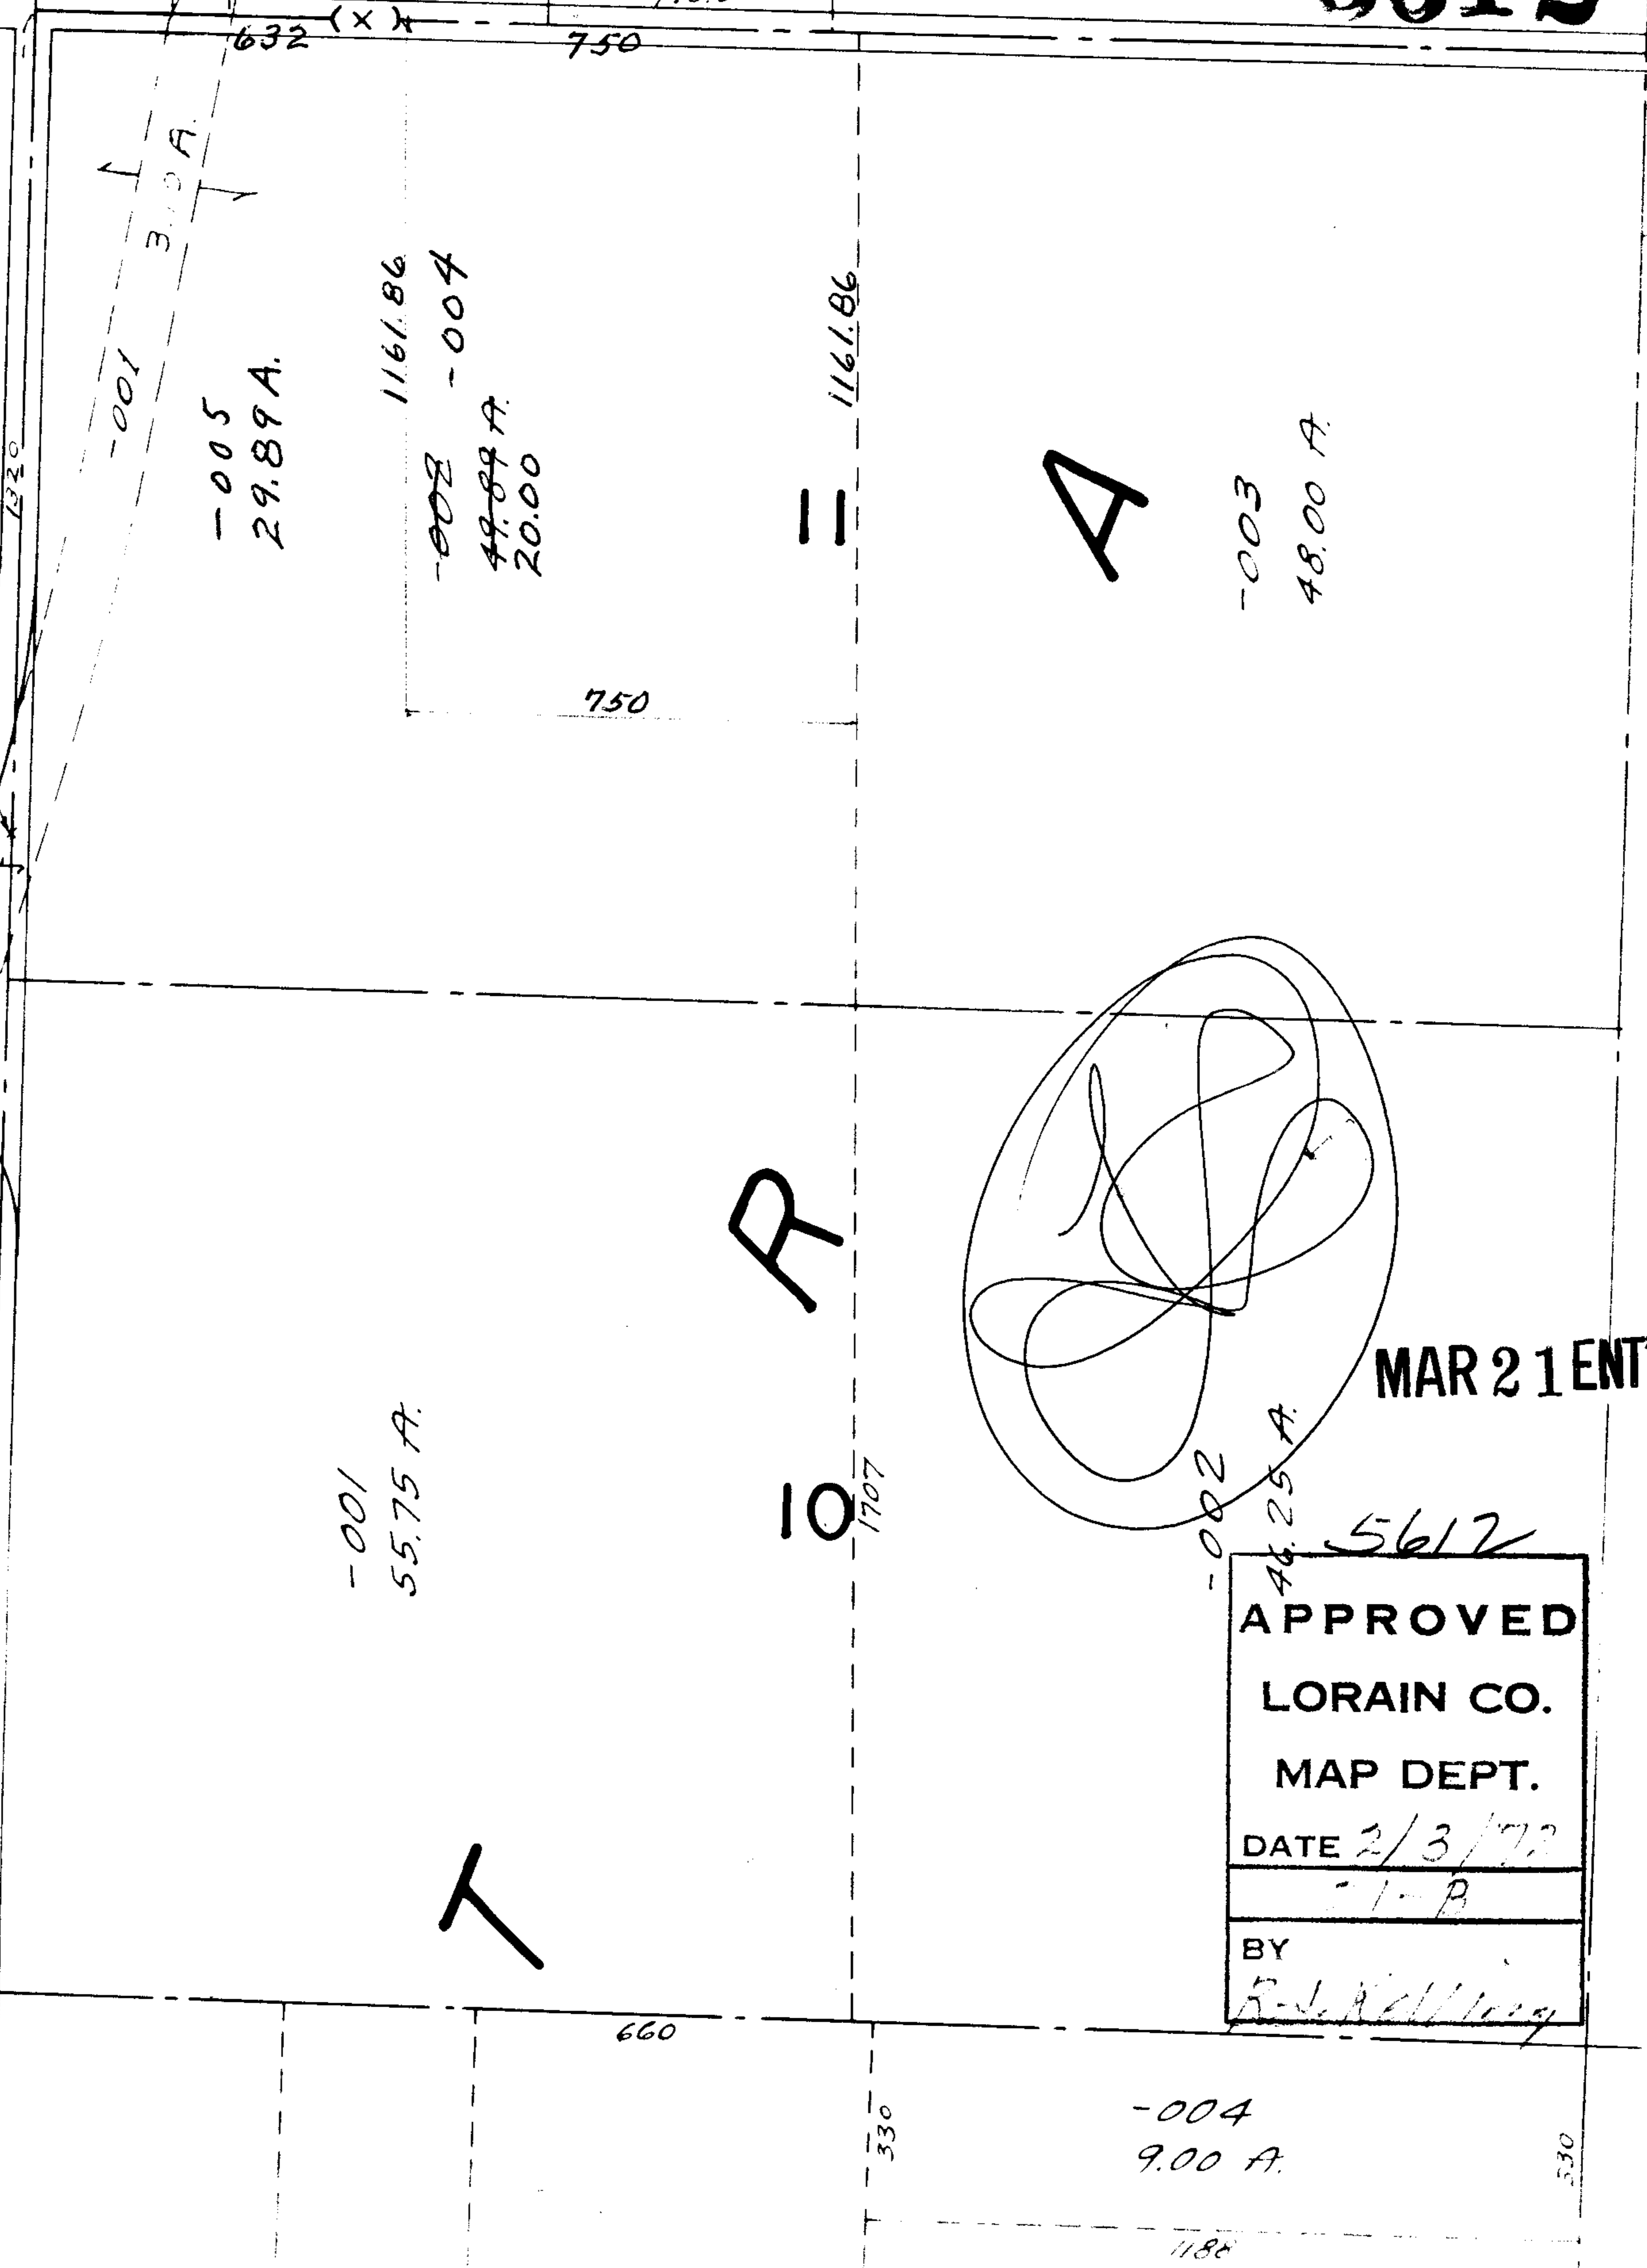

100 632 470.0 653.0

-001 300 A

-005 29.89 A.

1161.86
-002 49.89 A.
20.00

1161.86

A

-003 48.00 A.

750

R

IO 1707

-001 55.75 A.


T

660

330

-004 9.00 A.

530

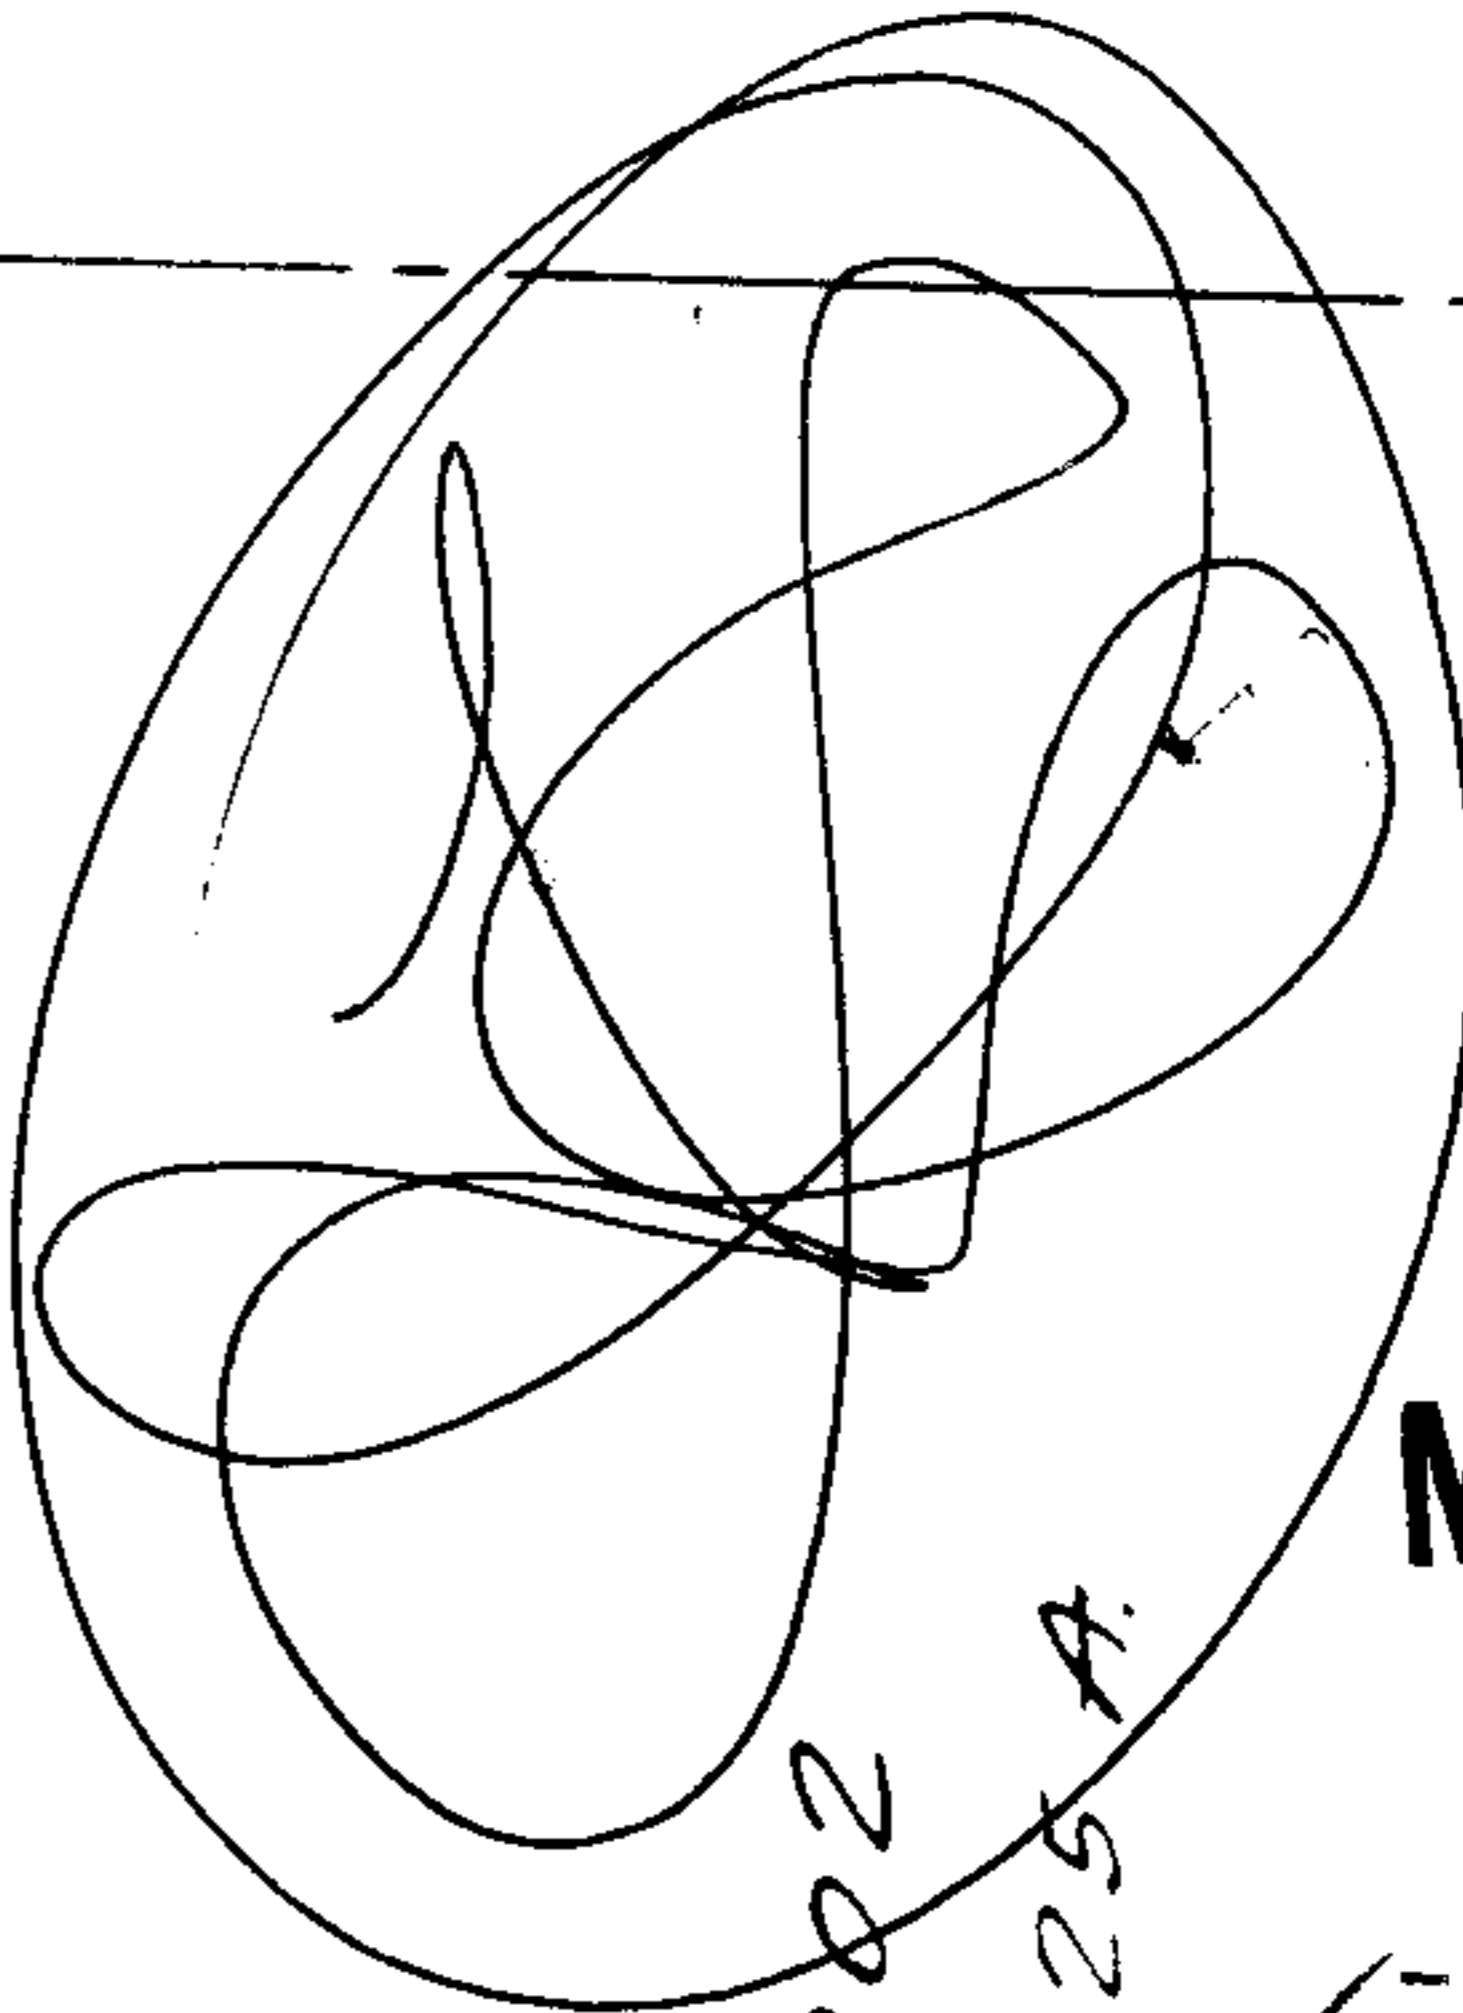

-002 46.25 A.

5612

MAR 21 ENT'D

APPROVED
LORAIN CO.
MAP DEPT.
DATE 2/3/72
BY R. J. Kelly

1180