



5614

SYCAMORE

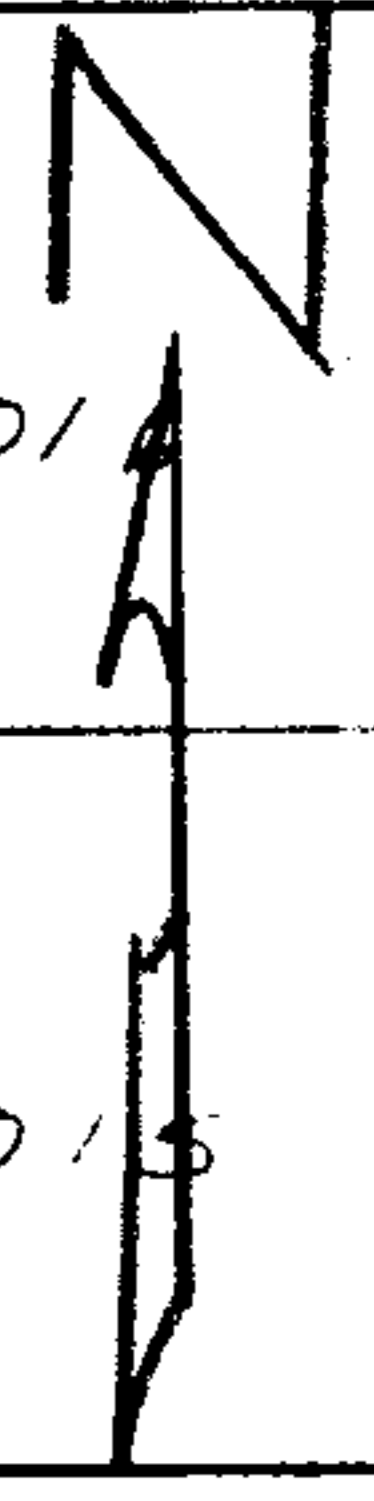

BEECH ST

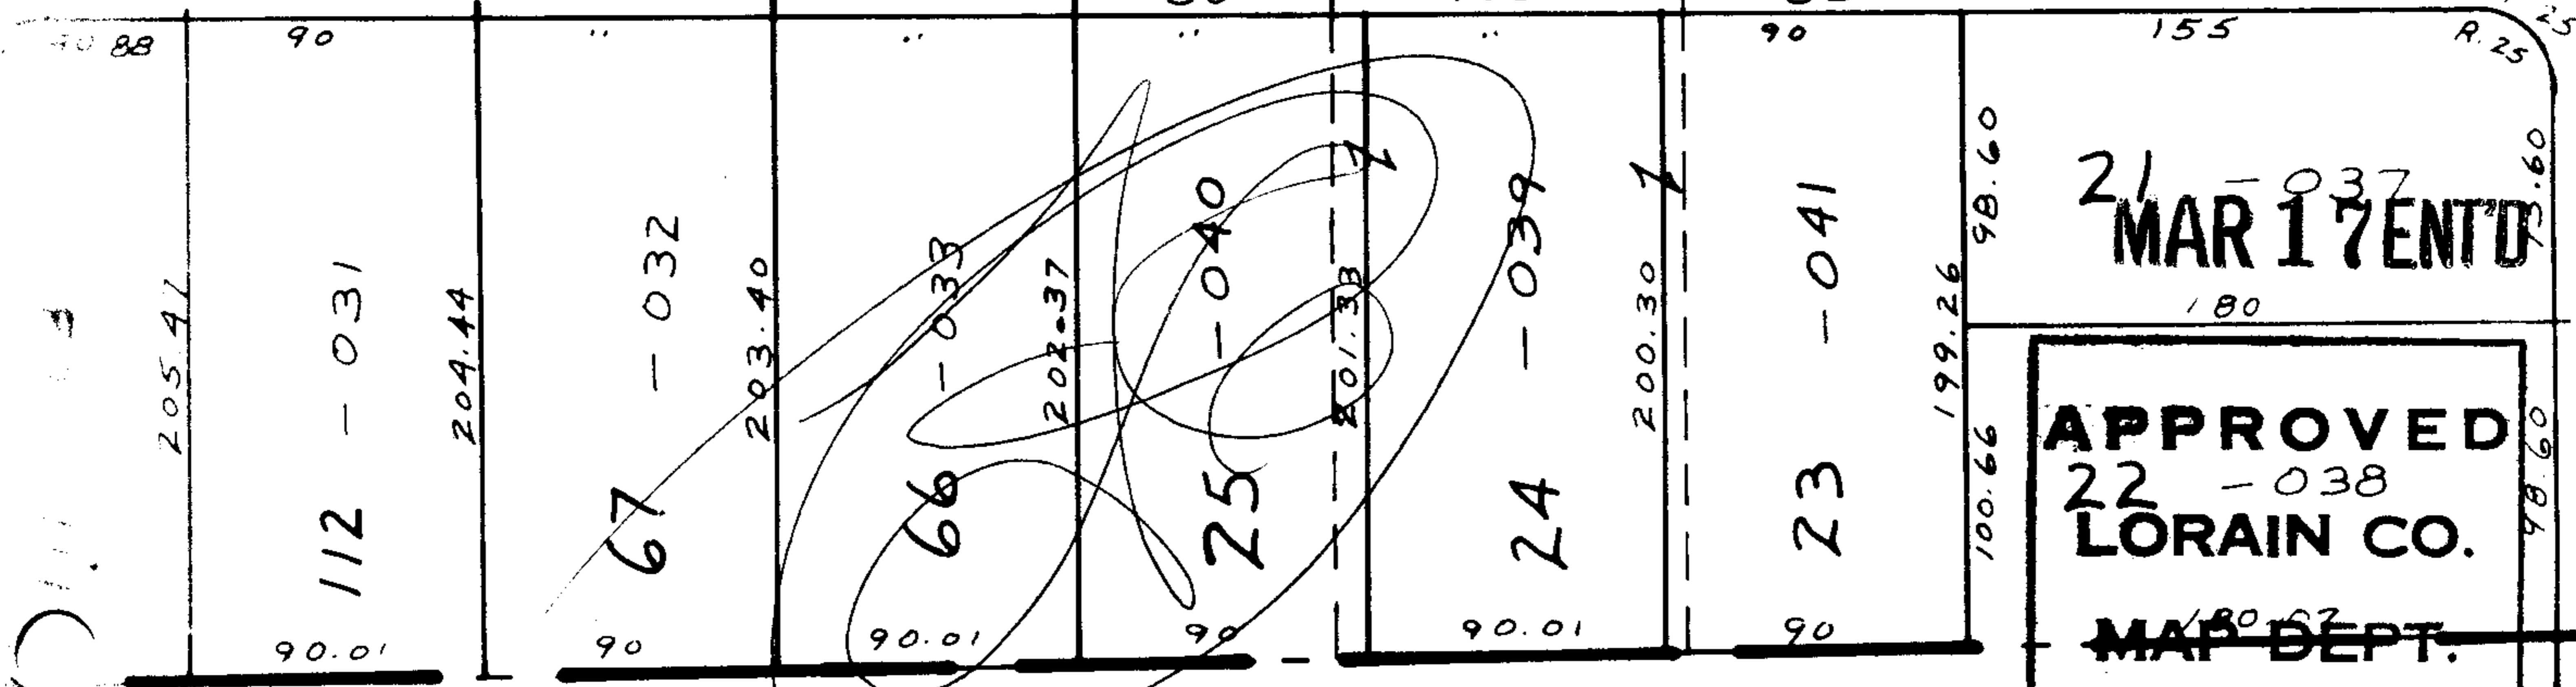

SEE 9-00-093-B

APPROVED
 22-038
LORAIN CO.
 MAP DEPT.
 DATE 2/3/72
 9-00-093-B
 BY *[Signature]*

[Handwritten notes]
 2-8
 7-23-88

AMHERST
 SOUTH
 PYLLE