
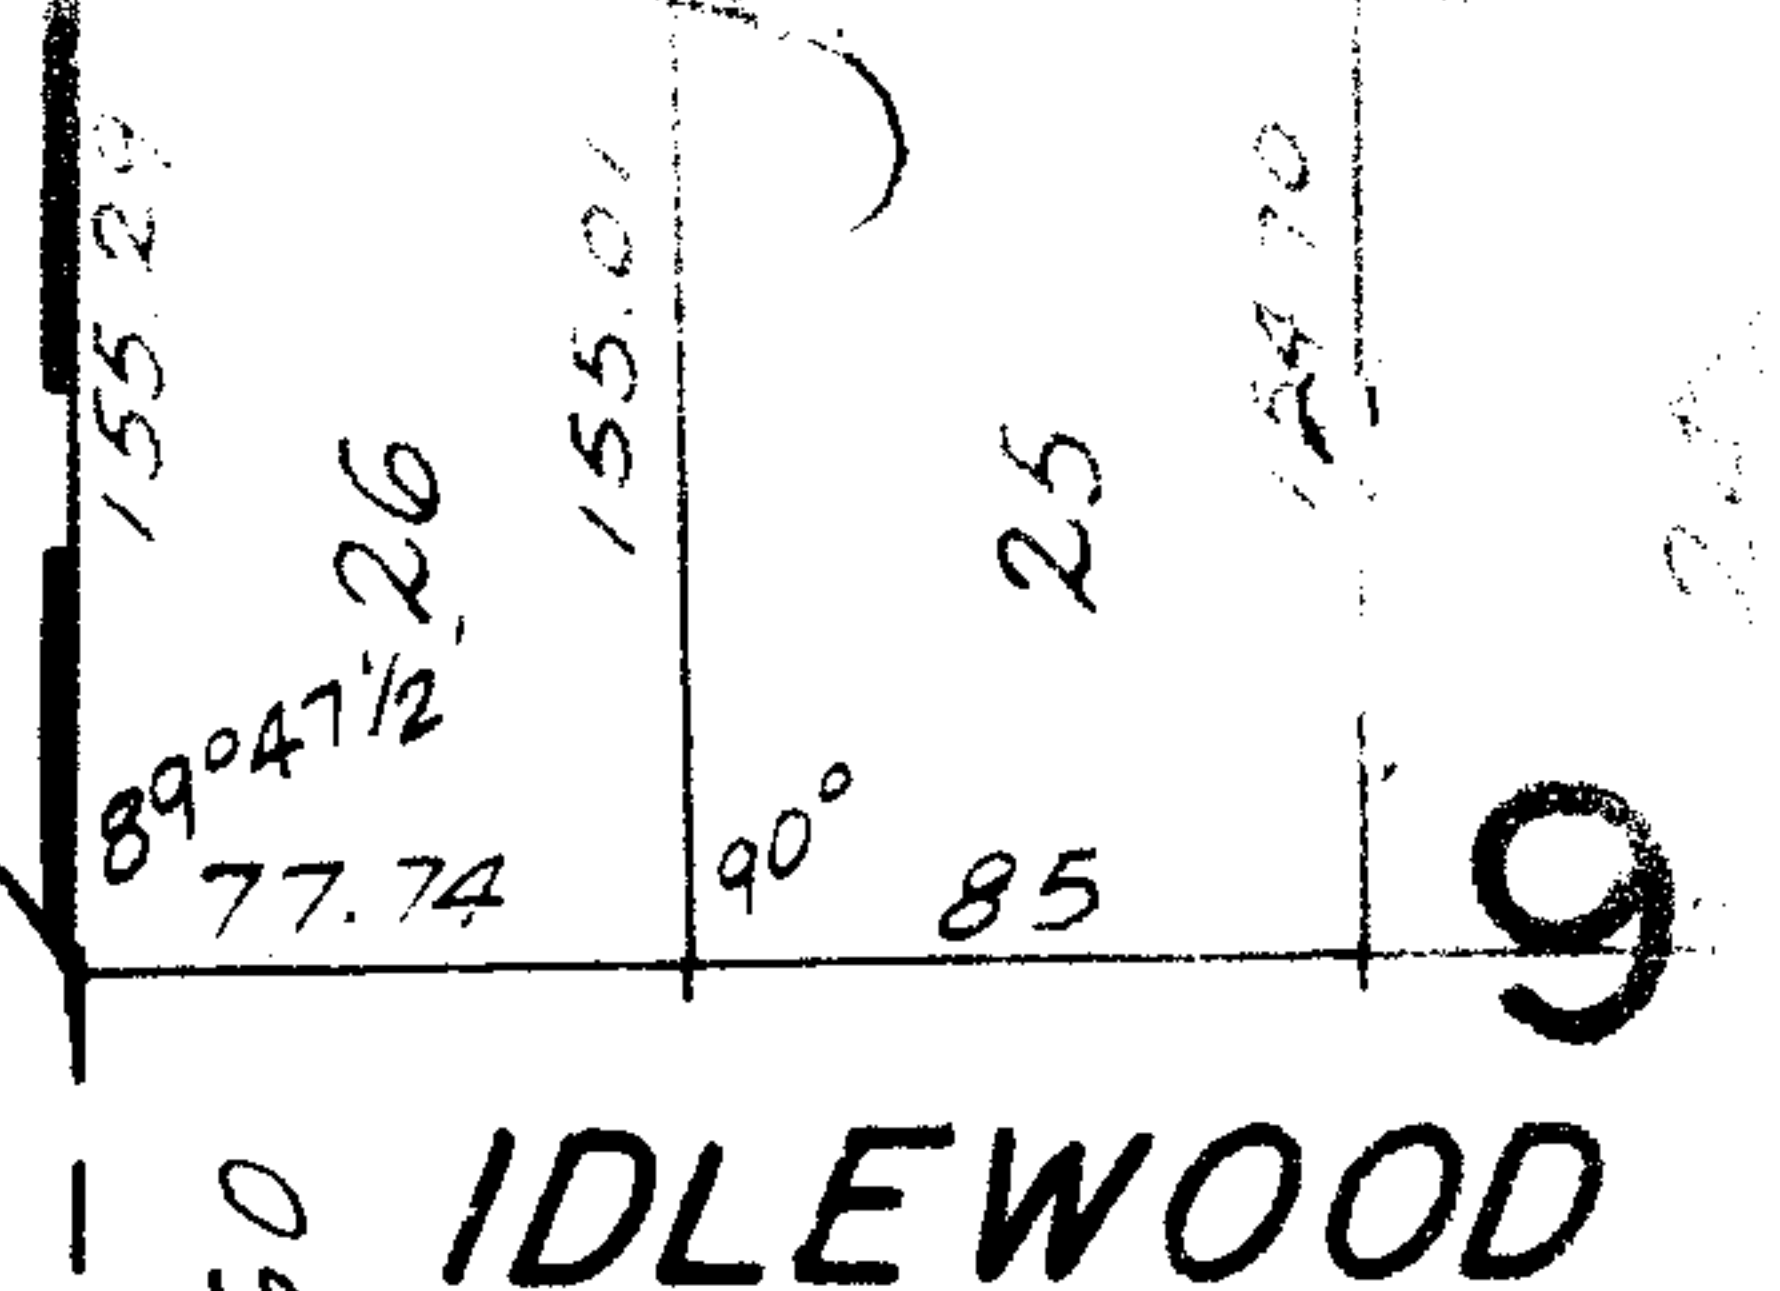


MAR 3 1960

-025  
6.59 A.


# INTERSTATE

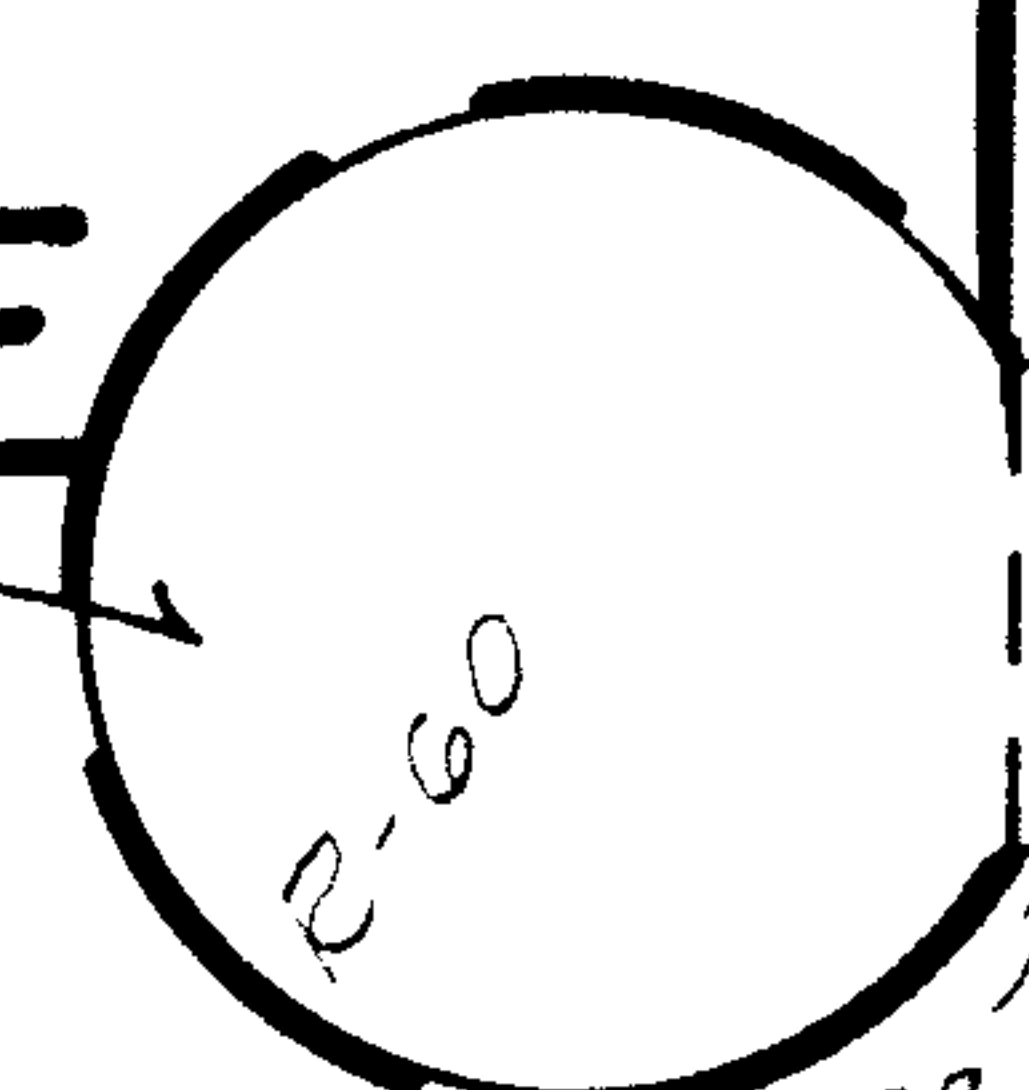

IDLEWOOD



9

5666
APPROVED
LORAIN CO.
MAP DEPT.
DATE 2-29-72
6-24
BY LWH/HL

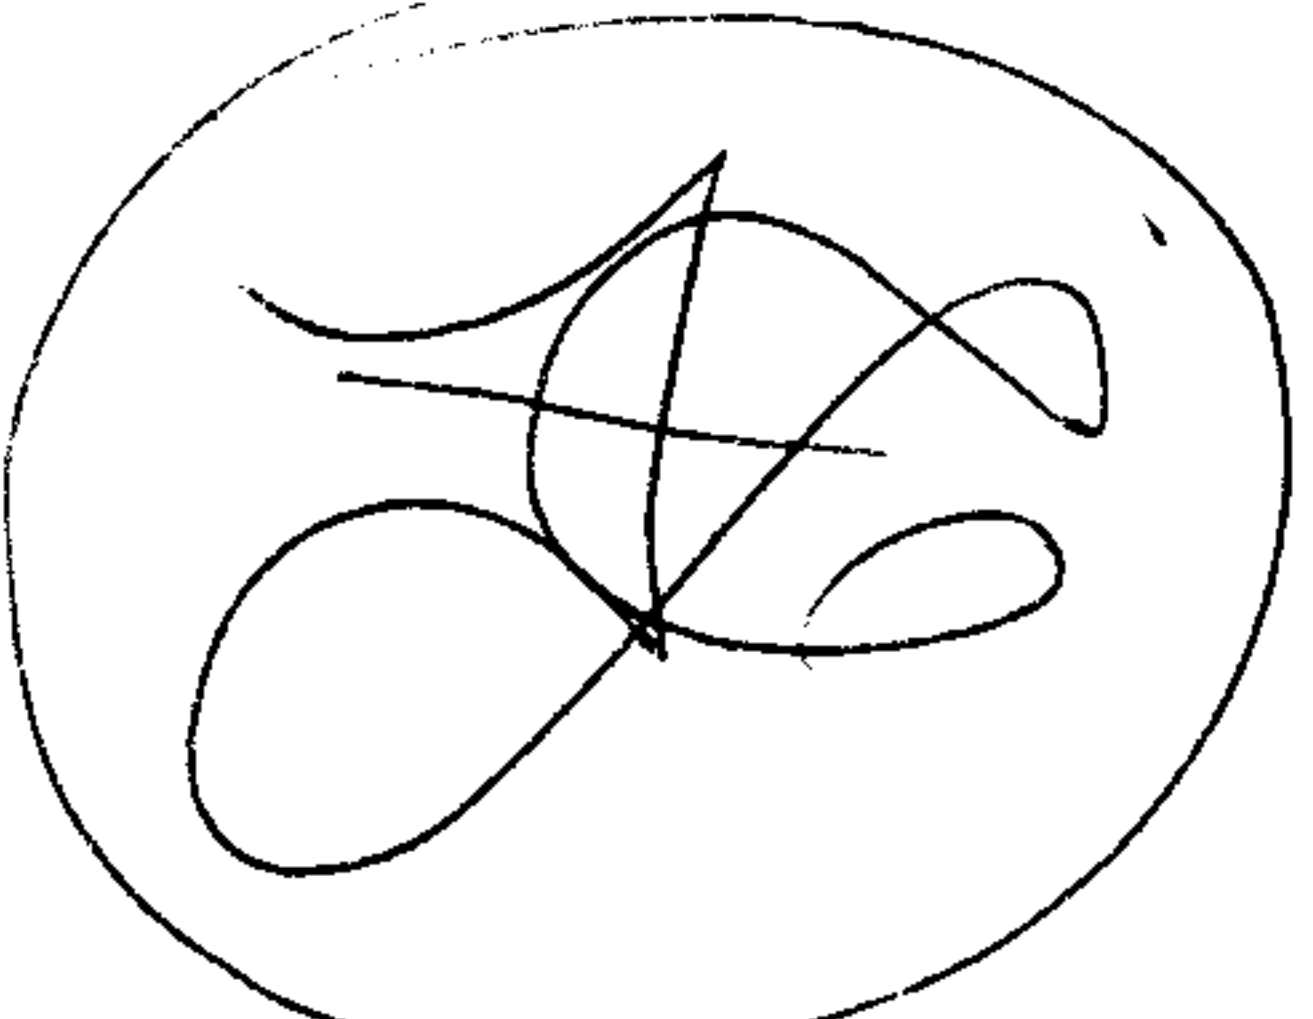

403.24

56.24  
41

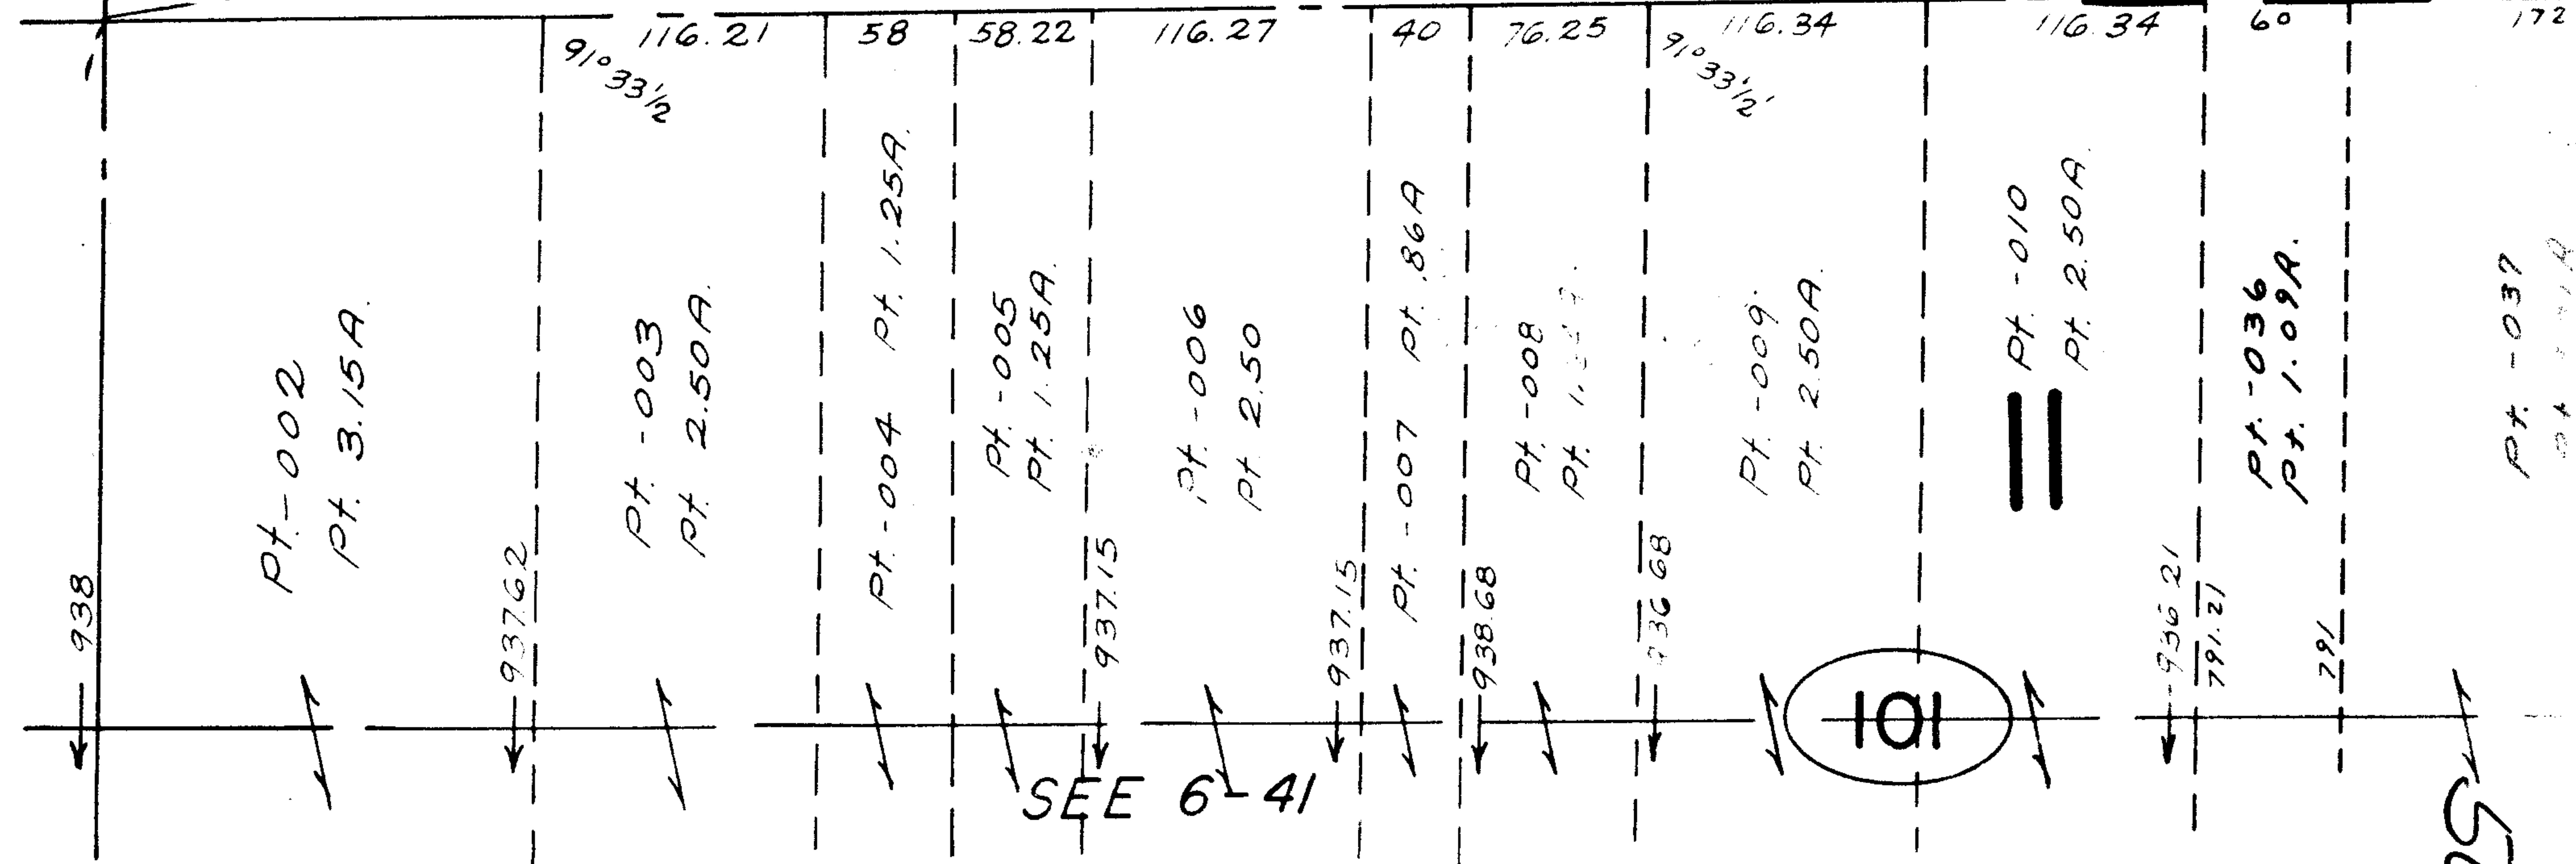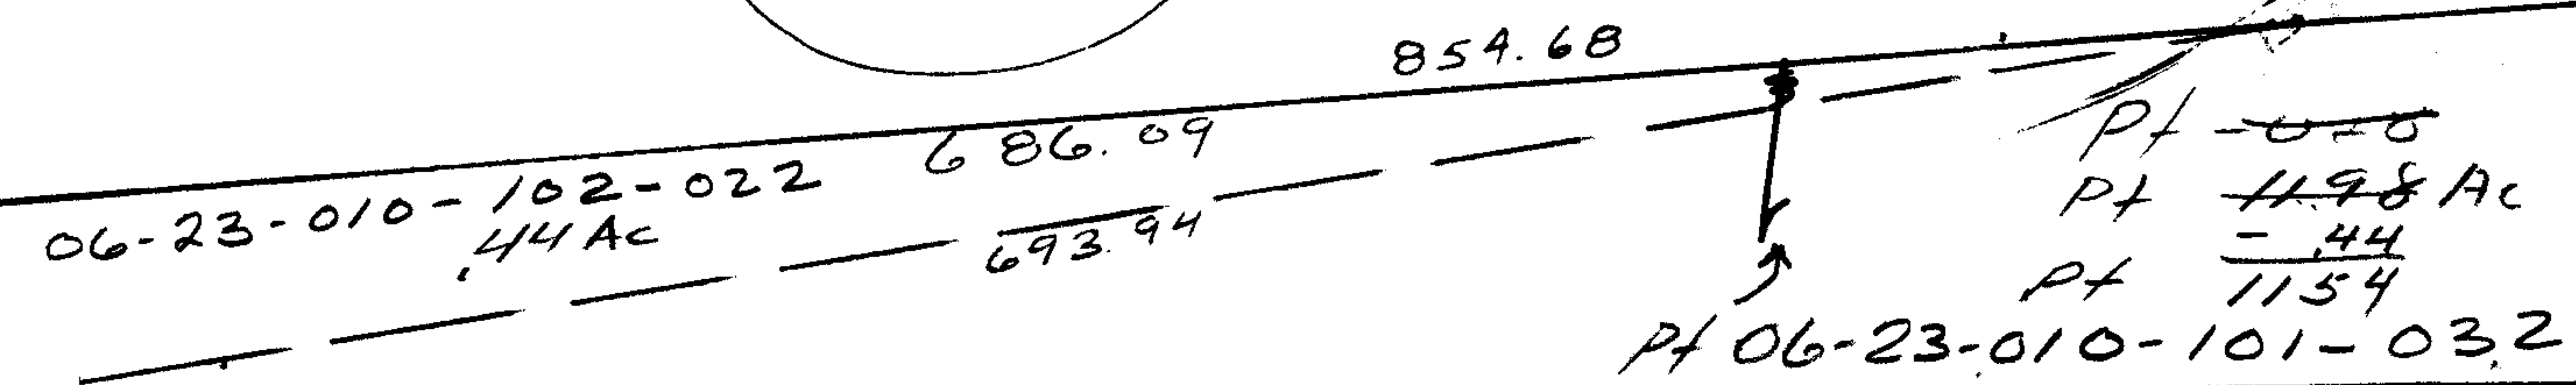

6-24  
9795

Pt. -037  
Pt. -01A