



5667

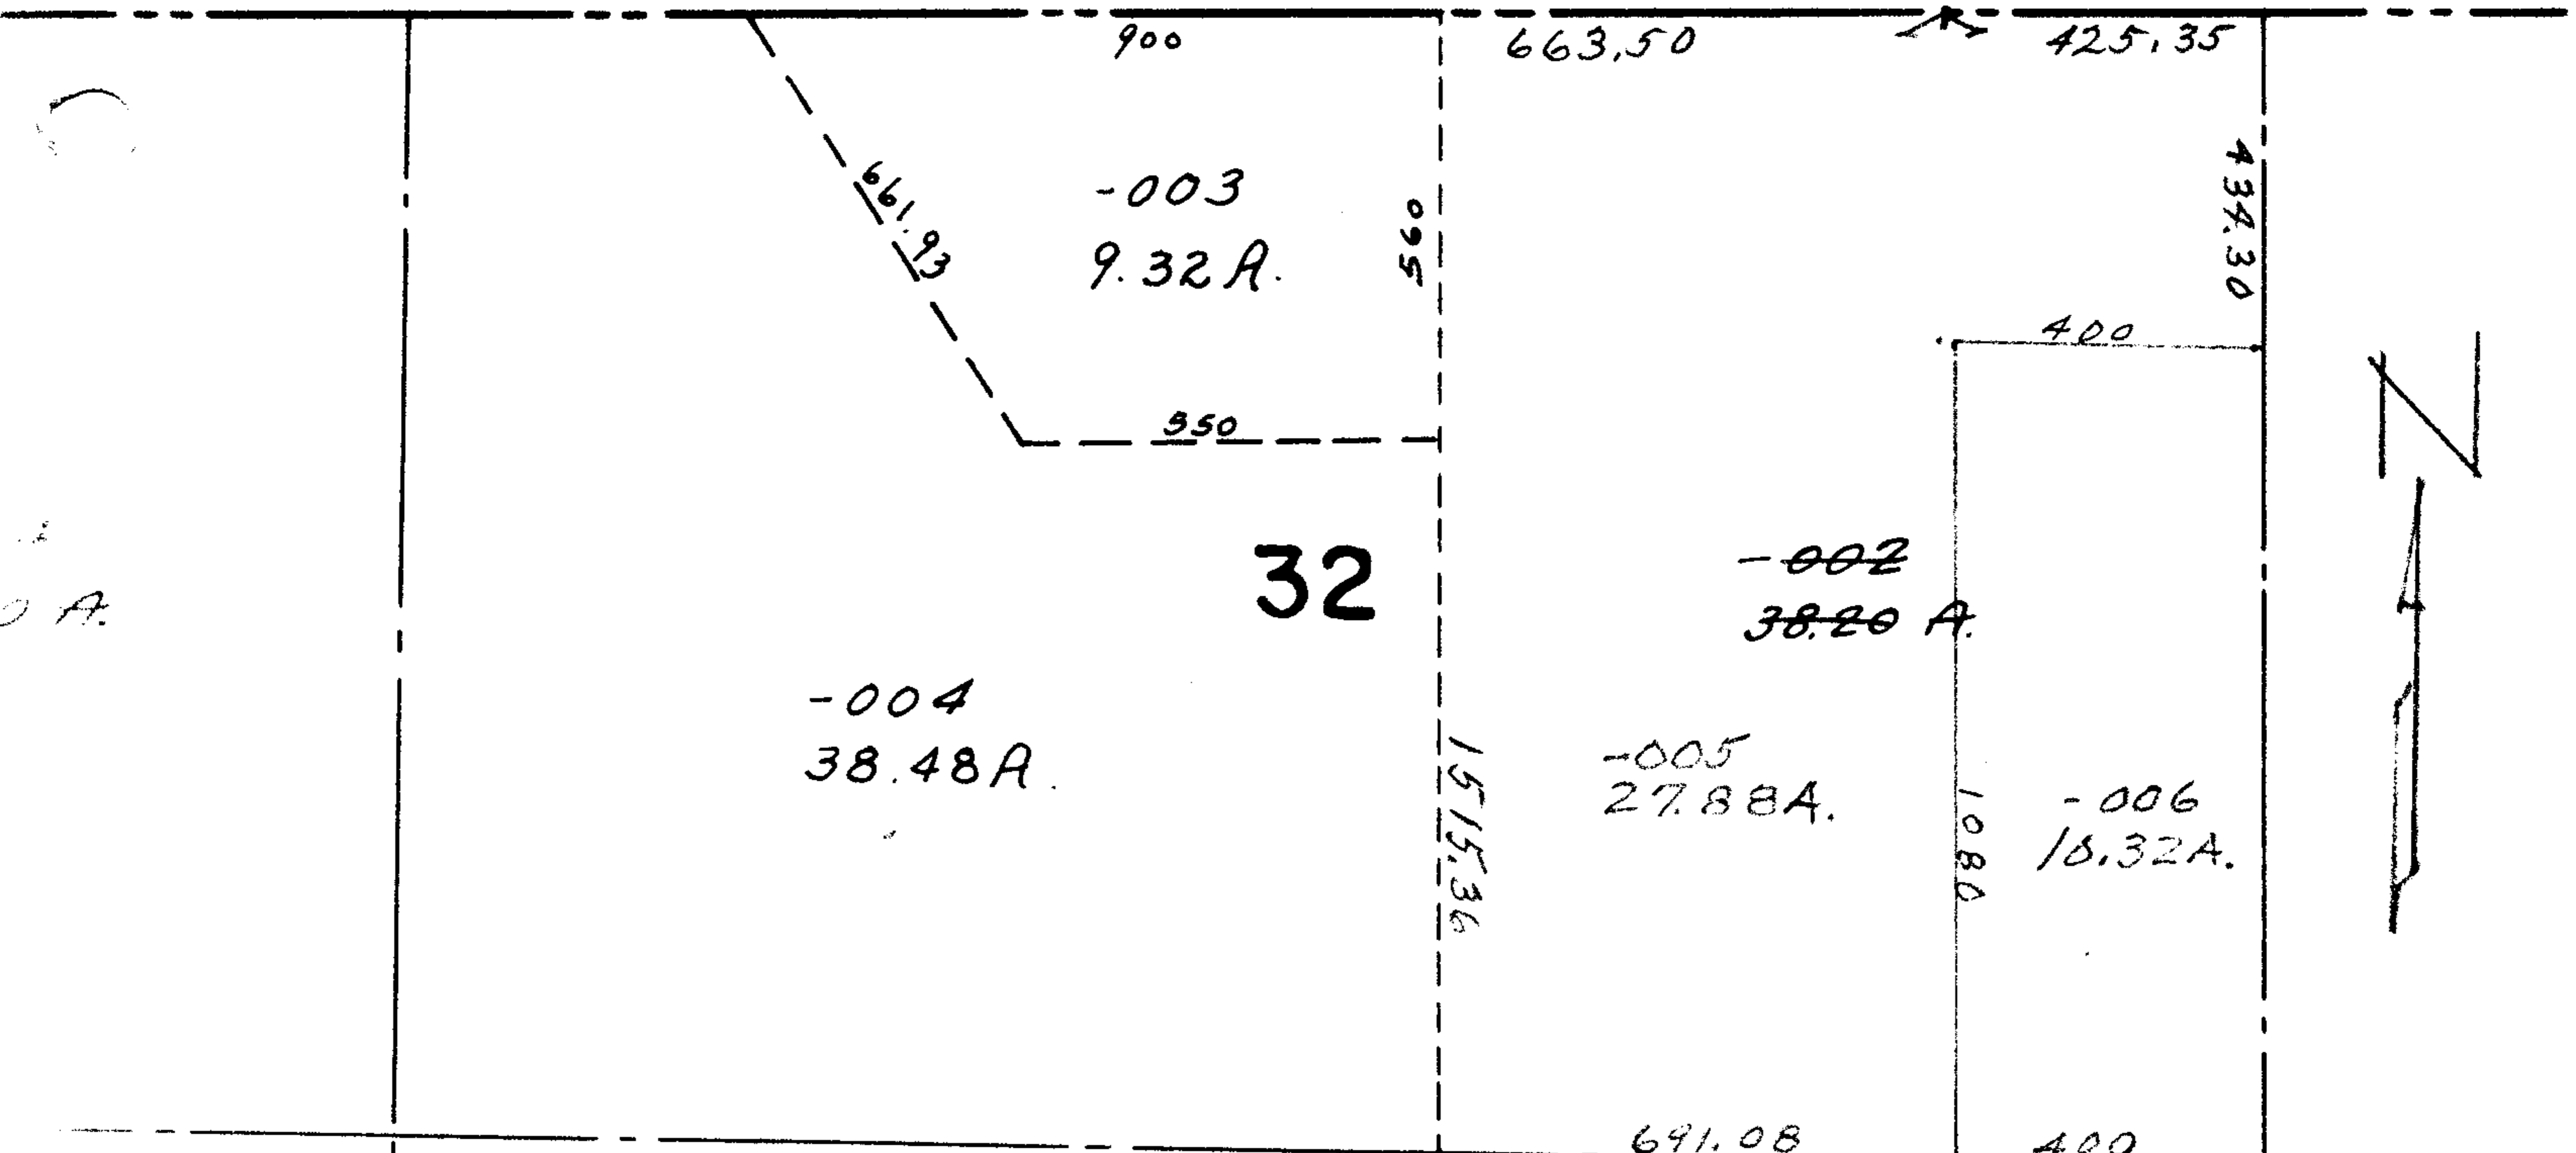


32

APR 3 1972

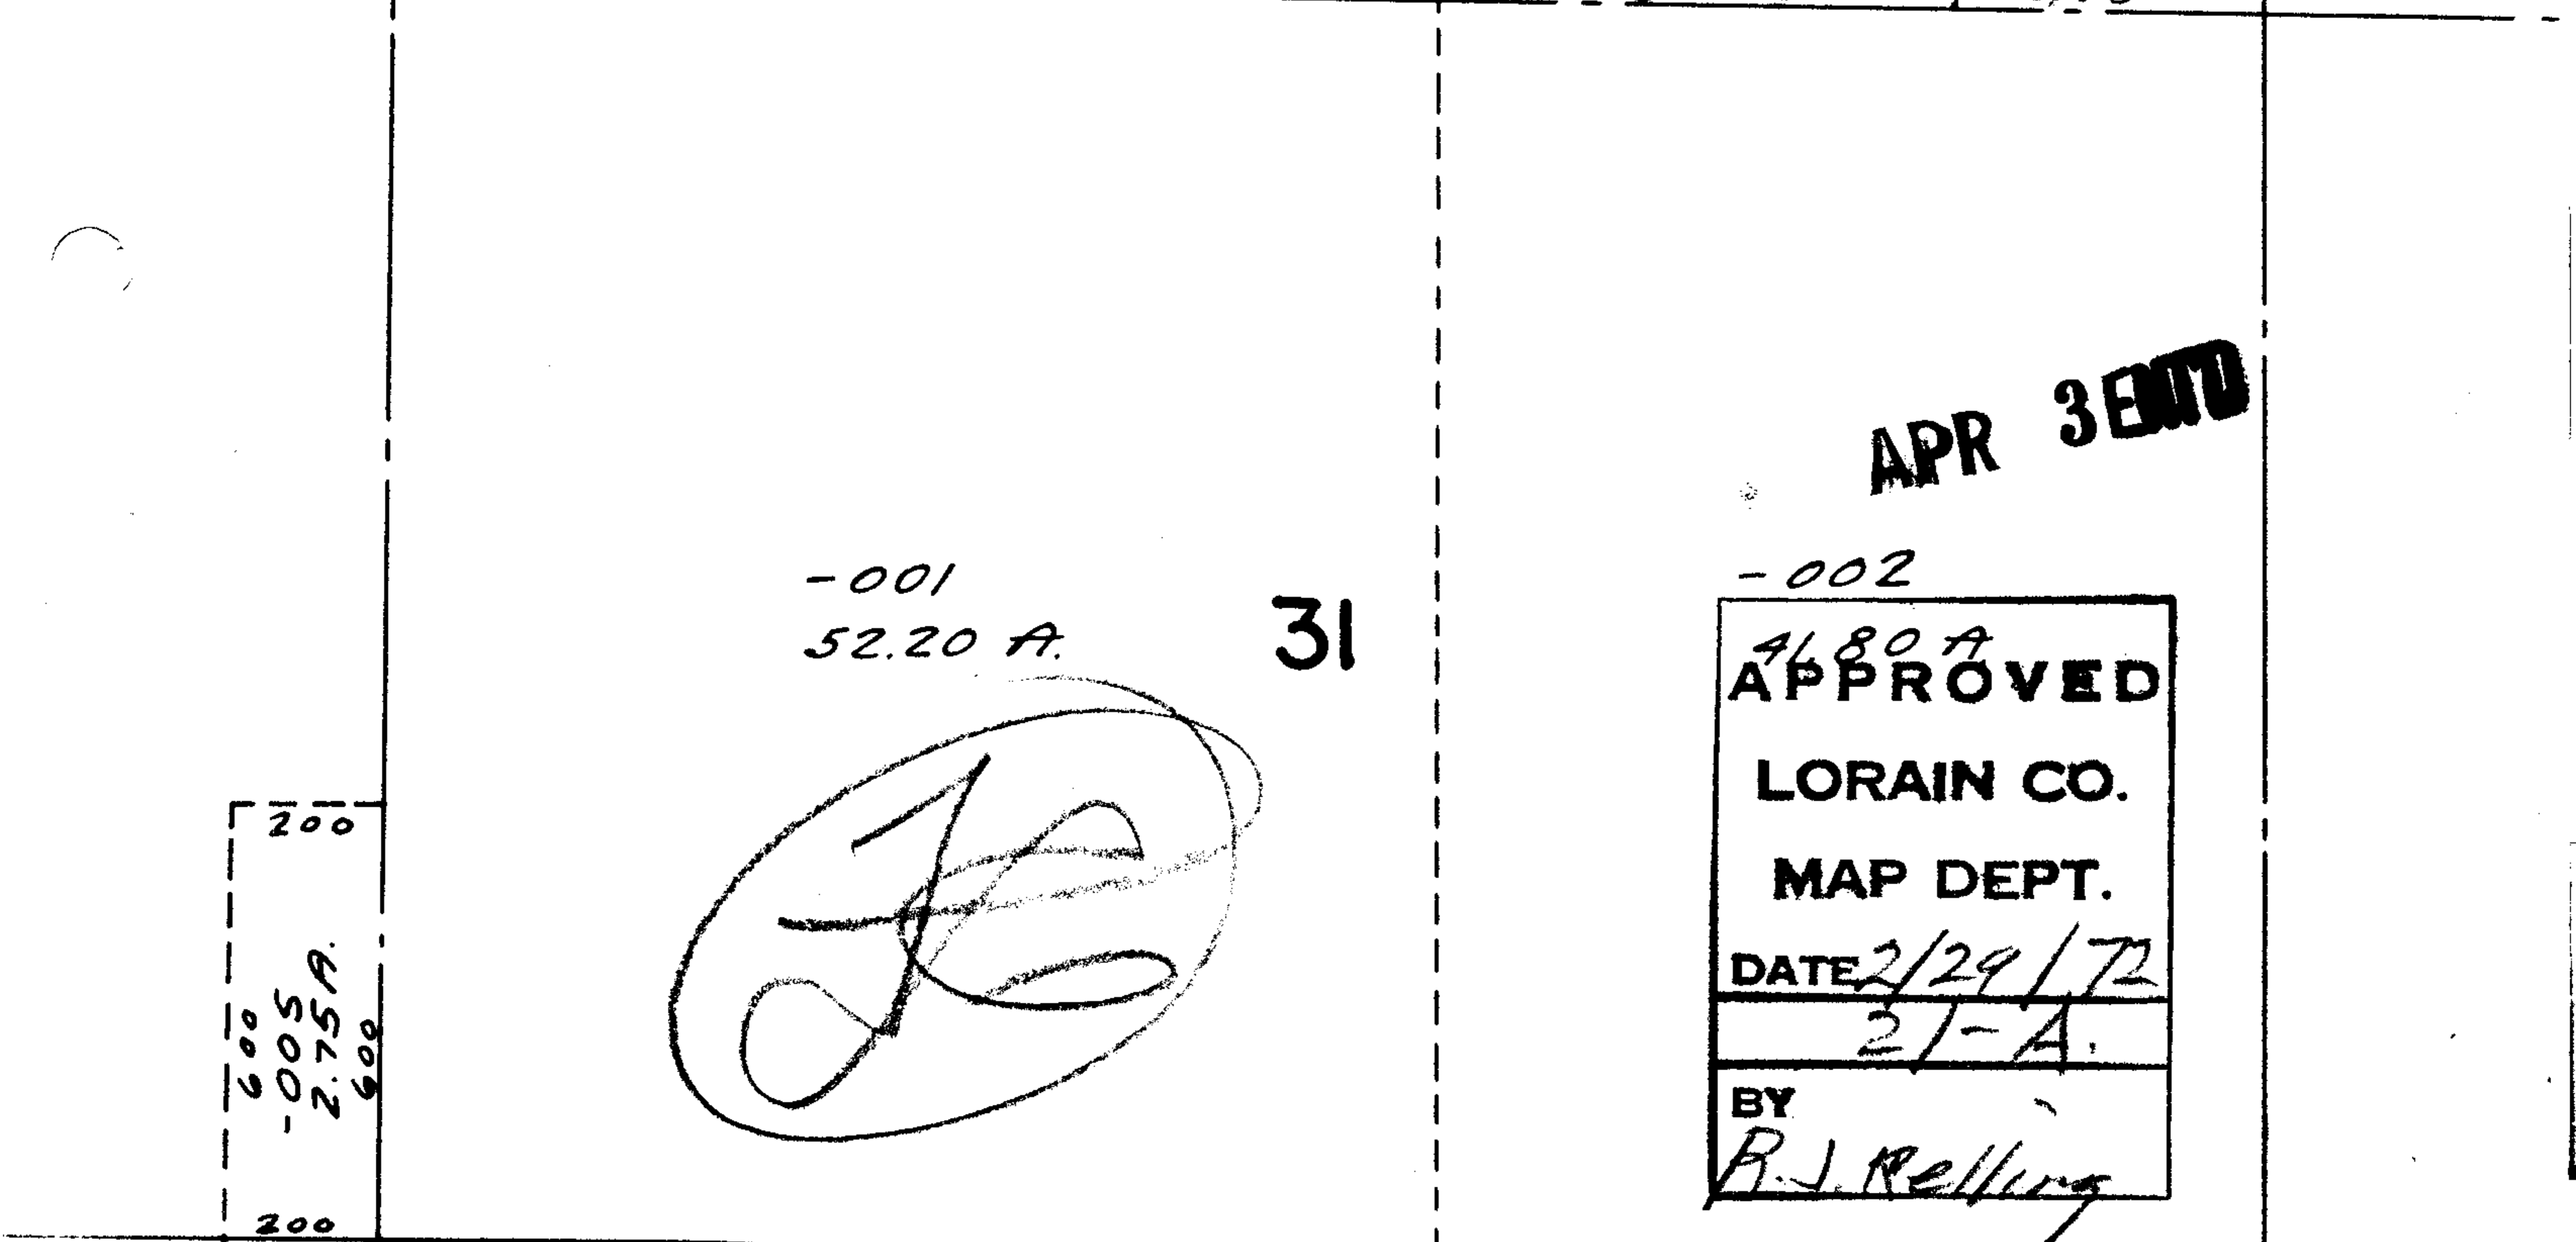

31

APPROVED  
 LORAIN CO.  
 MAP DEPT.  
 DATE 2/29/72  
 21-A.  
 BY  
 R. J. Relling

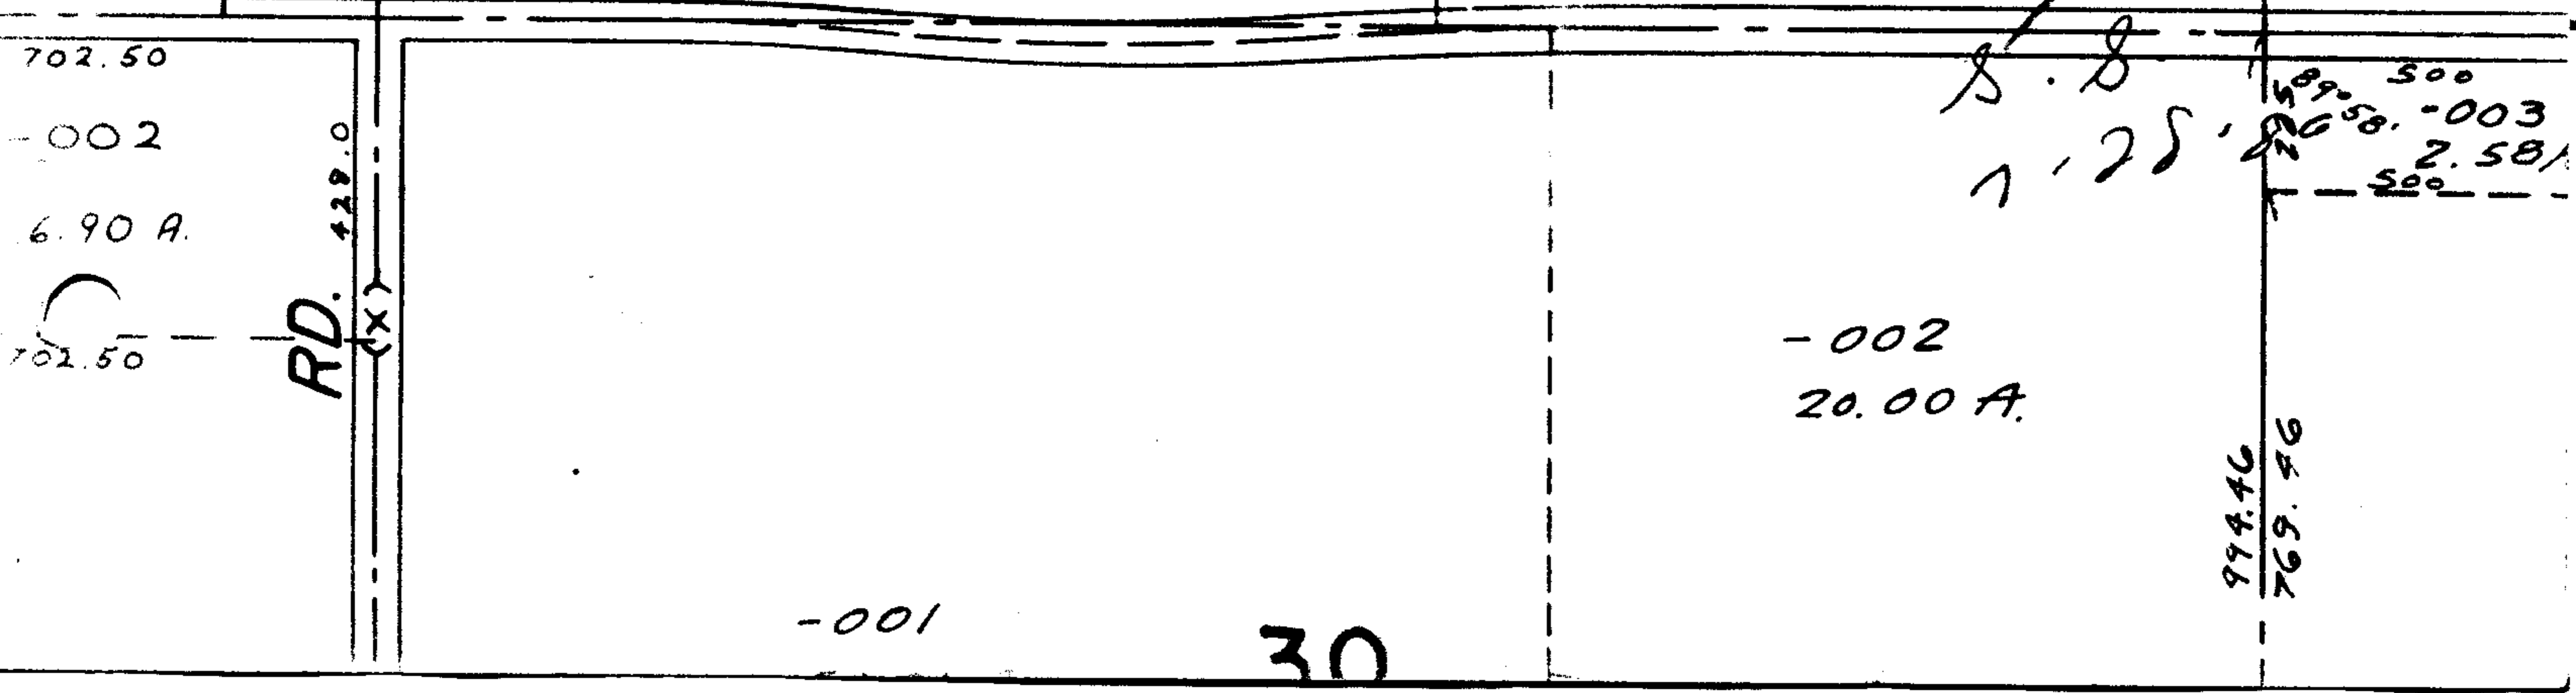

30