


5676

0523
14.89 AC
15.96 AC
14.89 AC

5676
APPROVED
LORAIN CO.
MAP DEPT.
DATE 3-2-72
5-00-063A
BY L W Hall

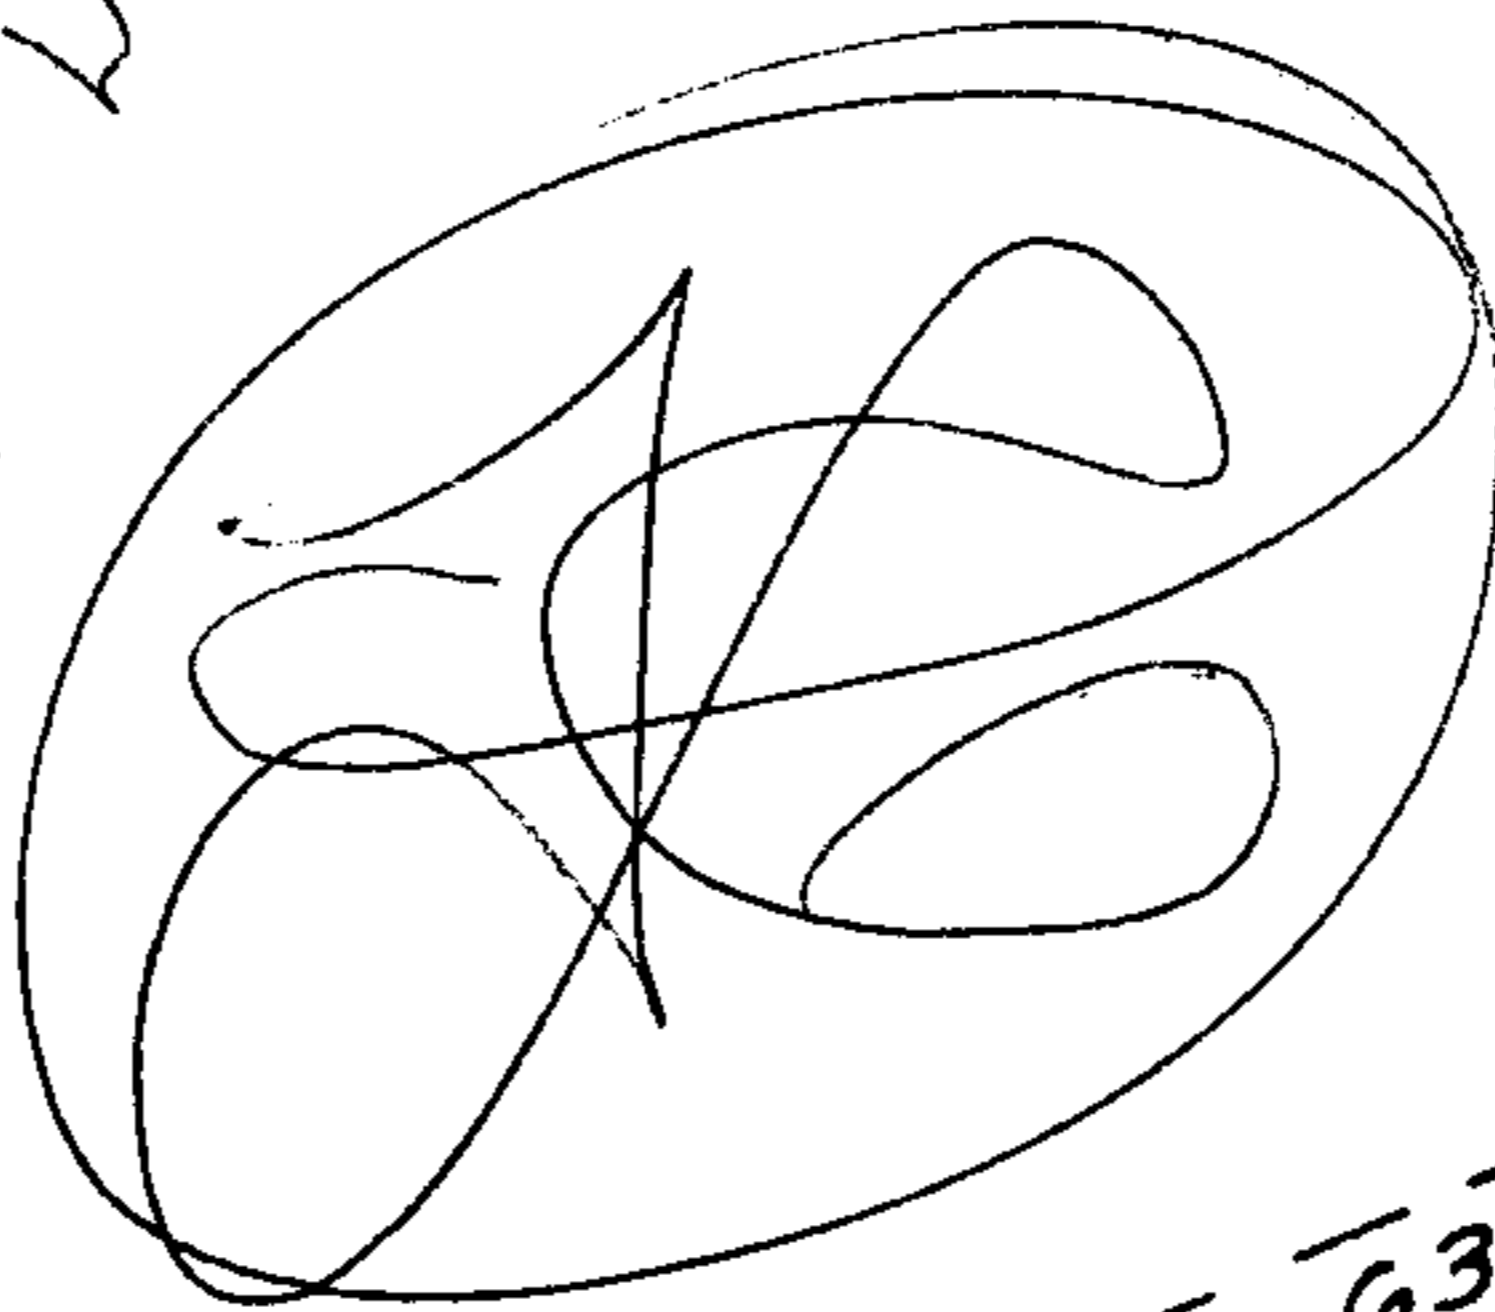

645 90

MAR 3 0 ENT'D

265
120
145

005
005

DGE

Scaled
145

100

105

120

100

90

120

110

230.75
100
S. 44° 30' 30" W.

5-00-063A

7-18-86

L.W.

N. 17° 20' 30" E
370.14
137.32

11-015

133.86

10-016

196.52

127.63

31.88

131.61

9-017

247.70

39.32

57.72

120

195.51

87.76

ARLINGTON

R-309.12

214.55

-007
1.31 F.

8-018

115.19

12

052
1.07 AC

449.38
390.00

150.49

104.99

250

390

168.90

7-019

155

1-031

506.51 N. 50° 59' 30" W.
205.95

155

83.64

60

104.99

1-031

50.73

.73

30