

5686

SEE MAP  
CORRECTION  
4-23-74

863.71 HAWLEY

44  
 236  
 -002  
 1.13A.  
 257.53  
 236.44  
 -003  
 .46A.  
 -004  
 .46A.  
 200


573.71  
 / 150  
 423.71

300  
 -015  
 1.03A  
 300  
 -019  
 1.03A  
 300

-024  
 / 137.39A  
 136.36AC

APR 3 1972

5686  
 APPROVED  
 LORAIN CO.  
 MAP DEPT.  
 DATE 3-2-72  
 18D  
 BY LWHall

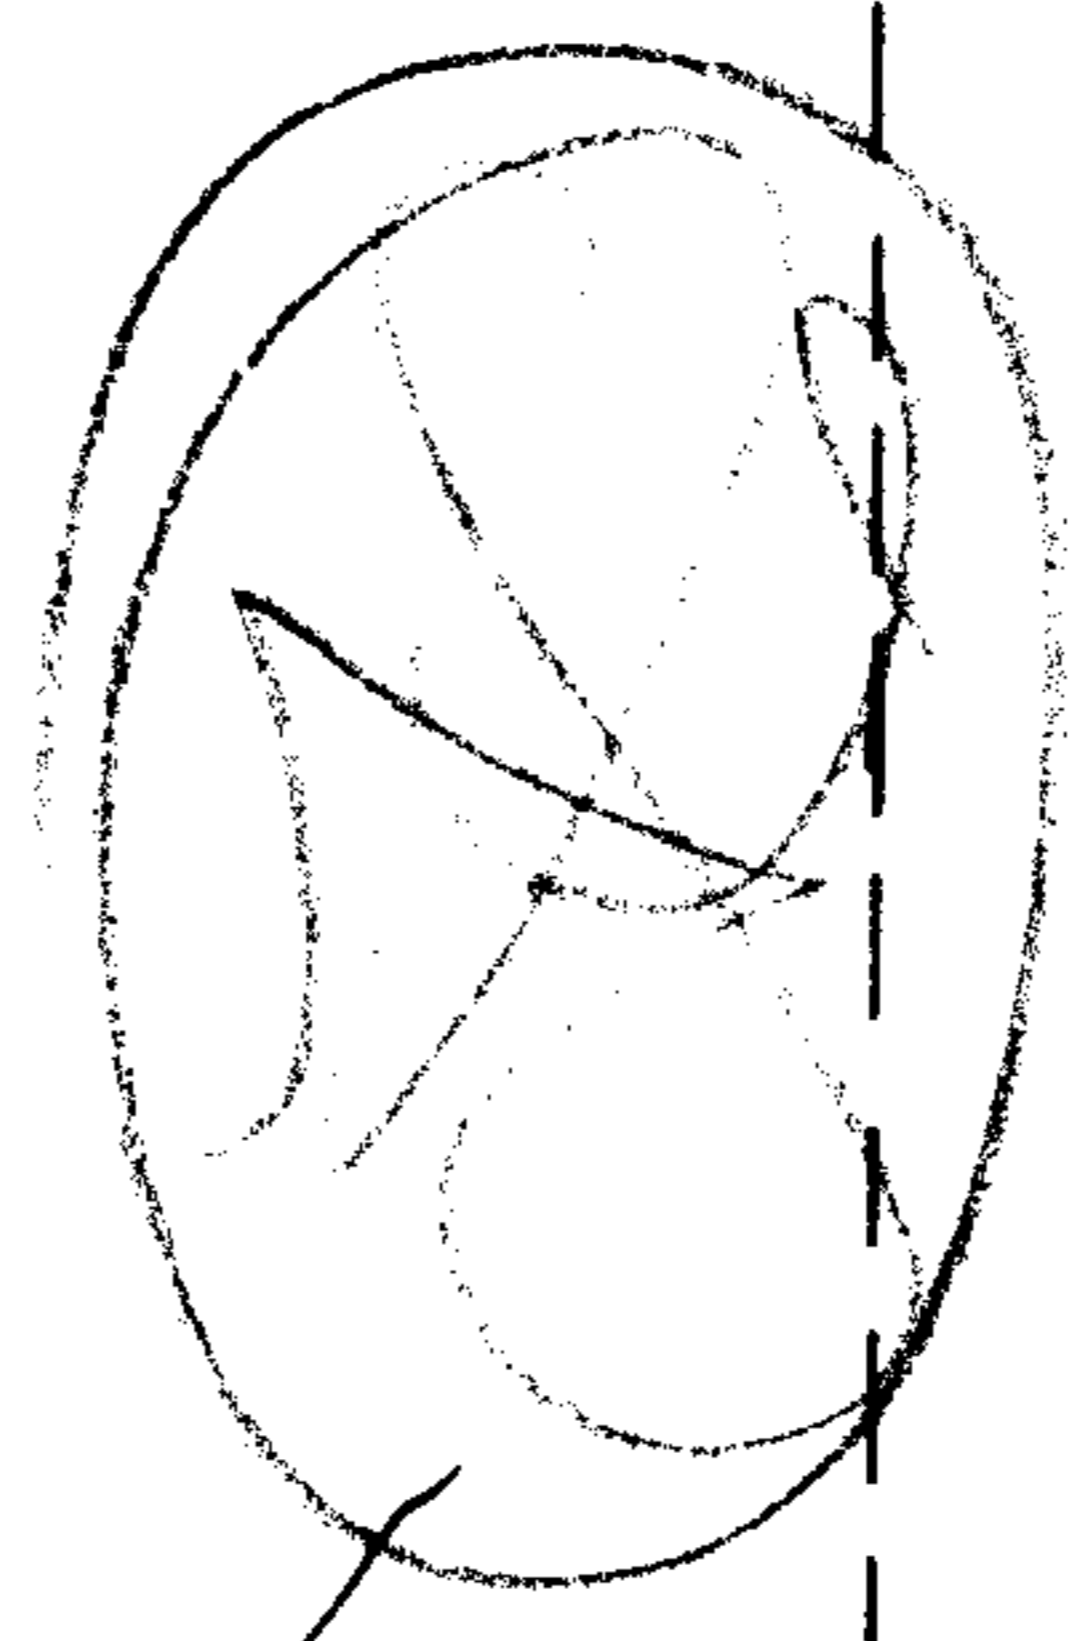

S.S.  
 2-8-86

022  
 72.97A

300  
 1.03AC  
 -023  
 150

217.90  
 200  
 -009  
 1.00A  
 217.90  
 MEDINA

220  
 -006  
 .50A  
 99  
 300  
 -021  
 1.03A  
 300  
 NORWALK

290.40  
 -017  
 1.00A  
 290.40  
 358



358

358

121676

1011