


A. B SUB. P. A.
697 V. 16 - 020
312.74
100 100
40 30 60 60

5687

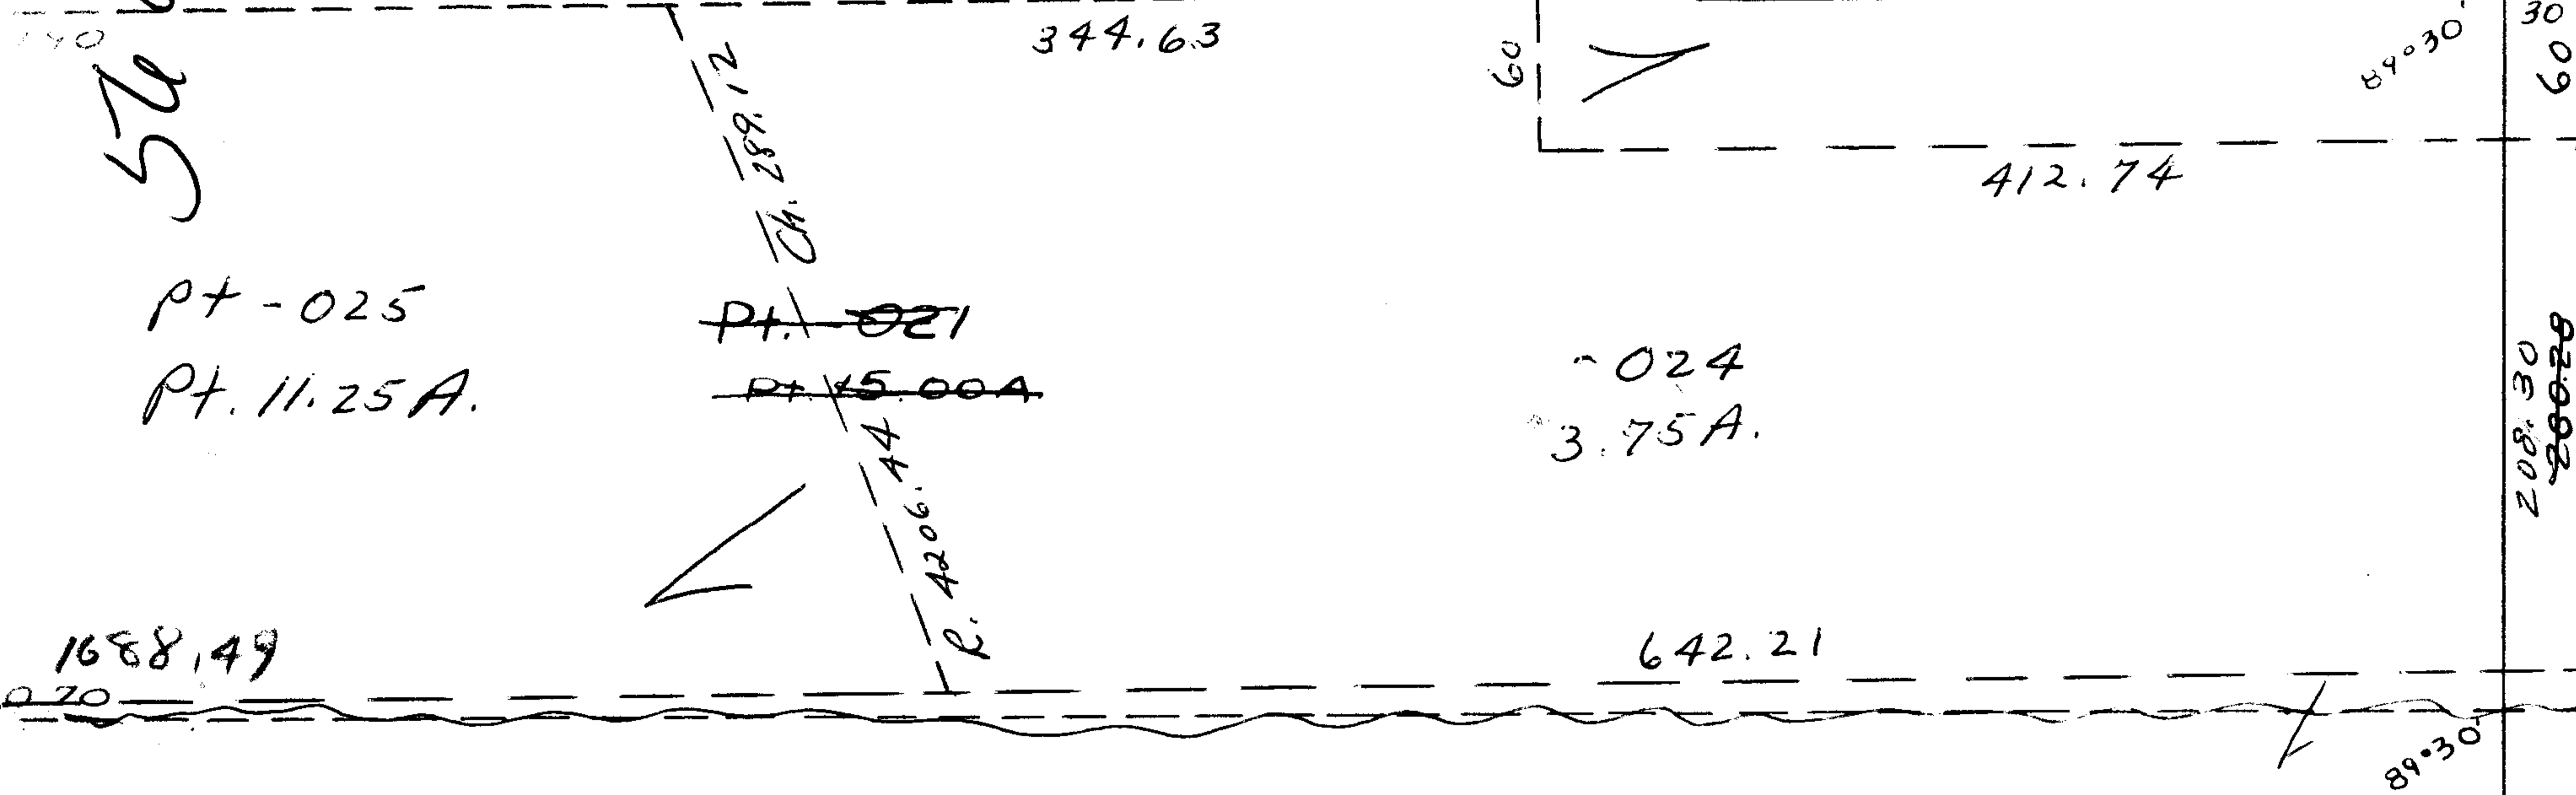

PT-025
PT. 11.25A.

~~PT. 021~~
~~PT. 15.00A~~

- 024
3.75A.


1688.49

PT. - 022
PT. 17.50A.

2300.70
642.21
1688.49

5687

APPROVED
LORAIN CO.
MAP DEPT.
DATE 3-3-72
4-00-017-ETF
BY [Signature]

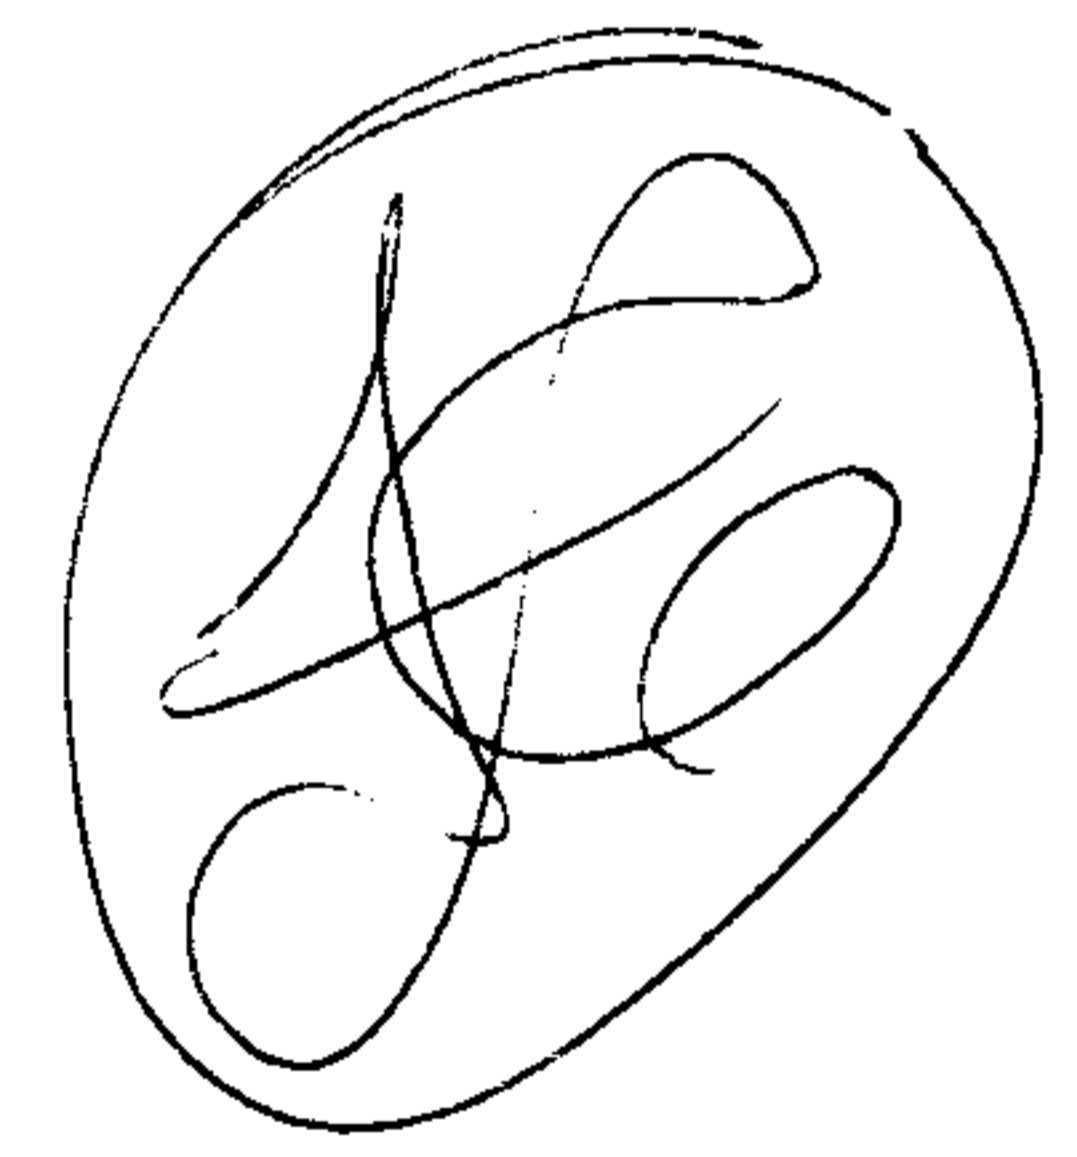

MAR 29 ENT'D

WOOSTER - AVON LAKE

PT - 023