

-004
43.92A

-005
20.00A

430
-007
1.97A
430

-008
~~55.00A~~
53.03

C

1247.55

A


R 32

-002
58.5A

T

1796.5

-003
36.70A

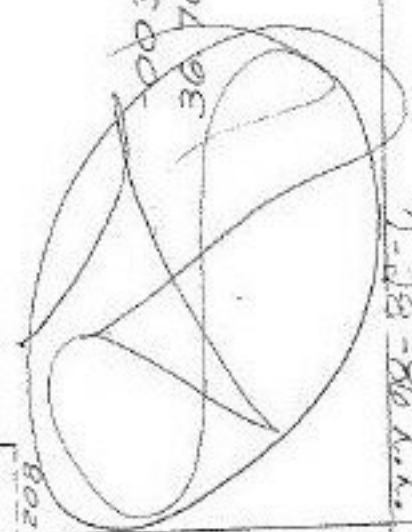

APR 6 1972

-00
75.00A

APPROVED
LORAIN CO.
MAP DEPT.
DATE 3/16/72
17-C
BY
R. J. Kelling

1791.35

1478.6

PECK - WADSWORTH

(60)

208
1004
1004
208

7-28-86
K.L.

308
-208 1004
308

5723