


5727



Delete

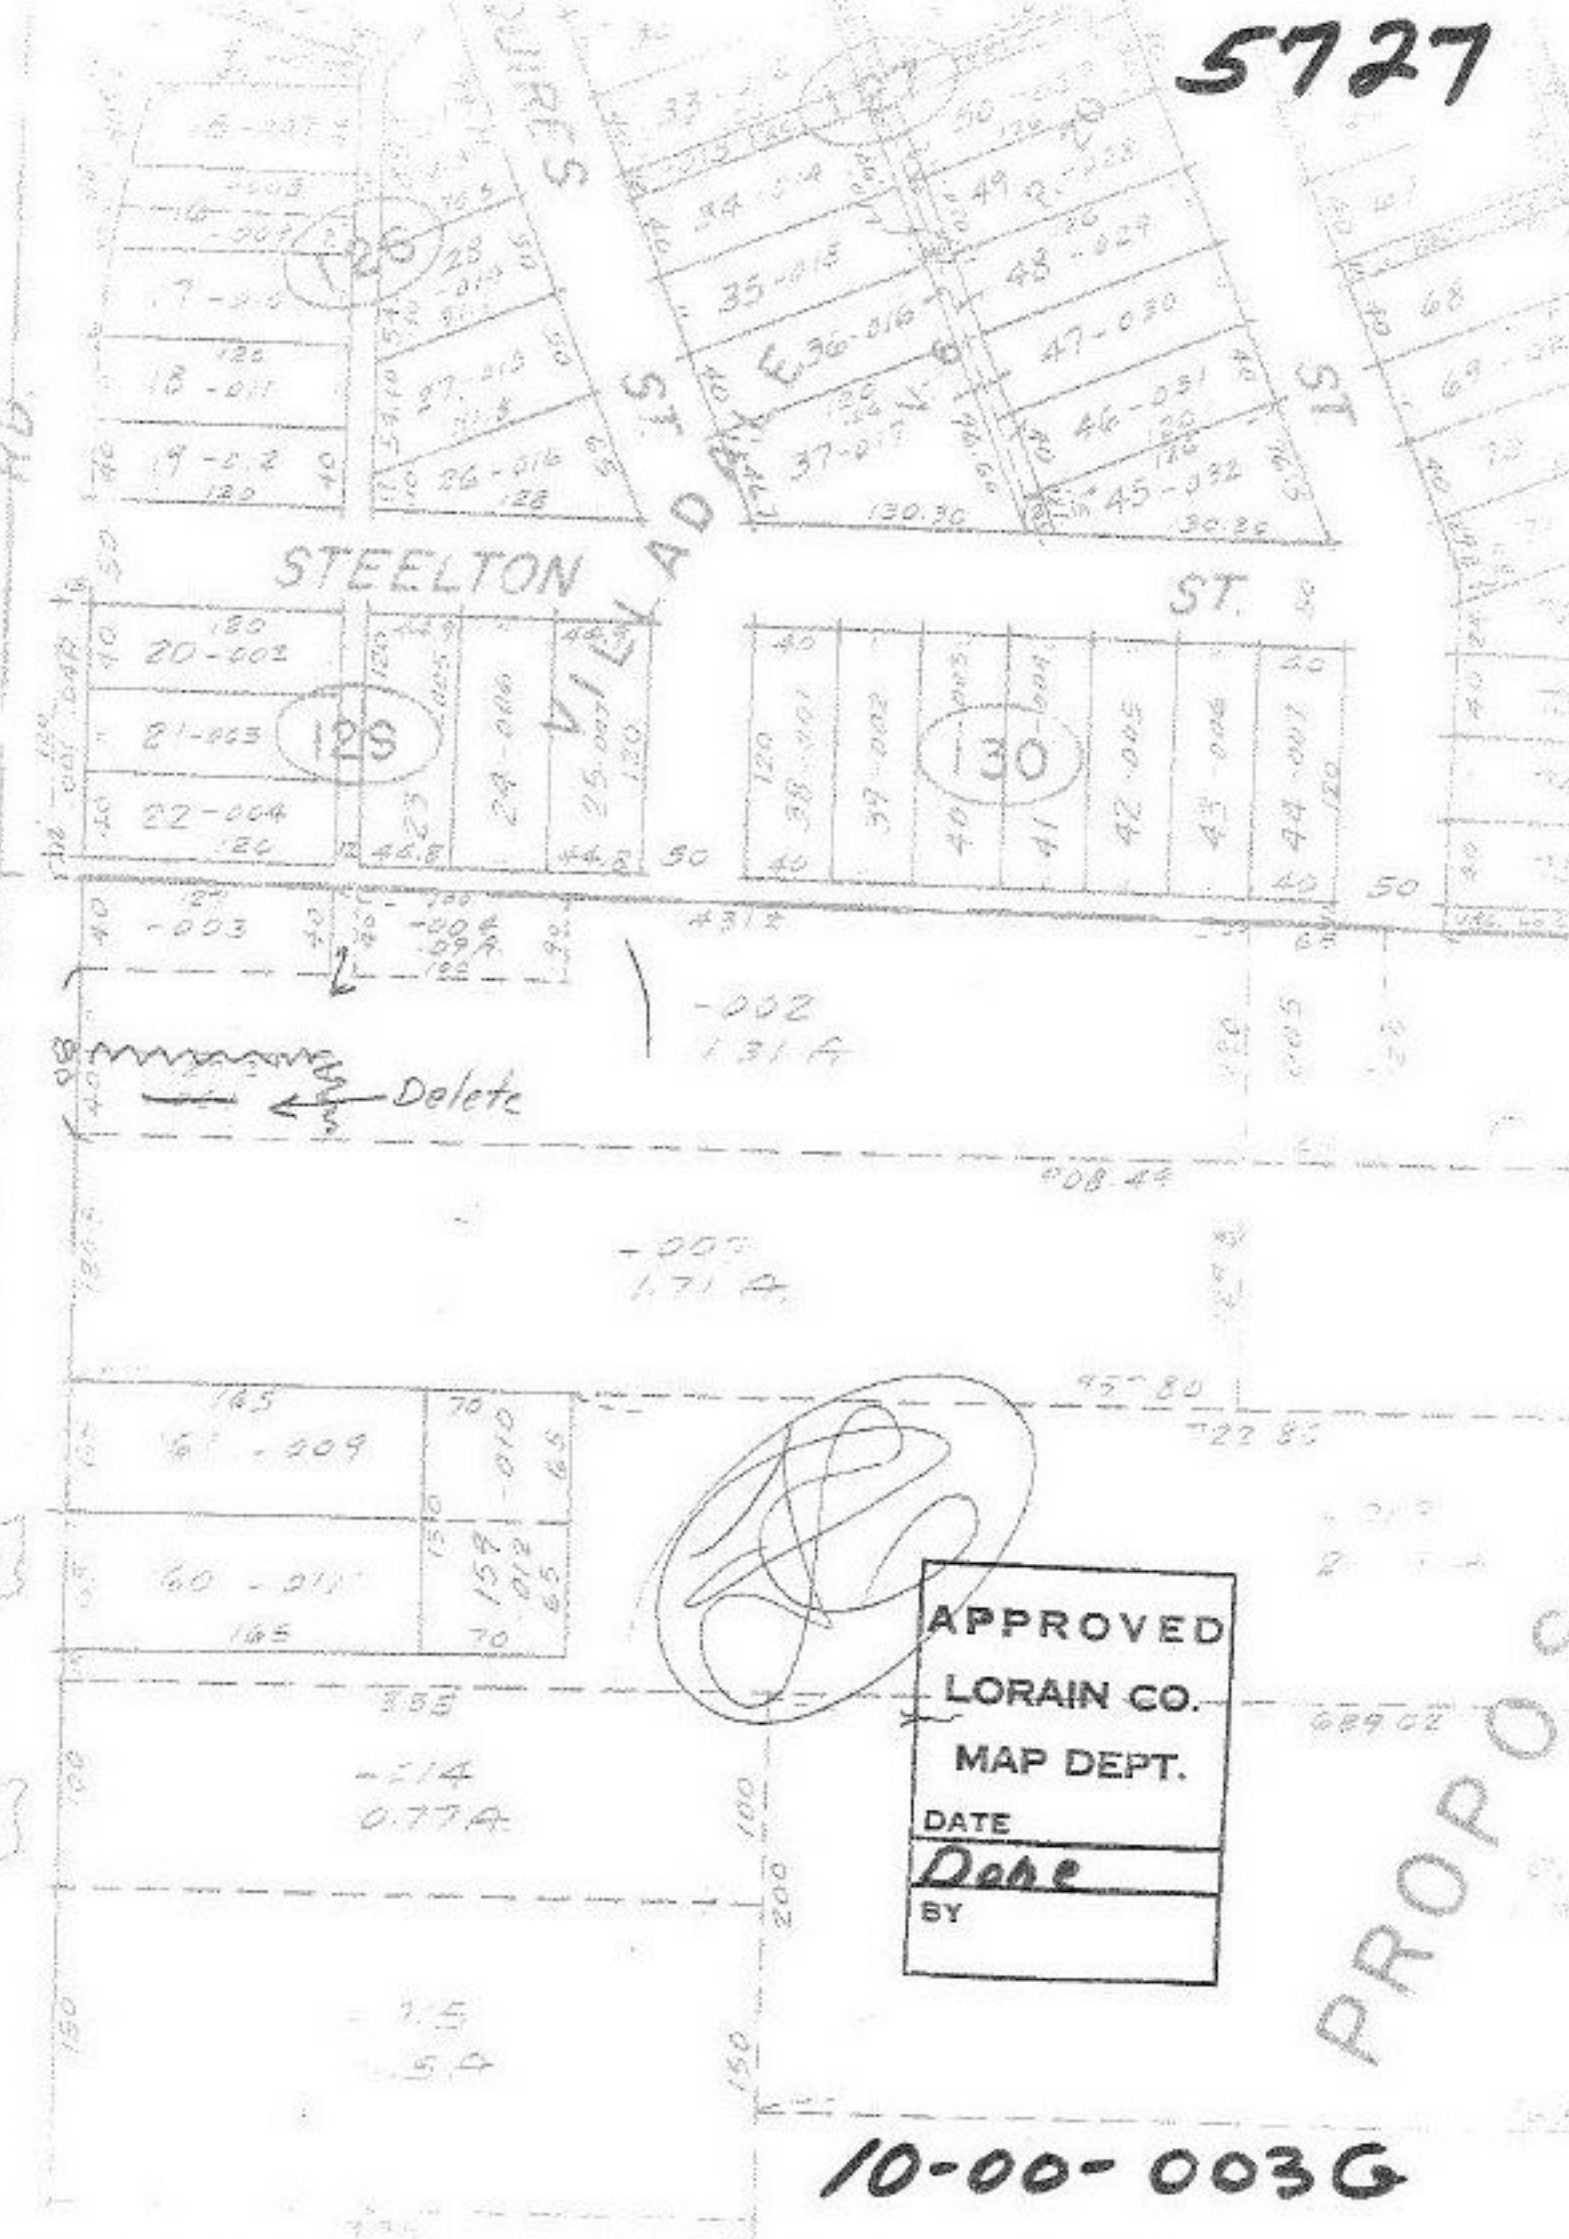

APPROVED
LORAIN CO.
MAP DEPT.
DATE
<i>Debe</i>
BY

PROPOSED

10-00-003G