



5732

B

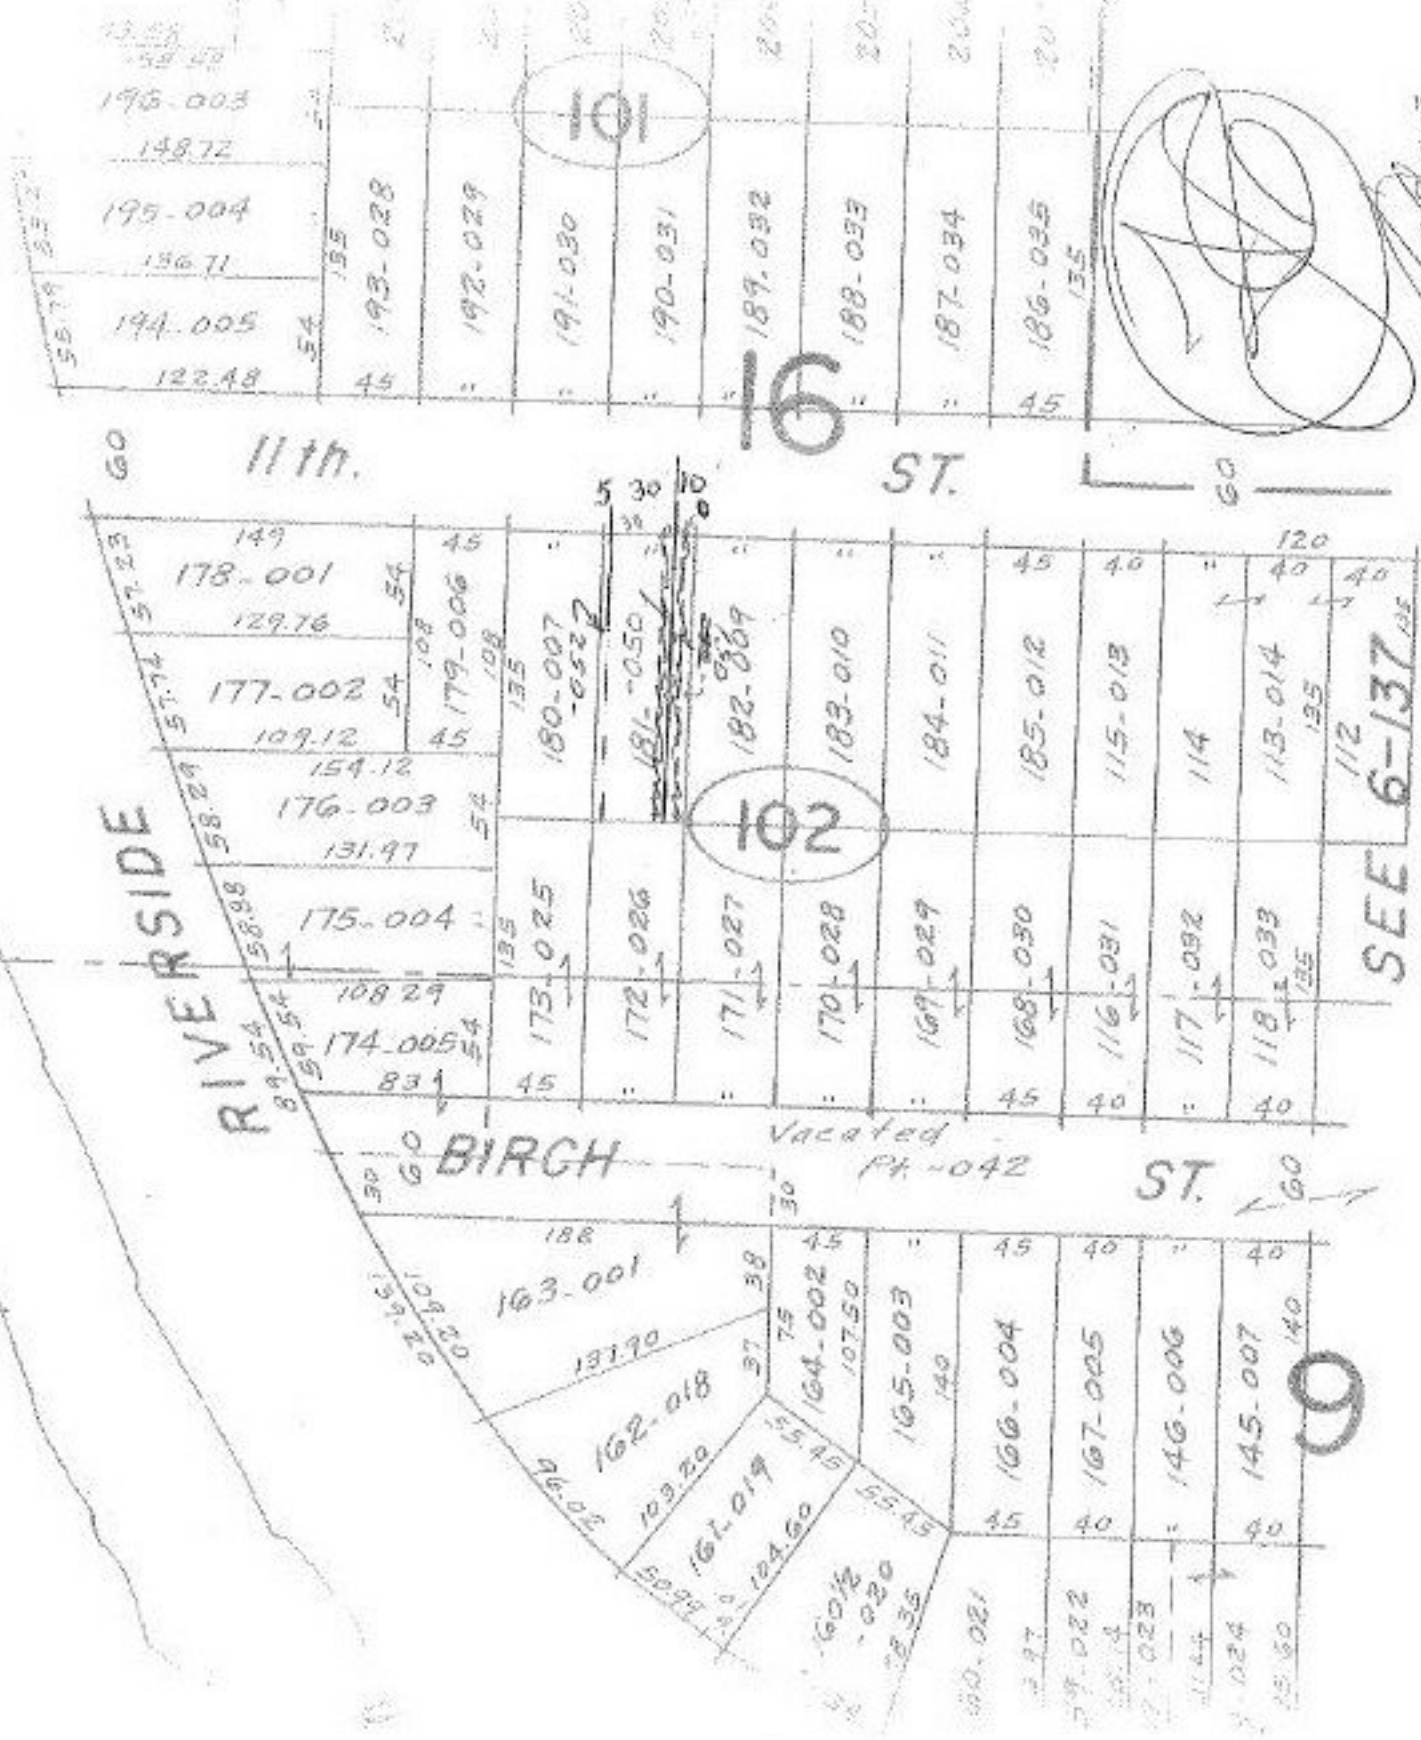

SEE 6-137

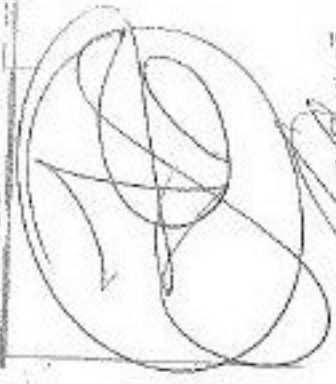

06/26-016-102-051 10 x 195
-052 5 x 195
Richard Idy R. 11/9/69
Richard Idy R. 11/9/69
Richard Idy R. 11/9/69
Richard Idy R. 11/9/69

FEB 10 1969

5732

Map Correction

6-136