

$$\begin{array}{r} 1461.96 \\ 1481.39 \\ \hline 2943.35 \\ 1471.68 \end{array}$$

$$\begin{array}{r} 1199.86 \\ 1199.50 \\ \hline 2399.36 \\ 1199.68 \end{array}$$


R

Map Correction

28

-001
72.06 A.

-002
41.53 A.

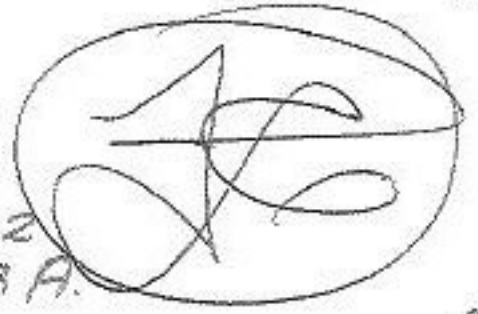

5732

FEB 10 ENT'D

19-G

5732

