


5752

BAINBRIDGE

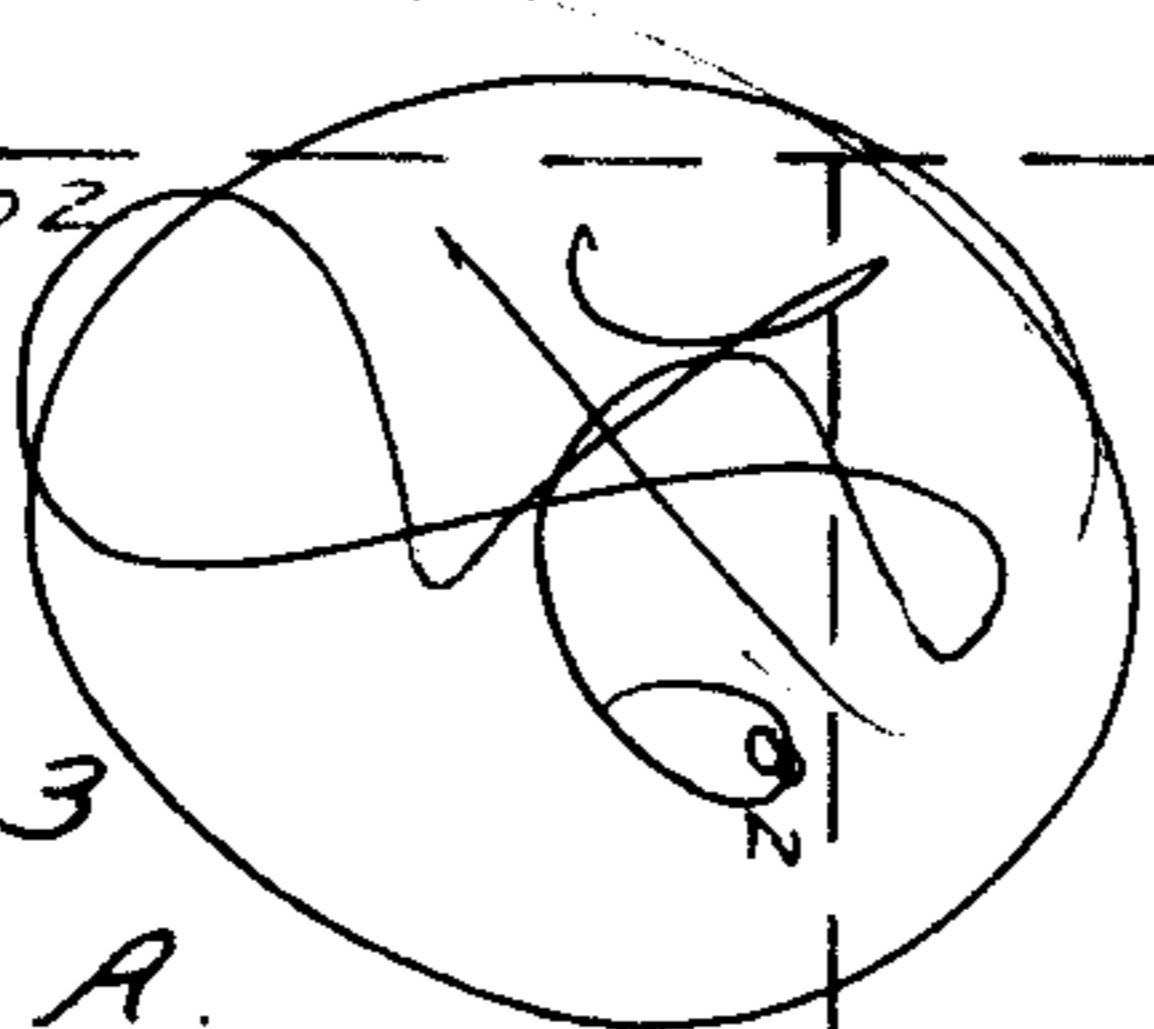

APPROVED
 LORAIN CO.
 MAP DEPT.
 DATE 4/21/72
 7-00-016-D
 BY P. L. Kellum

7-21-86 L.L.

250 02
-073
1.05 A.

250 92

-076
.76 A.

250

-077
.51 A.

250

-135
.52

~~-078~~
A.

-136
.52

250

-025
.57 A.

250

WIL-LOU

220

81 -012

82 -013

66 26

202 23

88 36

739 4
76 50

WILLOU

131 42

190 71

29

-043

28

-044

27

180 79

-045

807

66 93

26

180

-046

76 50

PITTS

30 - 042

179 59

31 - 041

172.4

32 - 040

138.94

36 - 022

112.69

35 - 023

37 - 021

76 50

84 - 024

64 97

WIL-LOU

81 -012

82 -013

33 -01

34

85

86

87

SEE 7-00-015-B