

10-003

9-004

8-005

7-006

6-007

103

5-008

4-009

3-010

150.90

2-011

153.85

1-012

173.80

N. 1° 30' W.

0.40A. 0.13

173.81

0.591 -022

201.22

0.30A. -021

89.30

201.78

N. 88° 50' W. 908.20

1434.92

1134.82

120.82

-024
0.84A.

300

183.44

230
200
-016
.37A.

5.89° 00' E.

200

11-001

5753


APPROVED
LORAIN CO.
MAP DEPT.

DATE 4-6-72

5-00-004-B

BY *Haller*

7-21-84
L.L.

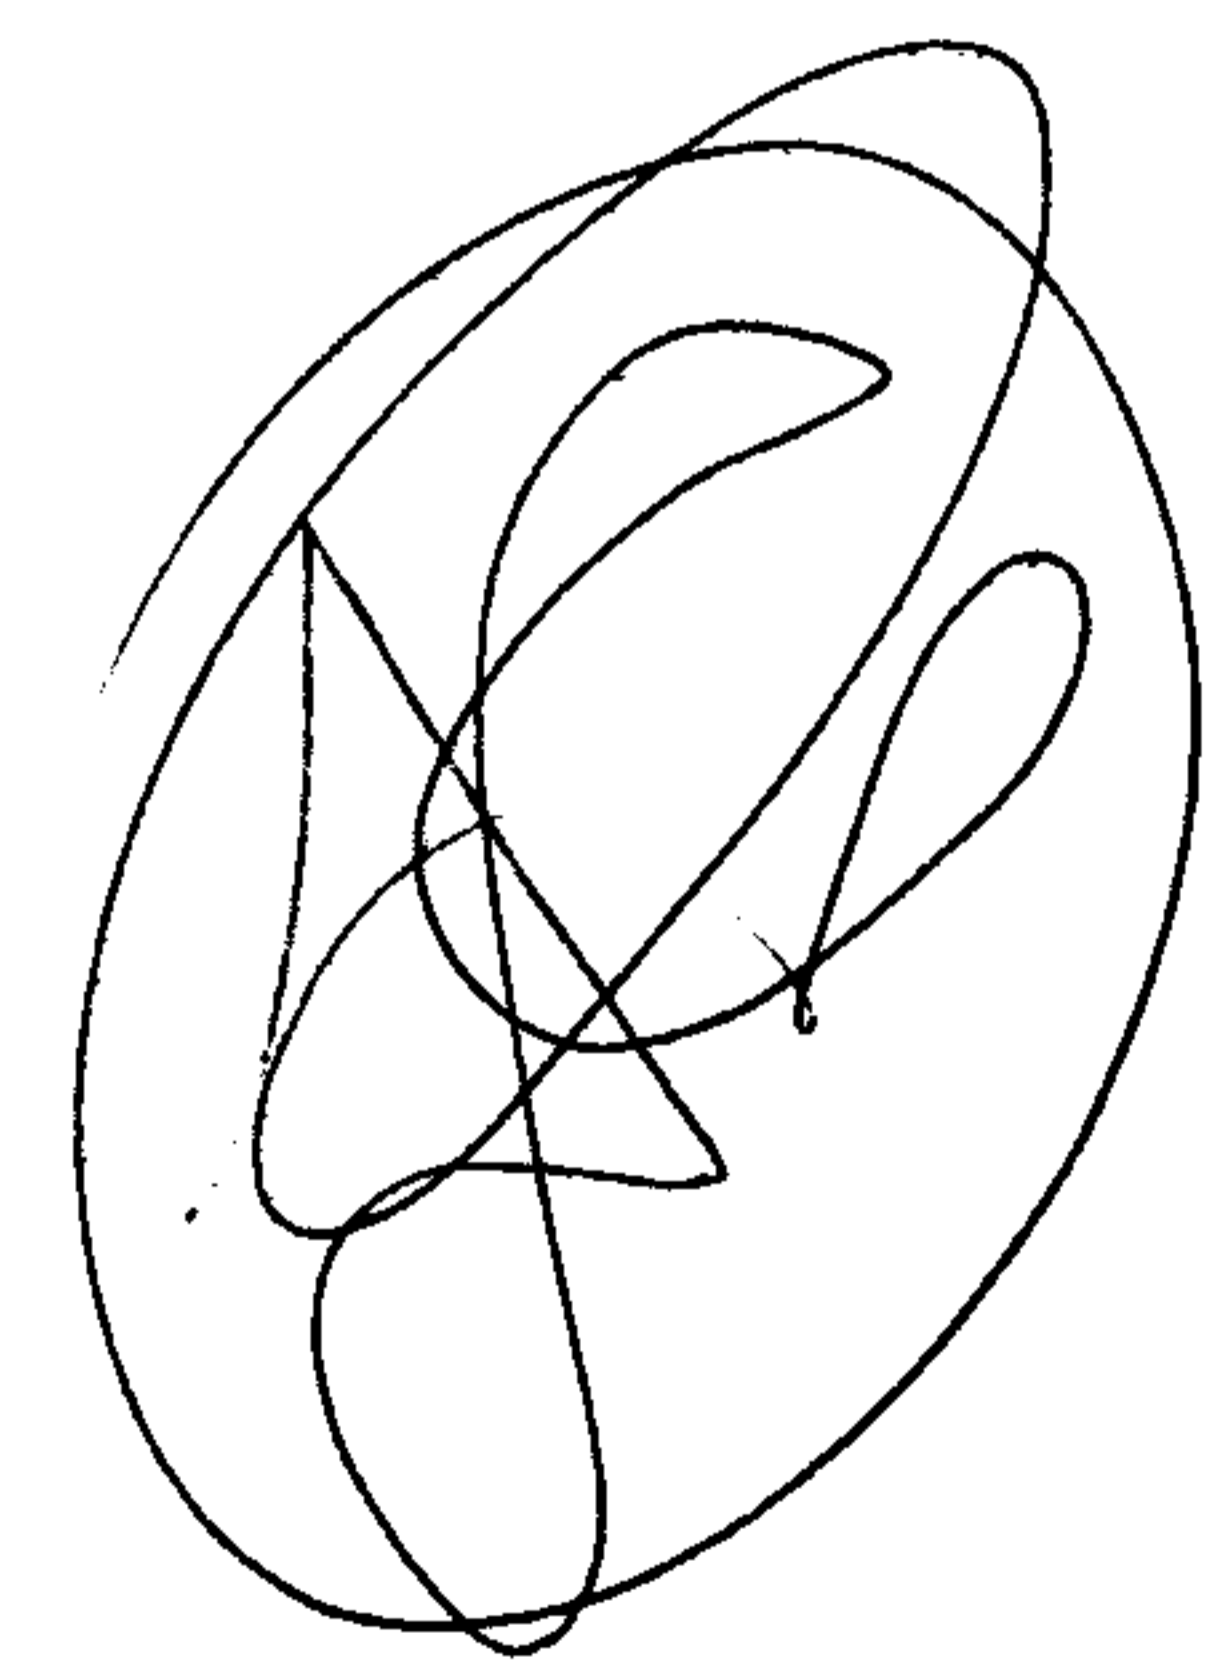

~~37.04~~
~~36.20~~
84

1043.49

10-002 NO.
104 NO.

9-003

200

ALEXANDER AVE.

200

8-001

7-002 B.

P. 16

1263.27

103

-023

-020

37.04A.

36.20A.

JUNI GENTD

1248.60

SEE 5-00-017-A

5753