

SEE 6-124

385.84


#5663  
5755

-051  
~~-049~~  
~~-047~~  
~~11.88 AC~~  
~~13.11 AC~~  
13.05 AC / 3.15

See  
Transfer  
Sheet # 5755

165.74  
156.41  
9.33

661.71

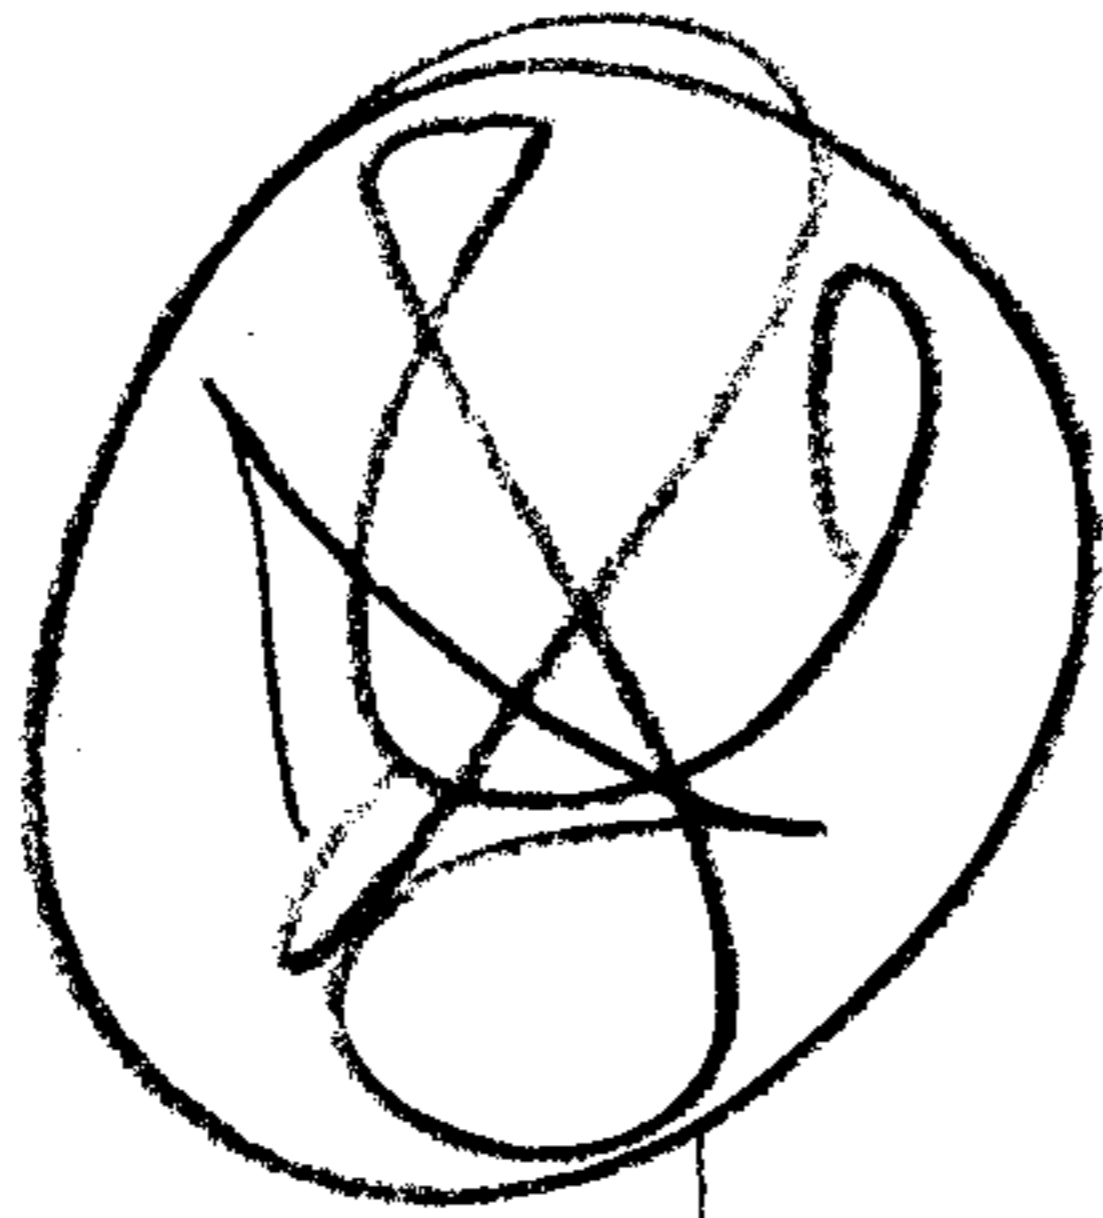

Combine  
see Register

MEMORIAL

7

5663  
APPROVED  
LORAIN CO.  
MAP DEPT.  
DATE 3-2-72  
6-125  
BY LW Hall


165.74  
156.41  
96 156.41

265.75  
106 AC  
265.92  
265.92  
-002  
56A.  
292.88  
-003  
62A.  
319.84

-004  
85 A. Dup.  
77 A. D.  
346.80

392.69  
328.66  
SUGAR RIDGE  
S. 70° - 47' 0" E 403.29  
150  
628.66  
150  
60  
100

10.39  
114.76  
108.93  
-017  
23A.  
160  
160

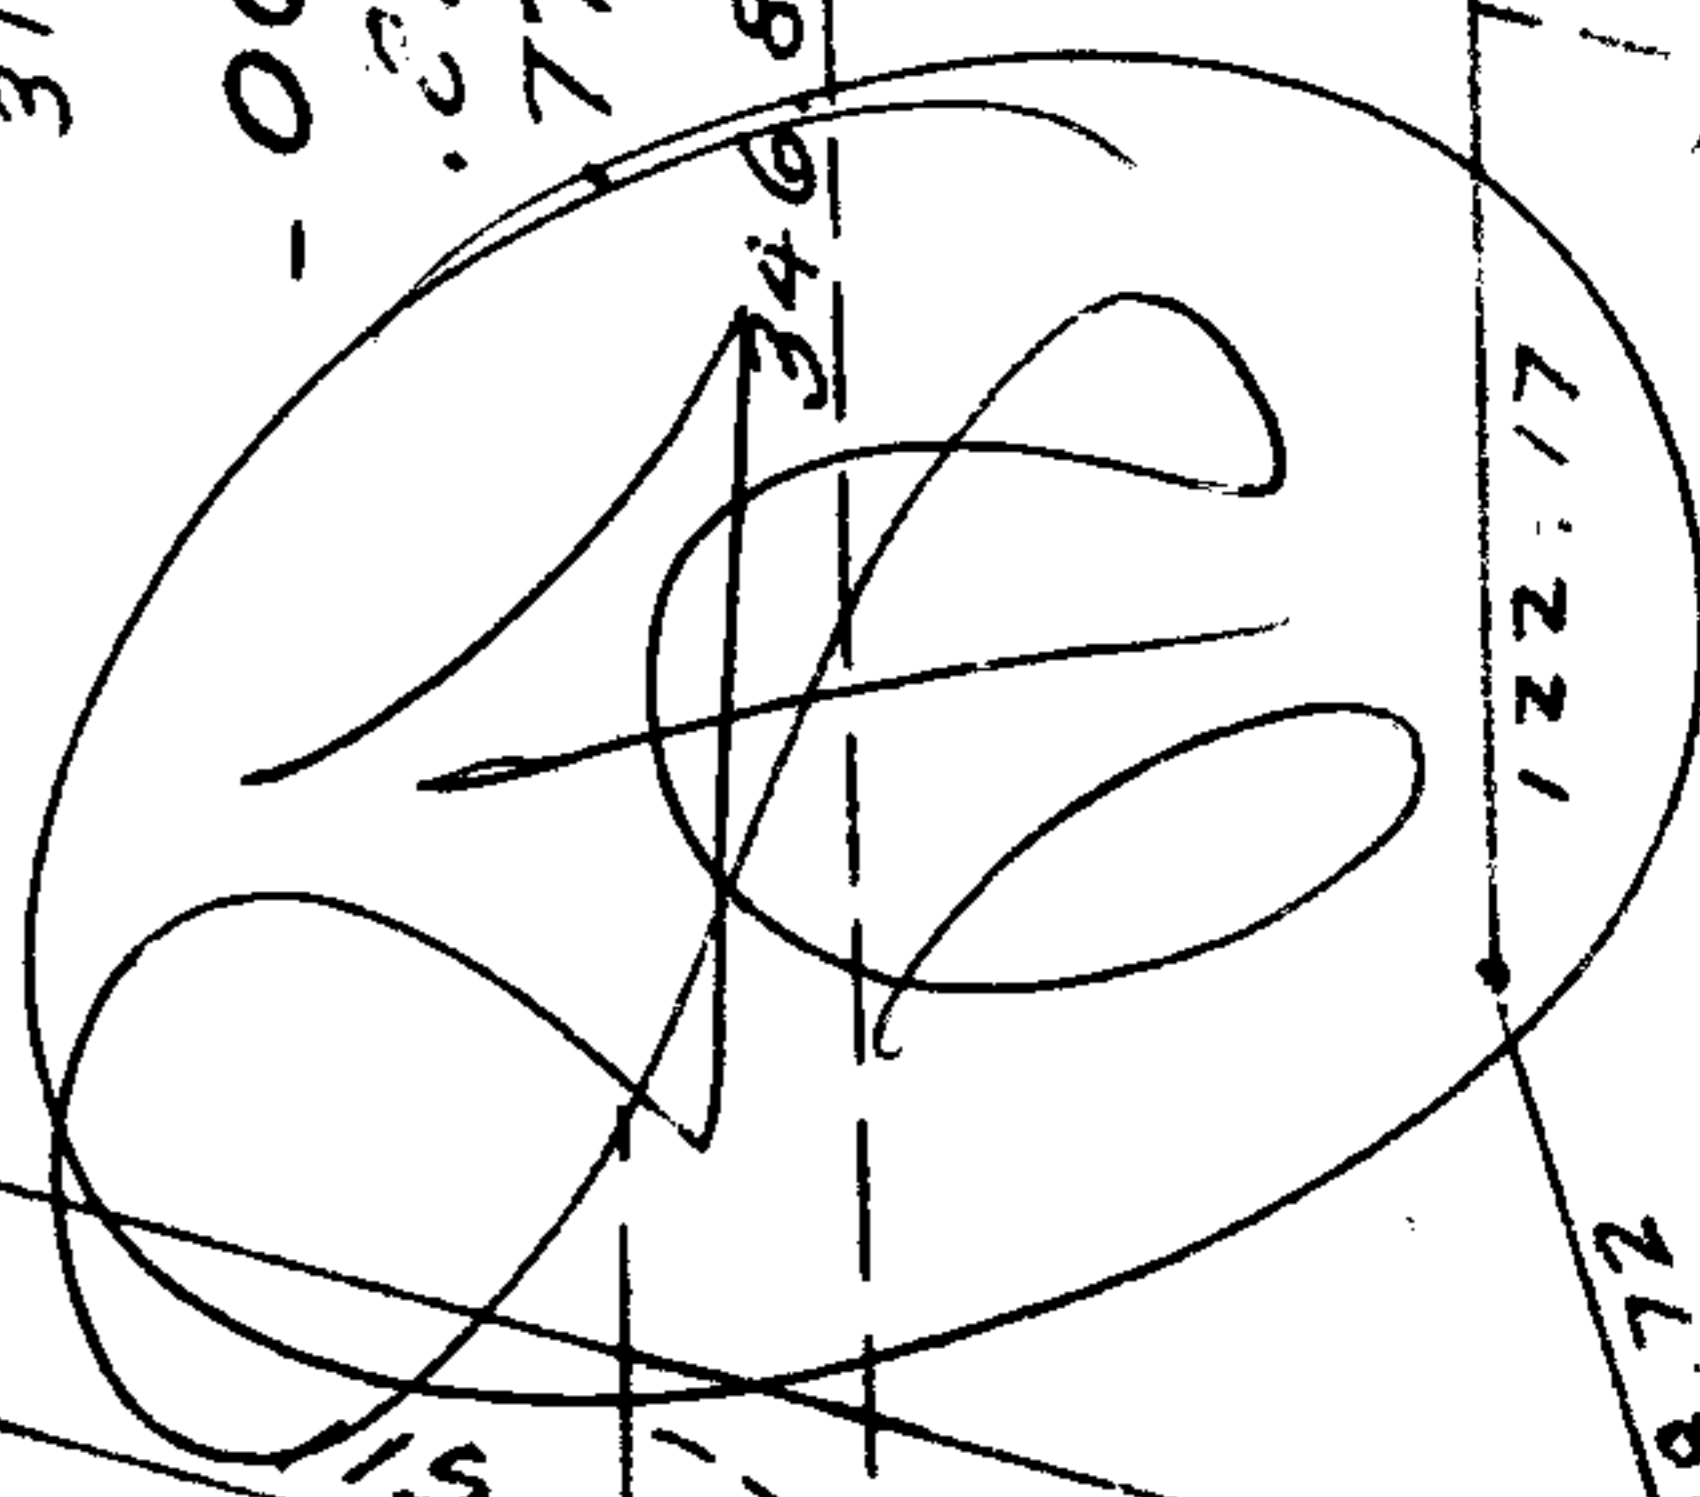

6-125

130.05  
-019  
38A.  
125  
115

525.94

-045  
4.35 A.

-027

120

118.72

122.17

129.52

125