

SEE 6-124

1385.84

1


-051
~~049~~
~~047~~
44.88 AC
43.11 AC
43.05 AC 13.15

SEE
Transfer
Sheet # 5755

156.74
156.74
133

661.71

#566-
5755

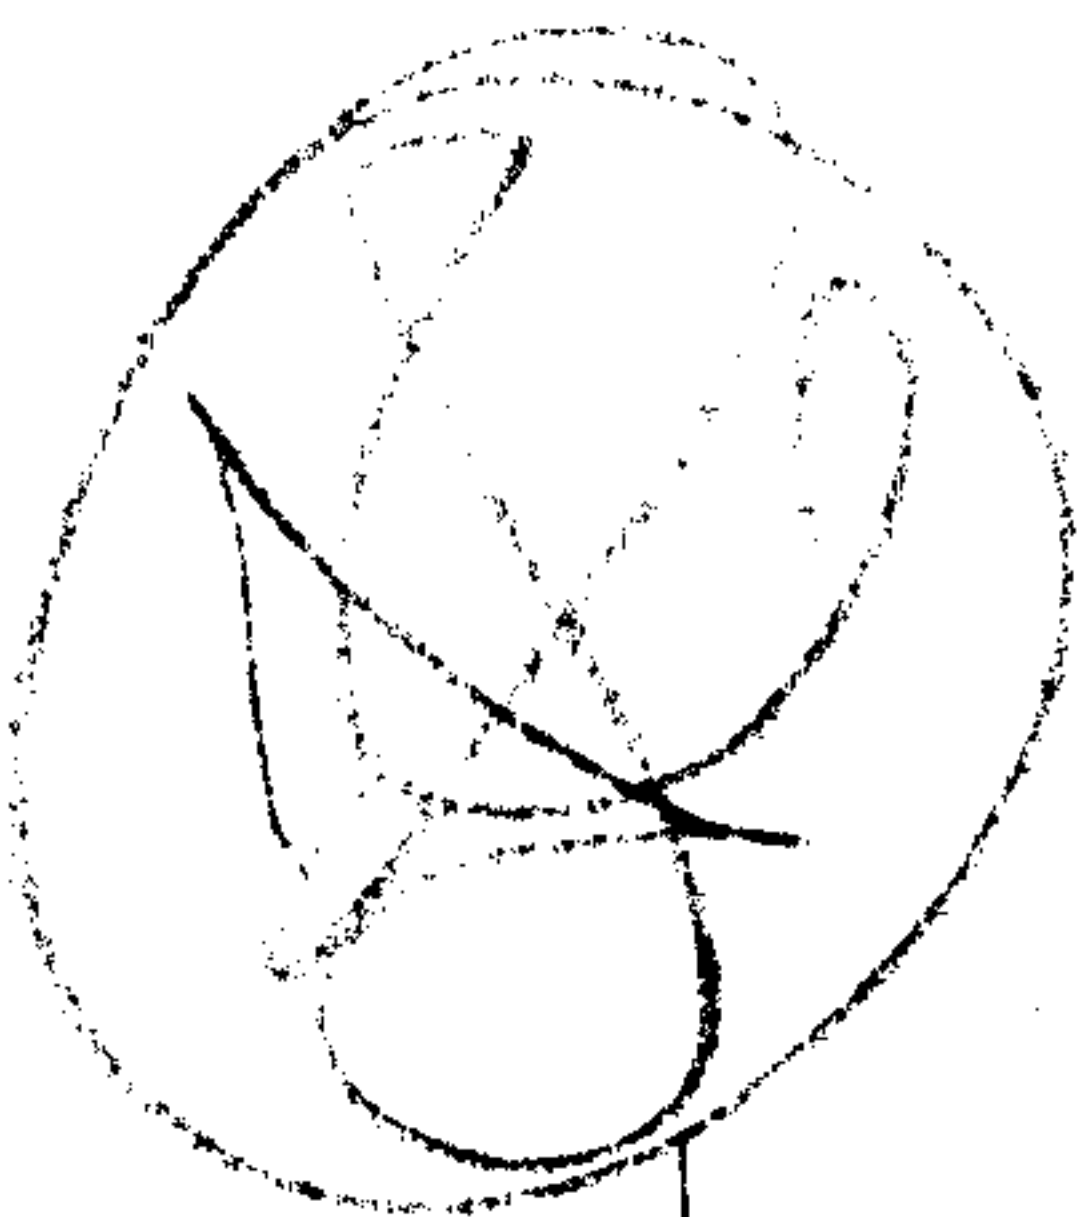

Combine
see Register

MEMORIAL

5663
APPROVED
LORAIN CO.
MAP DEPT.
DATE 3-2-72
6-125
BY LW Hall

165.74
156.41
96 156.4196
265.75
106 AC 65.97
265.92
-002
56F.
292.88
-003
62F.
319.84
-004
.25 A. Dup.
.77 A. D.
346.80

392.69
328.66
SUGAR RIDGE
S. 70°-47' 01" 403.20
150

MAR 30 ENT'D

045
35 A.

20.13
10.39
114.76
100.93
160
-017
23F.
160
100
60
100

6-125

130.05
-019
38F.

122.17
118.72

7

2