


SE 766
3-F

Pt. 03-00-083-101-006
Pt. 806A.

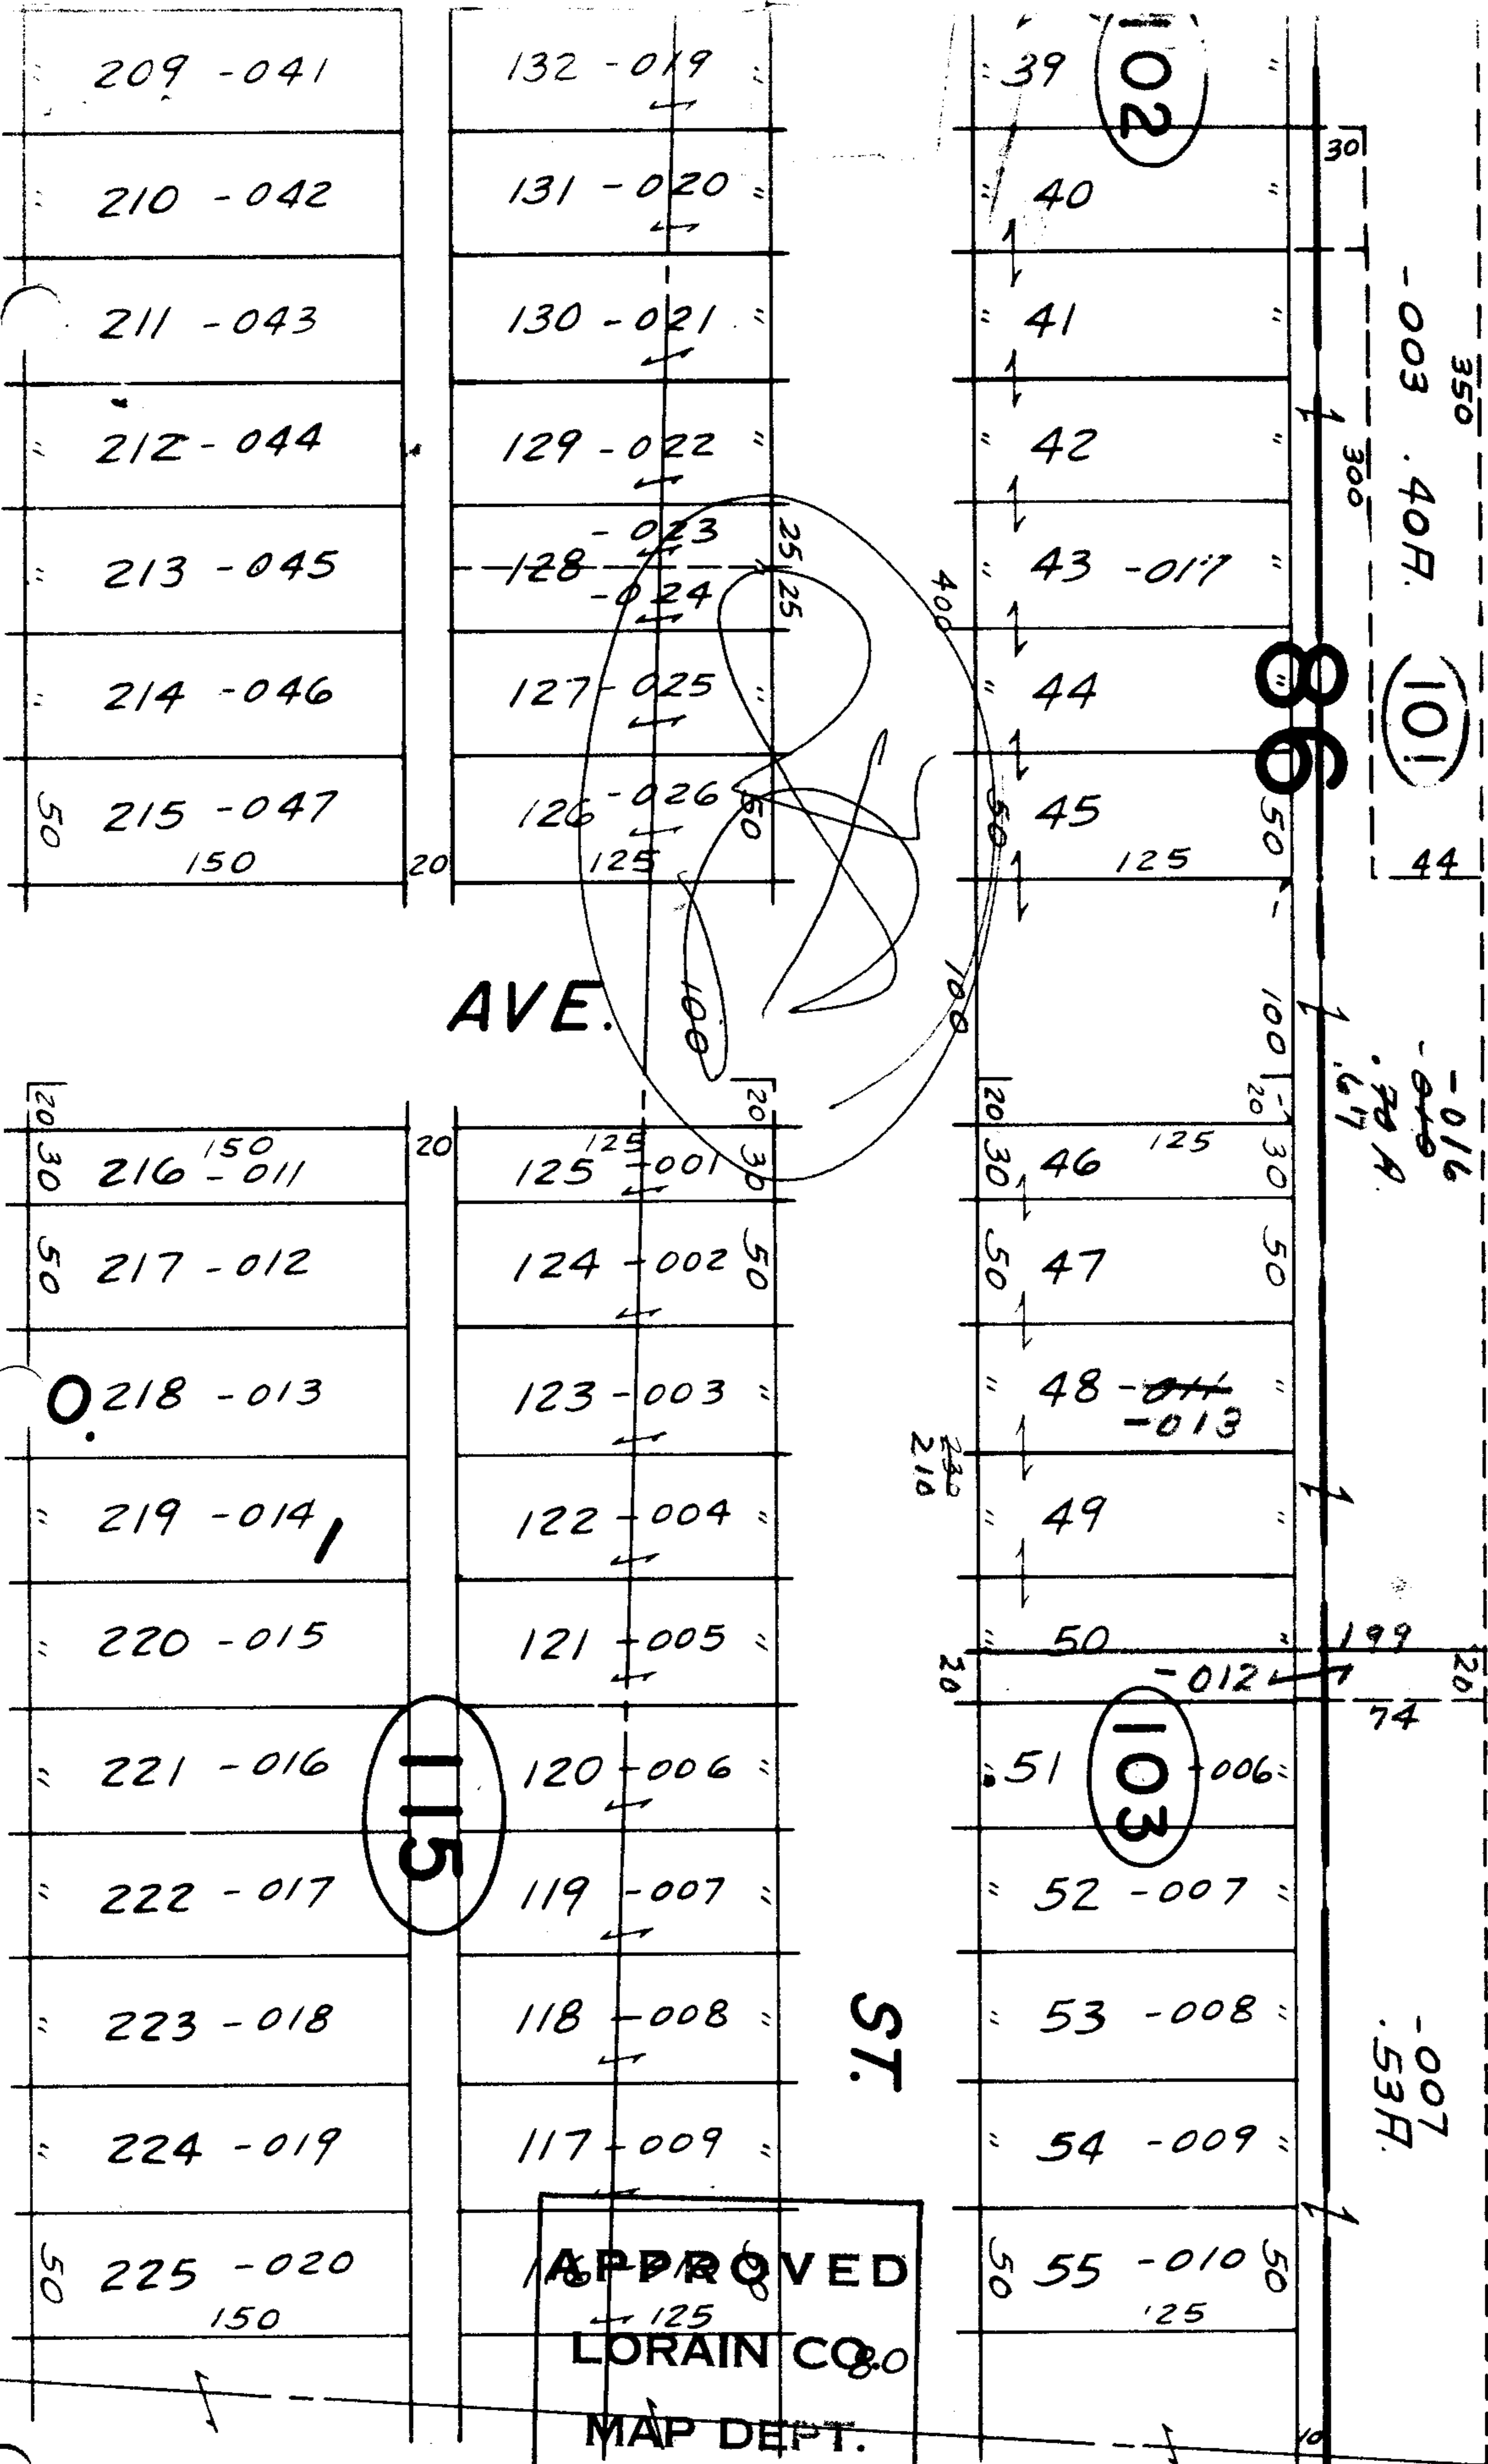

APPROVED
LORAIN CO. & O
MAP DEPT.
DATE 4/3/72
5-00-095-B
BY
R. V. Kellogg

JUN 16 1972

