

SEE 12-00-081-A

90

-019  
.60 A.  
289.99

90

289.99

1423.87


133  
3.377

1035  
5.08A

1327.71  
1335.5

-037  
5.09

1335.00

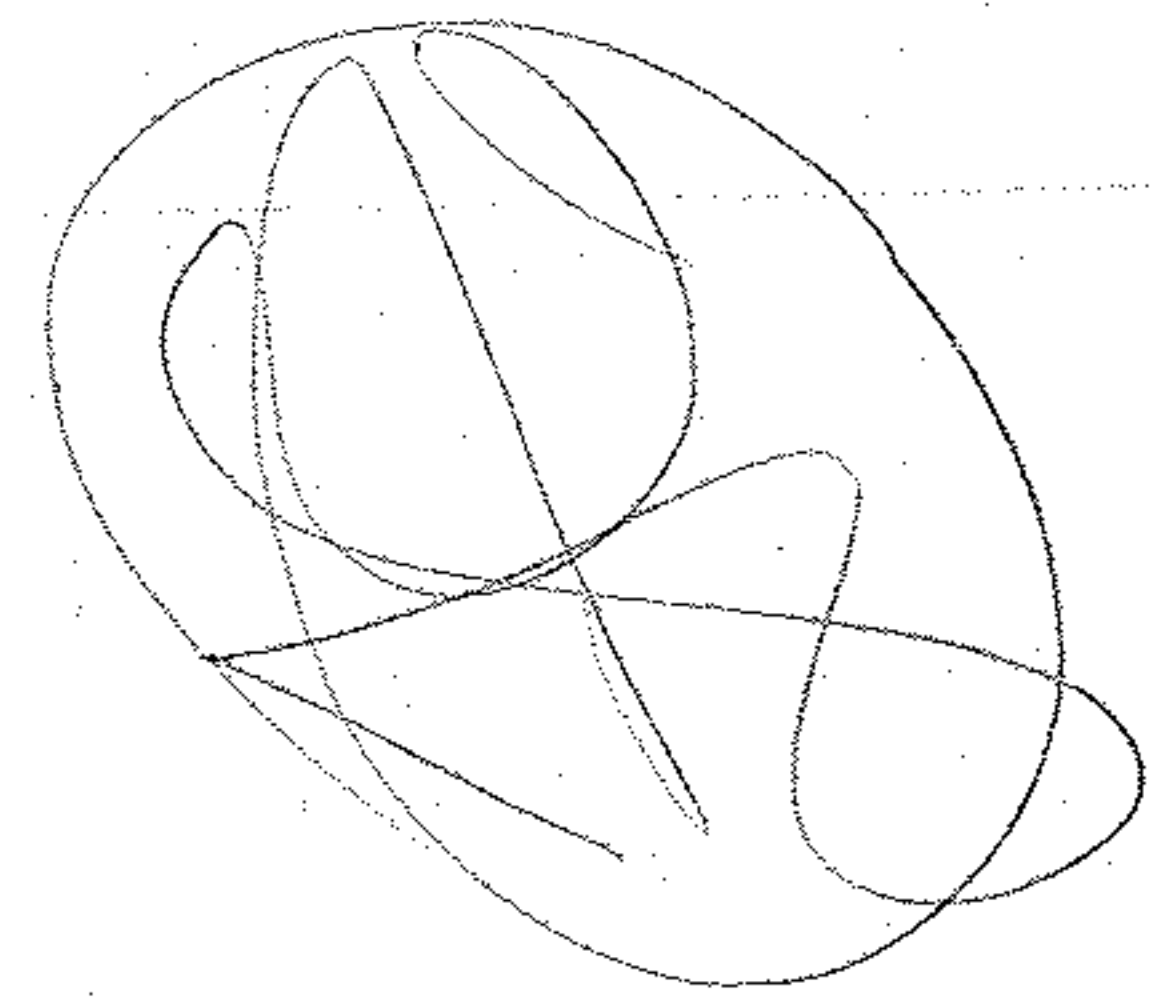

642

-031  
1.80A

189.98

-038

460.50  
460.76

69

102.14


~~35.2A~~  
30.03

7-22-86  
J.S.

APPROVED
LORAIN CO.
MAP DEPT.
DATE 4/4/72
12-00-081-B
BY R.L. McElroy

9/18-81/6

SEE 12-00-080-A

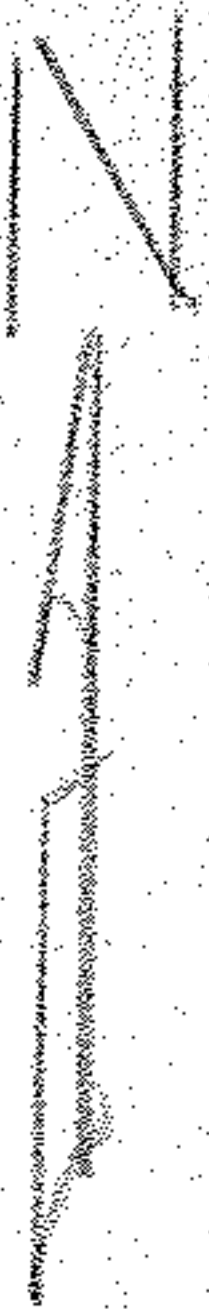

5771

150

166.60

166

166.60

166

166

166.60