



5800 SEE

BAINBRIDGE RD.

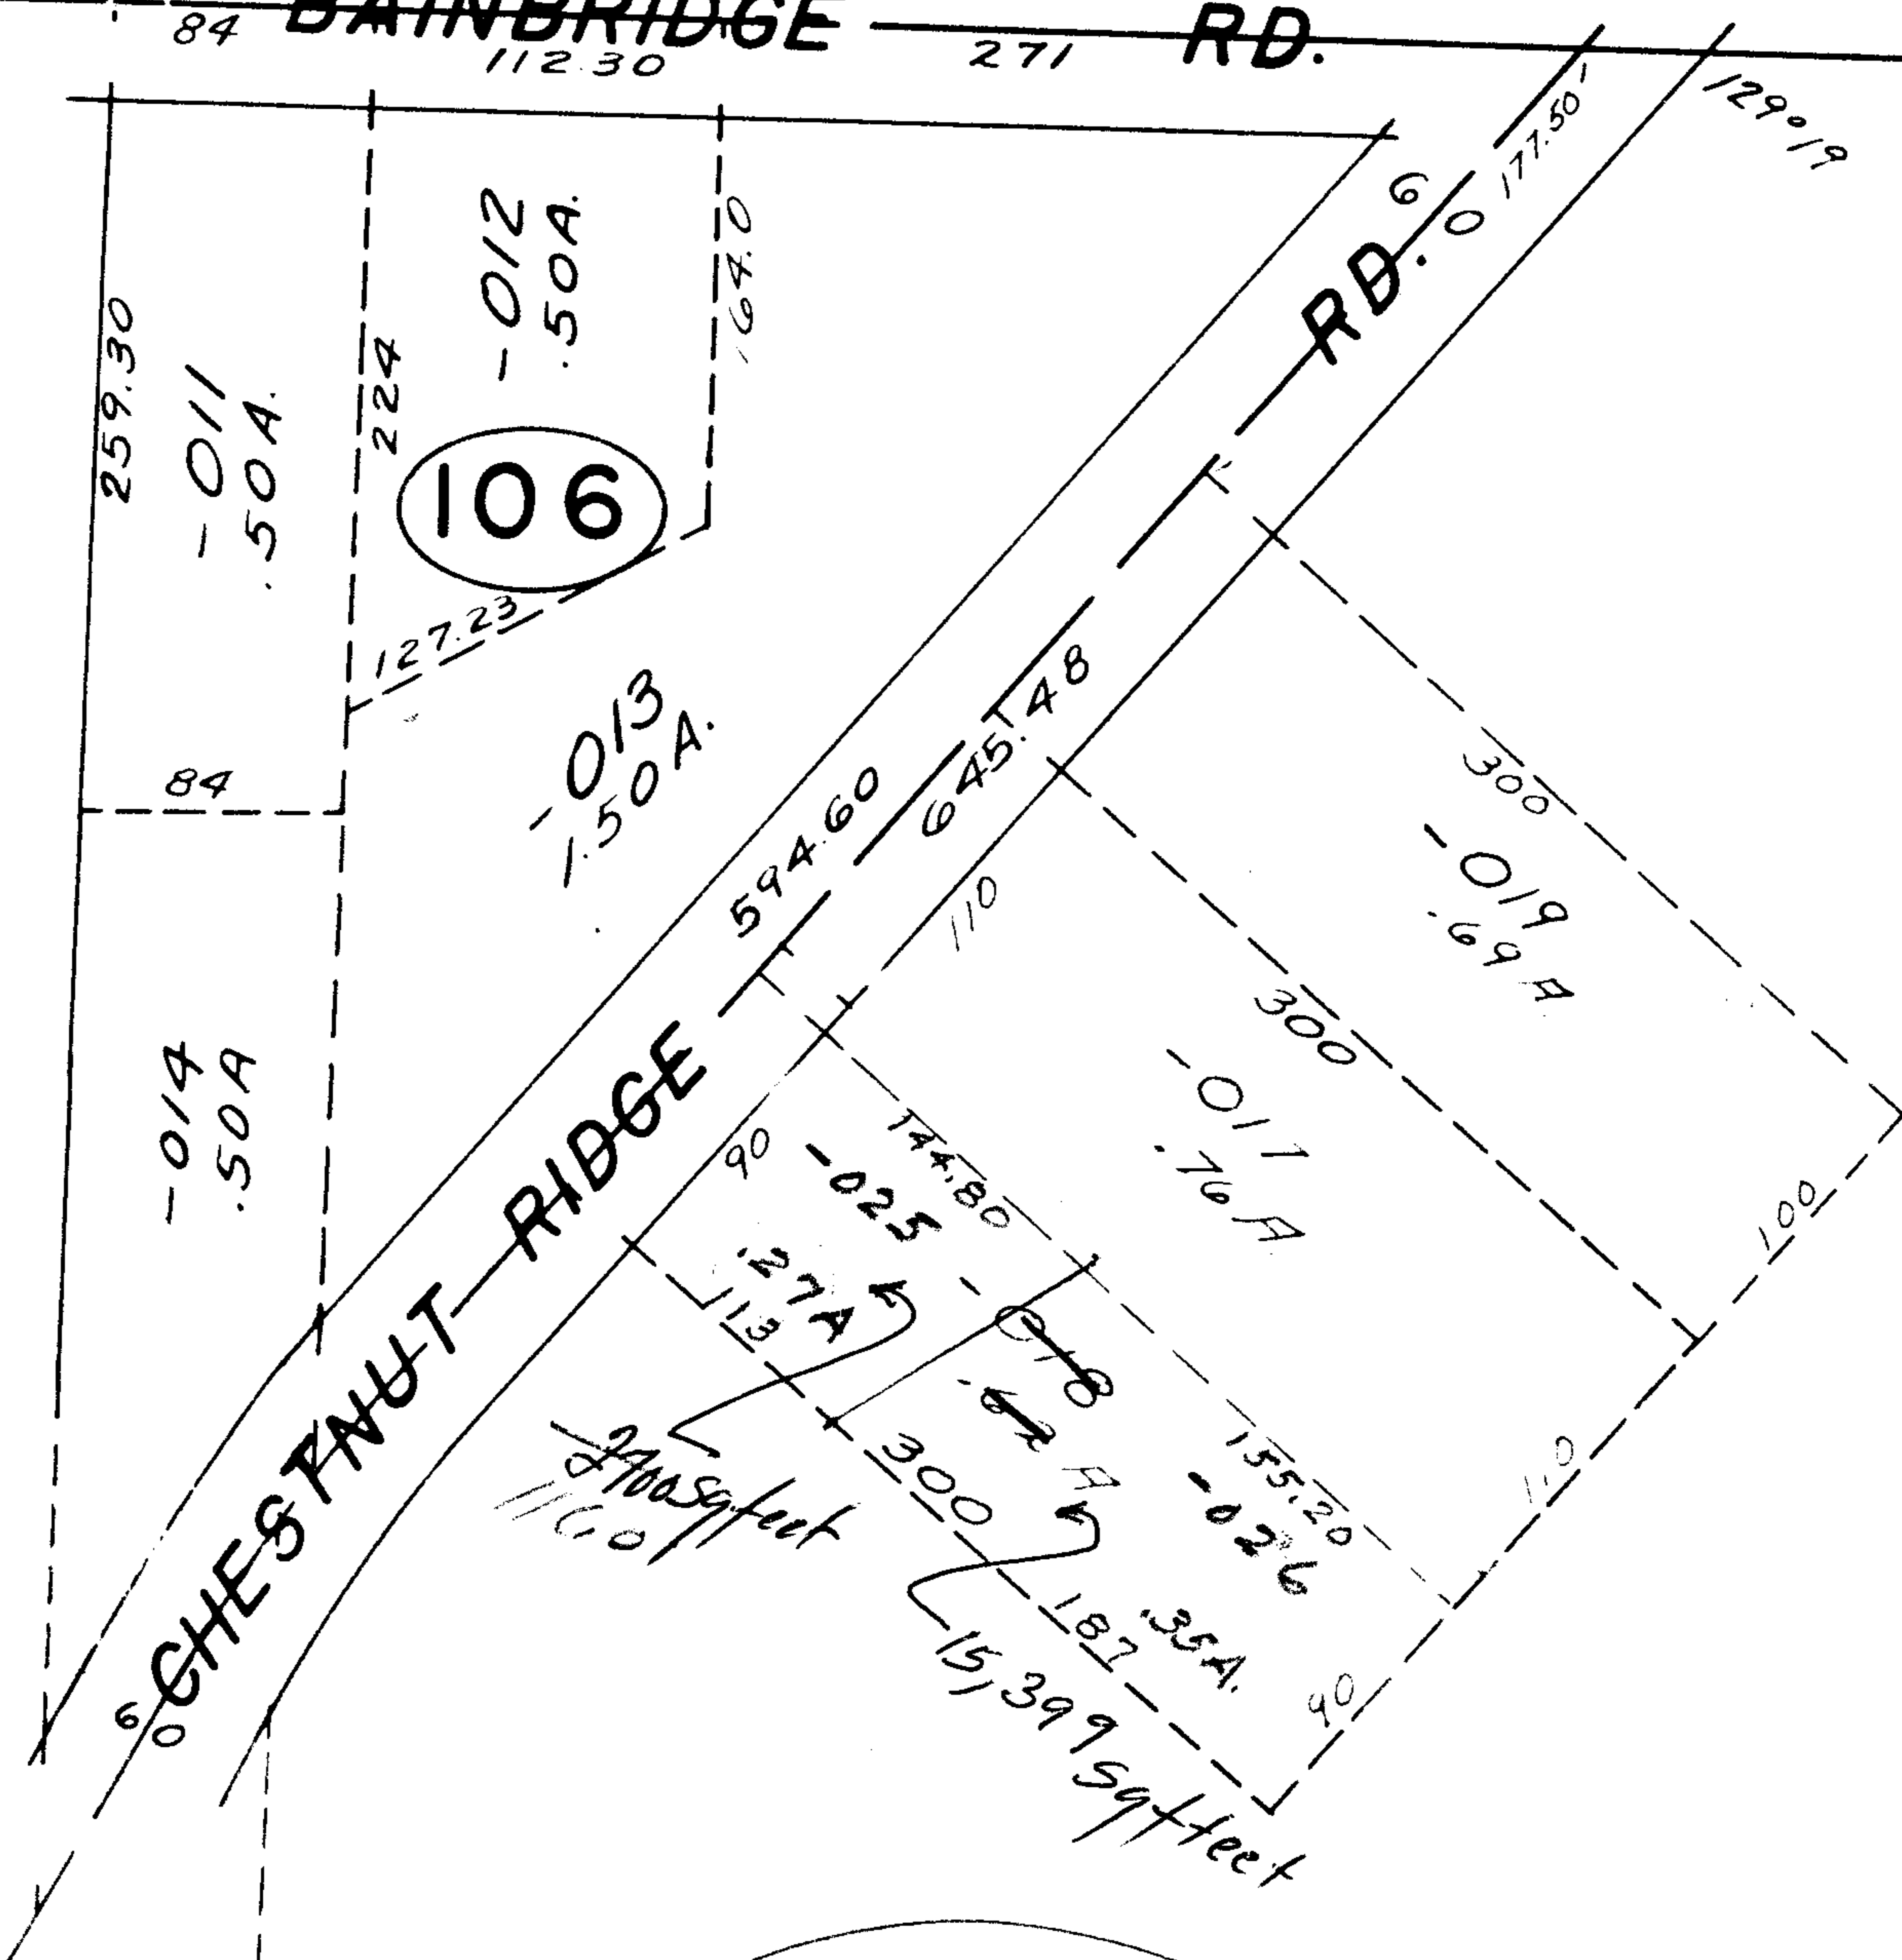

010-A

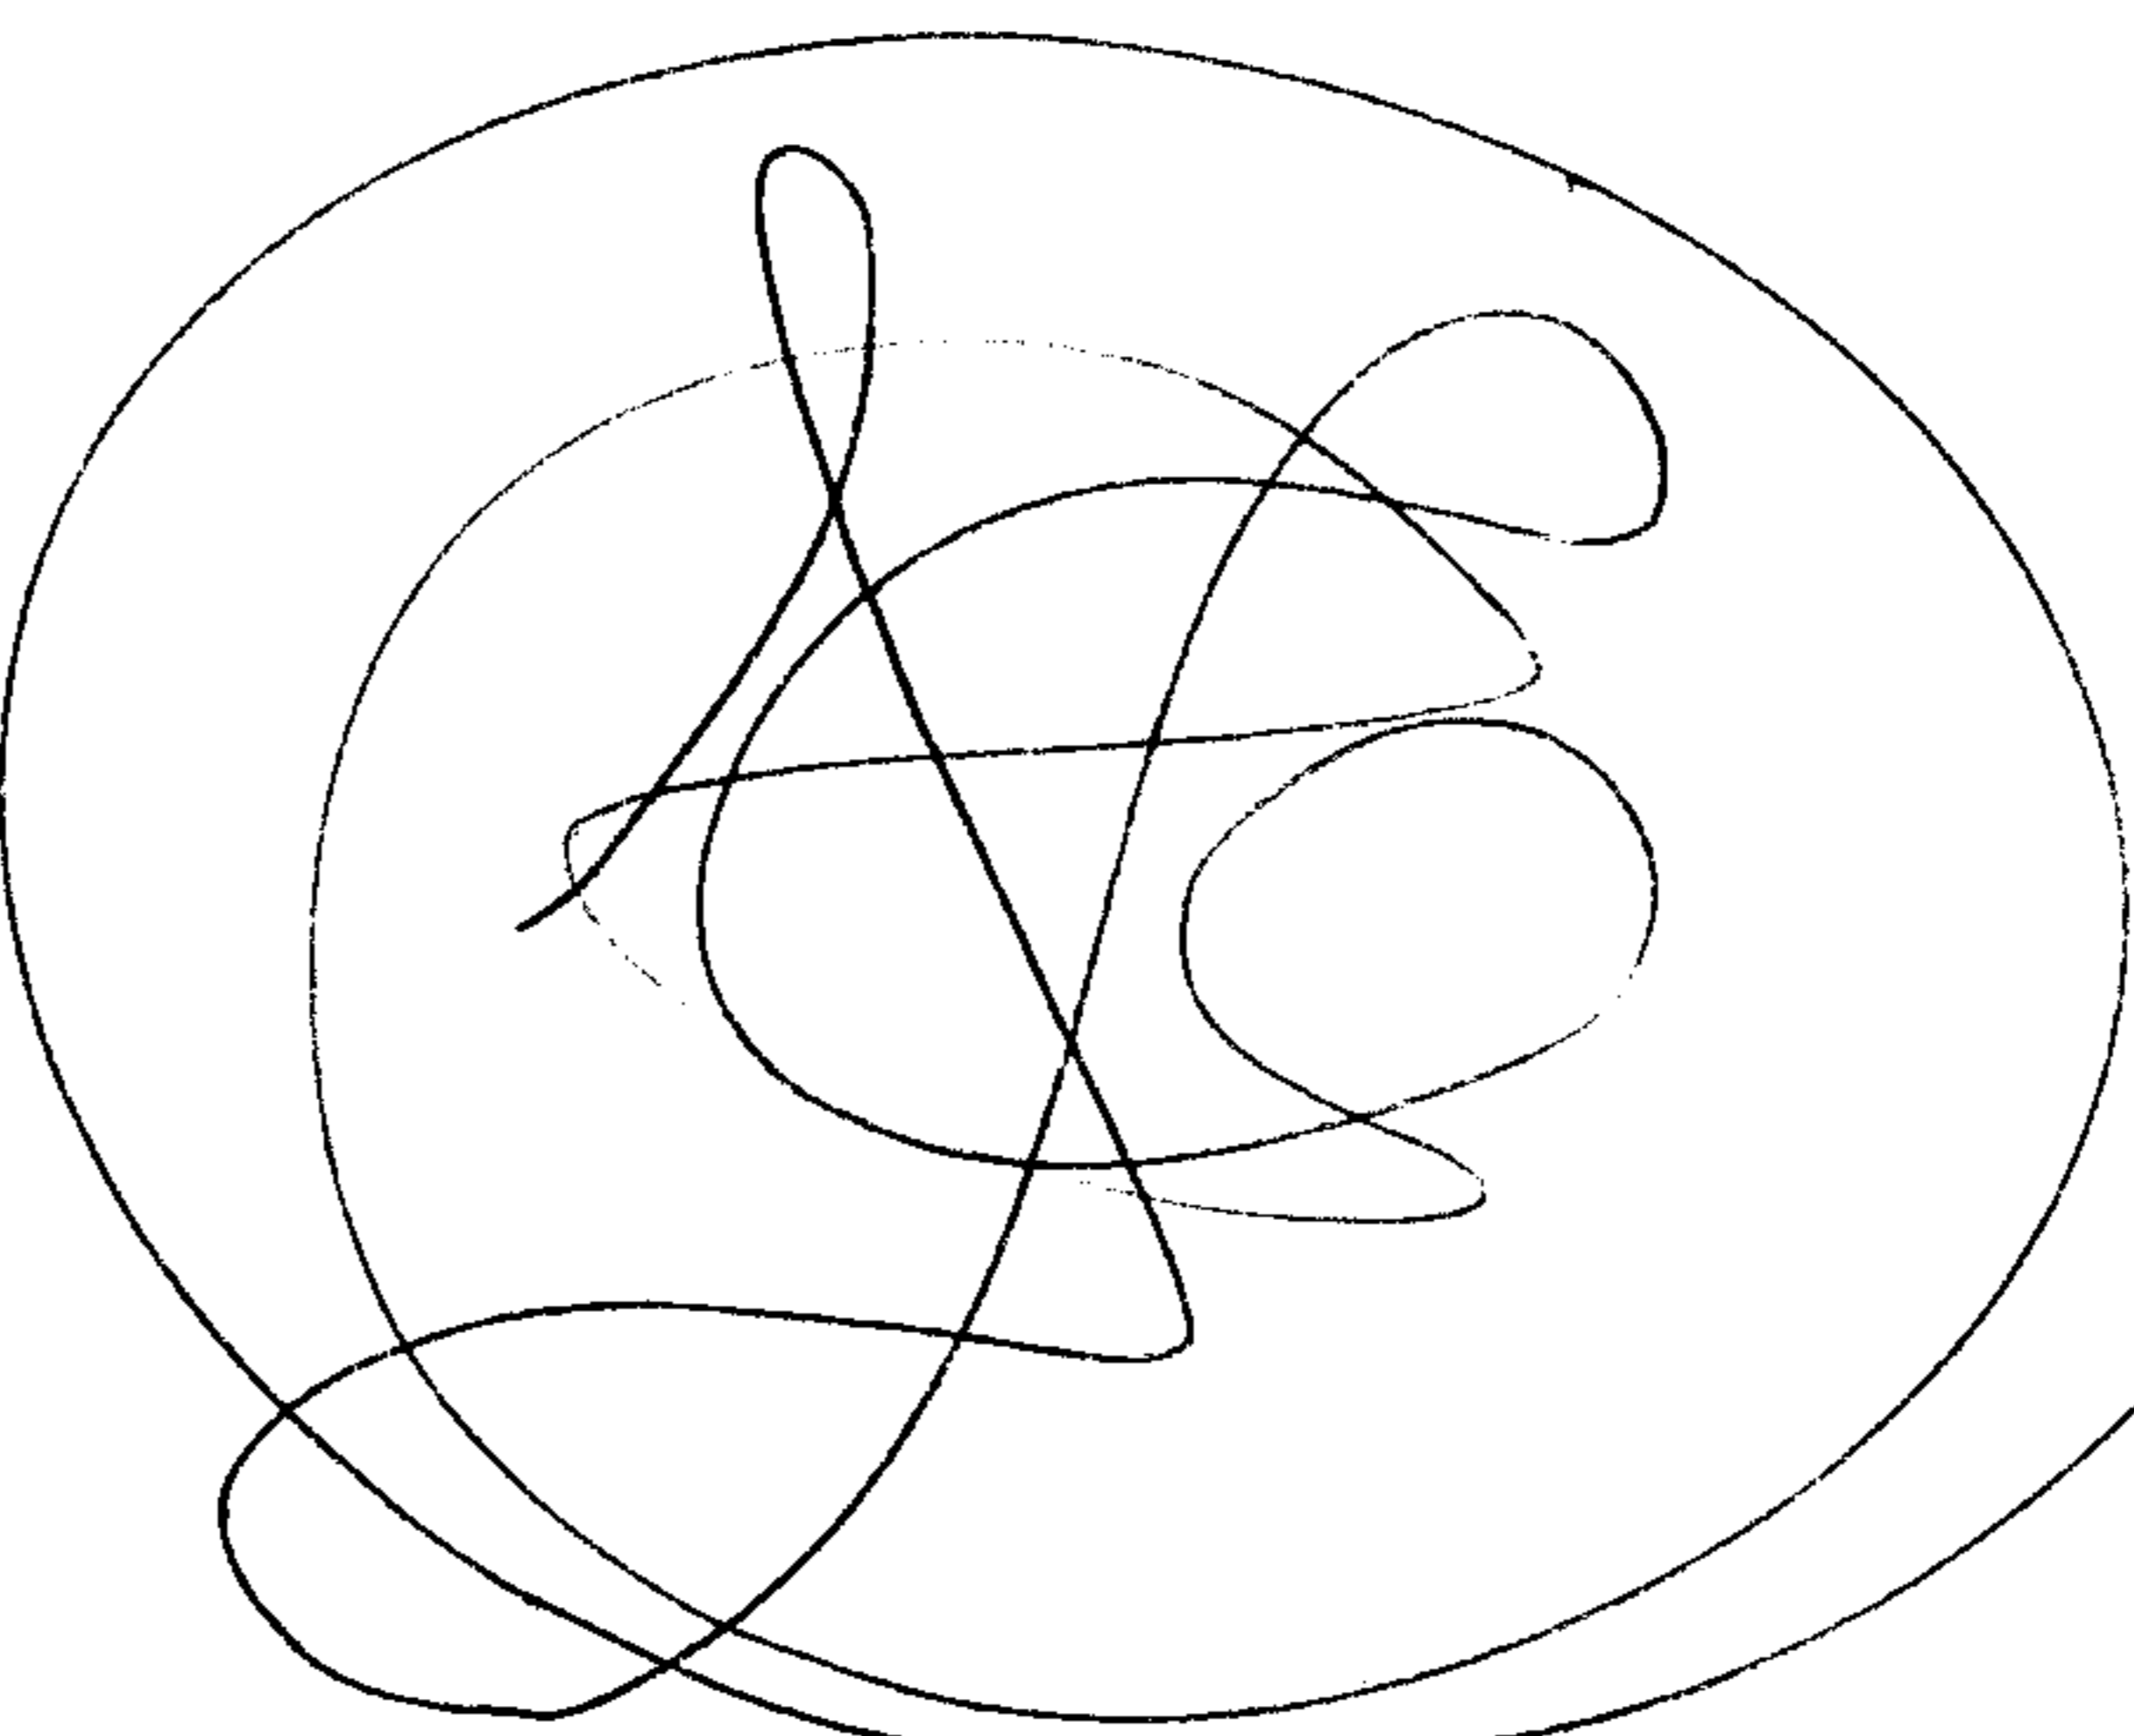

**APPROVED**  
**LORAIN CO.**  
**MAP DEPT.**  
 DATE 4/12/72  
 7-00-010-B  
 BY  
*R. J. Kelling*

7-21-86 L.h.

88°59'

9/15-72

13