

5809

-006
7.58A

-037
7.12A

662.31
660

S. 89°51'30"W. 977.20 1930.50

-001
5.09A

2970

-007
5.32A

-002
4.68A

-008
4.91A

-003
10.00A

-009
10.00A

660

1907.45

-017
14.03A

-010
7.62A

240 120 120

2072.13

-014 10.14A
2193.16

756.26

-018 778.18 1.18A

-016 1.26A
819.28

-015 10.14A
2302.35

-012
7.00A

2676


51

887.52

264.94

-005
23.00A

-020
~~-006~~
70.70A
60.37

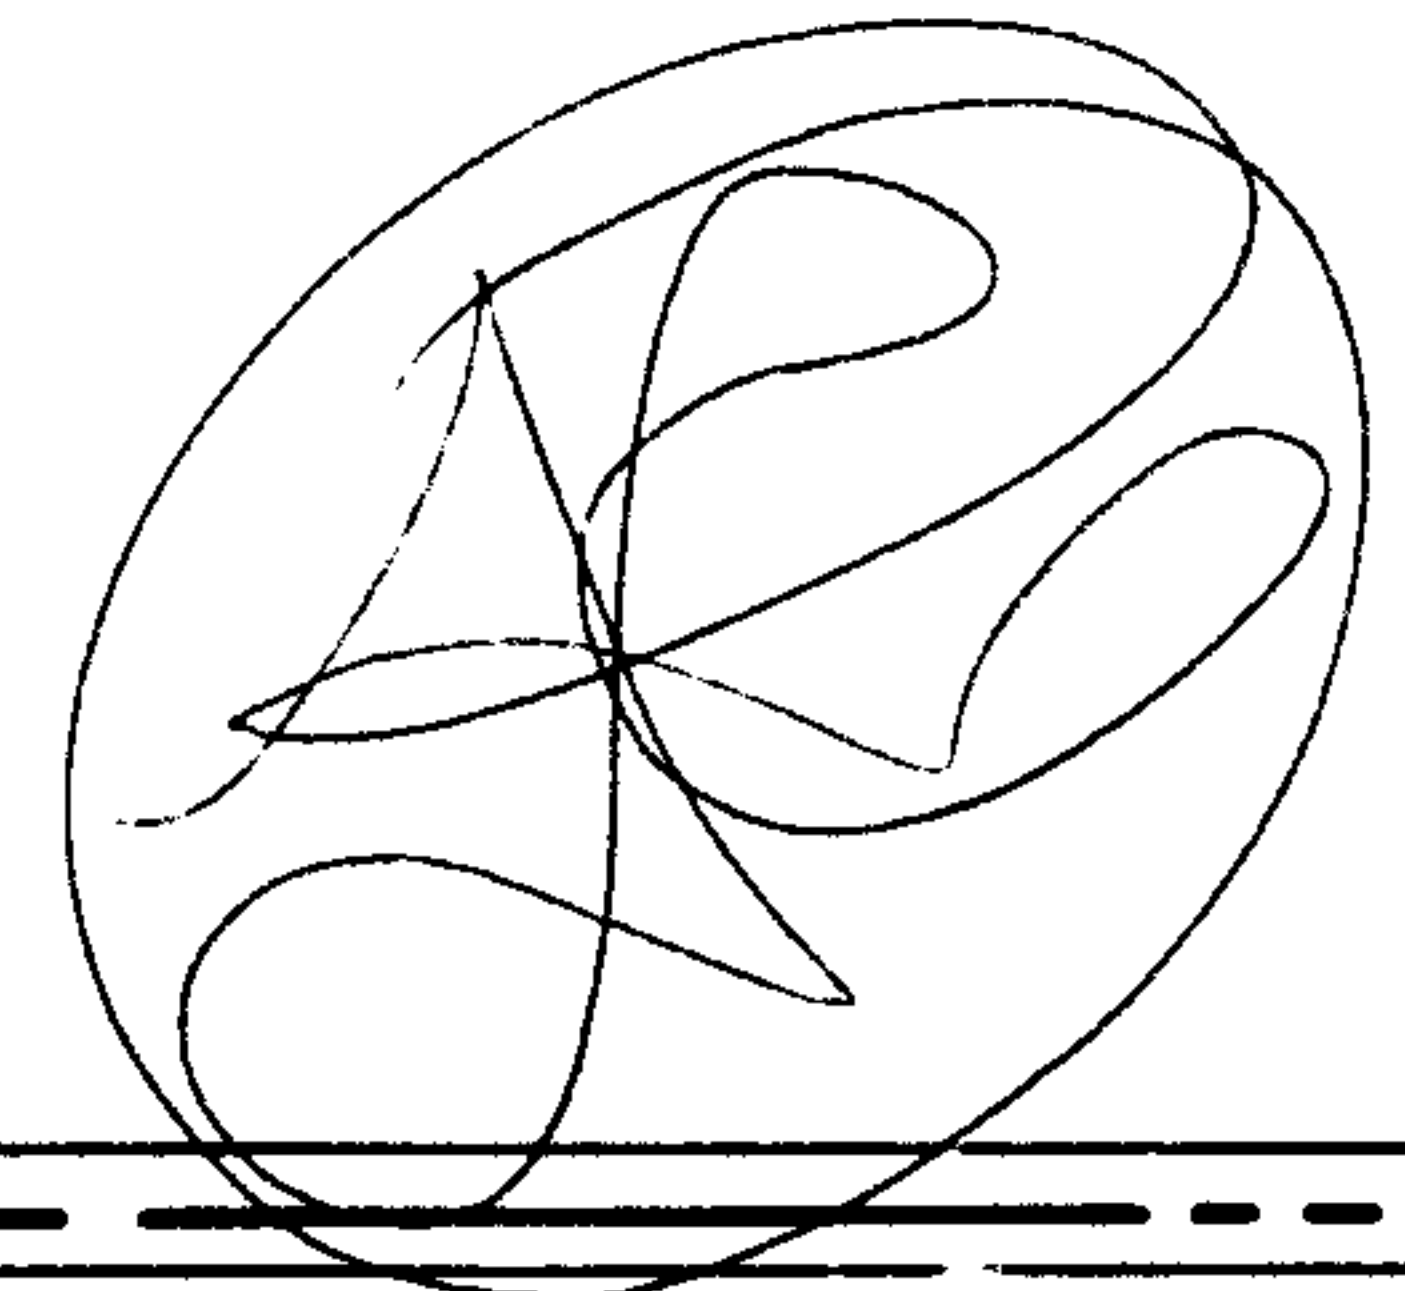

-019
10.33A
RD.

262
-013
1.44A
262

PT. 12-00-050-000-010
PT. 37.69A

APPROVED
LORAIN CO.
MAP DEPT.
DATE 1/17/72
12-F
BY R.V. Kelling

9/10/77
J

P. SCALE 1" = 400'

LOTS 5' THRU 55, 66 THRU 70