


5813

#5813


-009  
1.16 A.

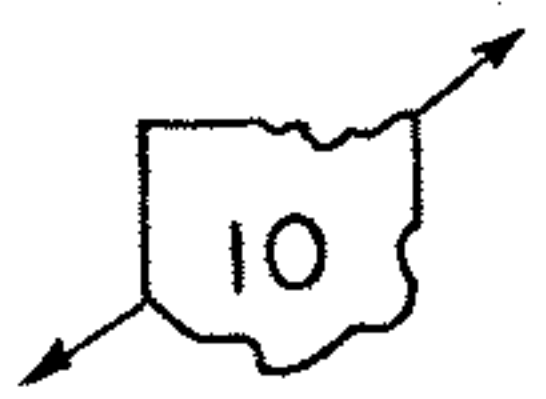

RIDGE


BUTTERNUT  
.74 A.

90 0 LRD.

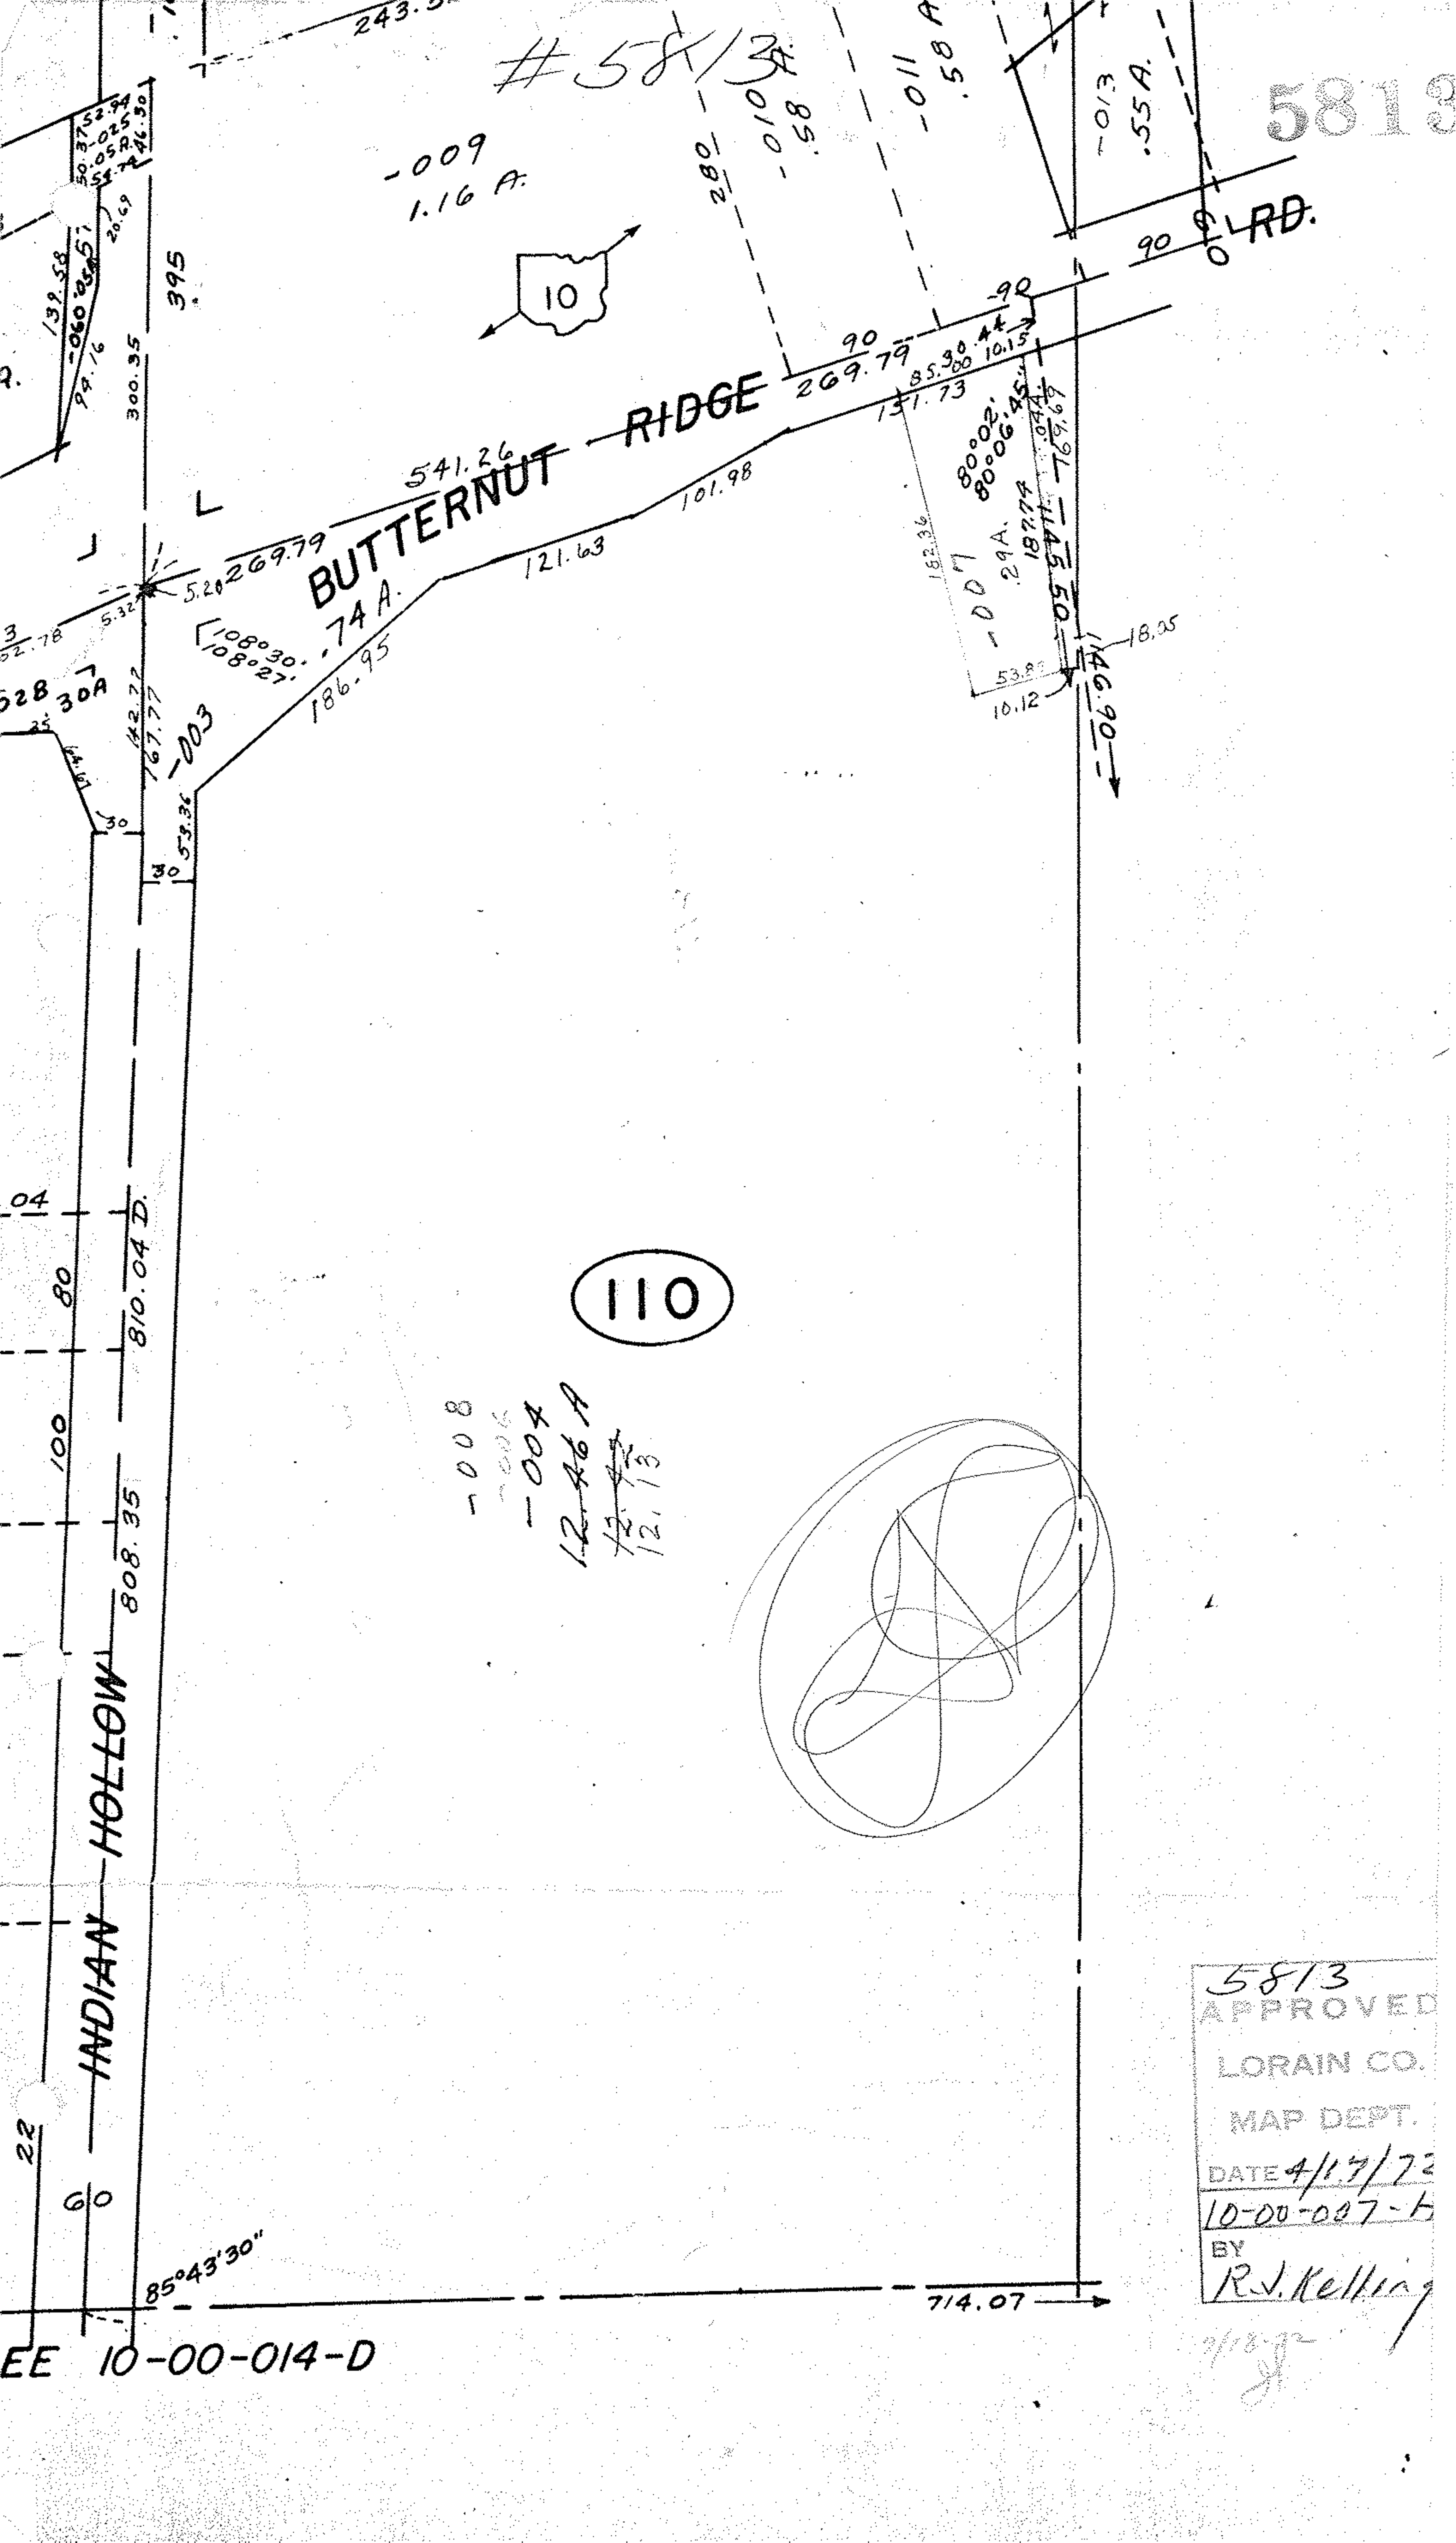

110

-008  
-006  
-004  
12.16 A  
~~12.13~~  
12.13

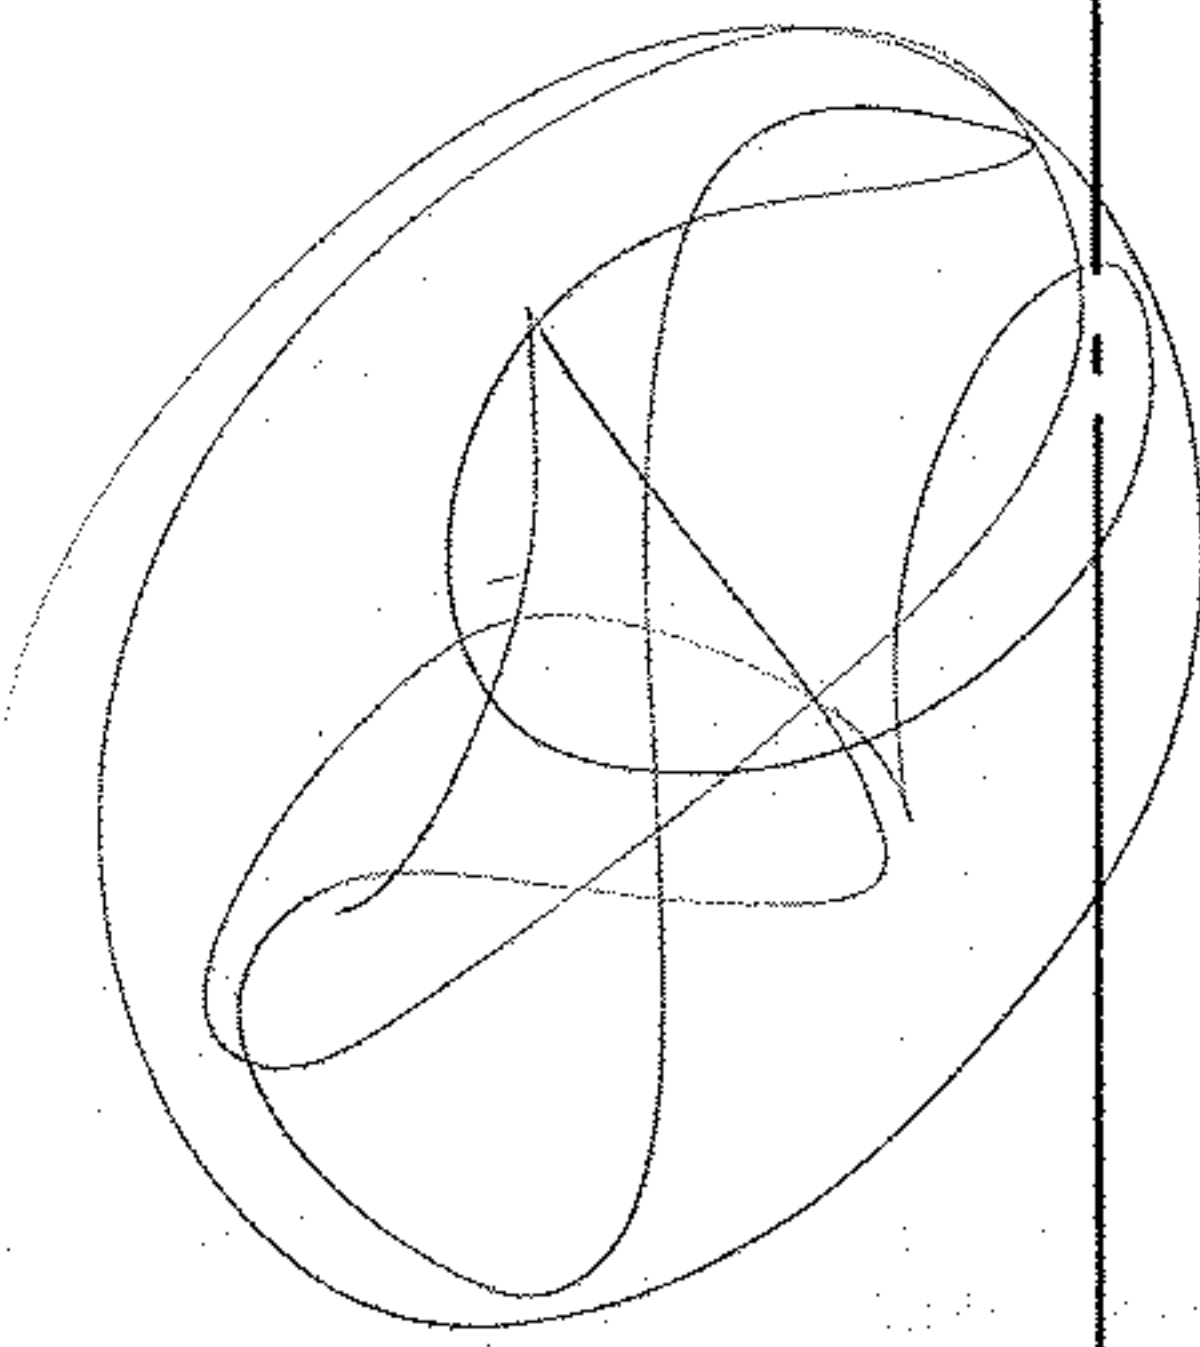

5813  
APPROVED  
LORAIN CO.  
MAP DEPT.  
DATE 4/17/72  
10-00-007-H  
BY  
R.J. Kelling

EE 10-00-014-D

714.07

7/10/72