


**APPROVED**  
**LORAIN CO.**  
**MAP DEPT.**  
 DATE 9/14/72  
 BY [Signature]

9/13-72  
 [Signature]

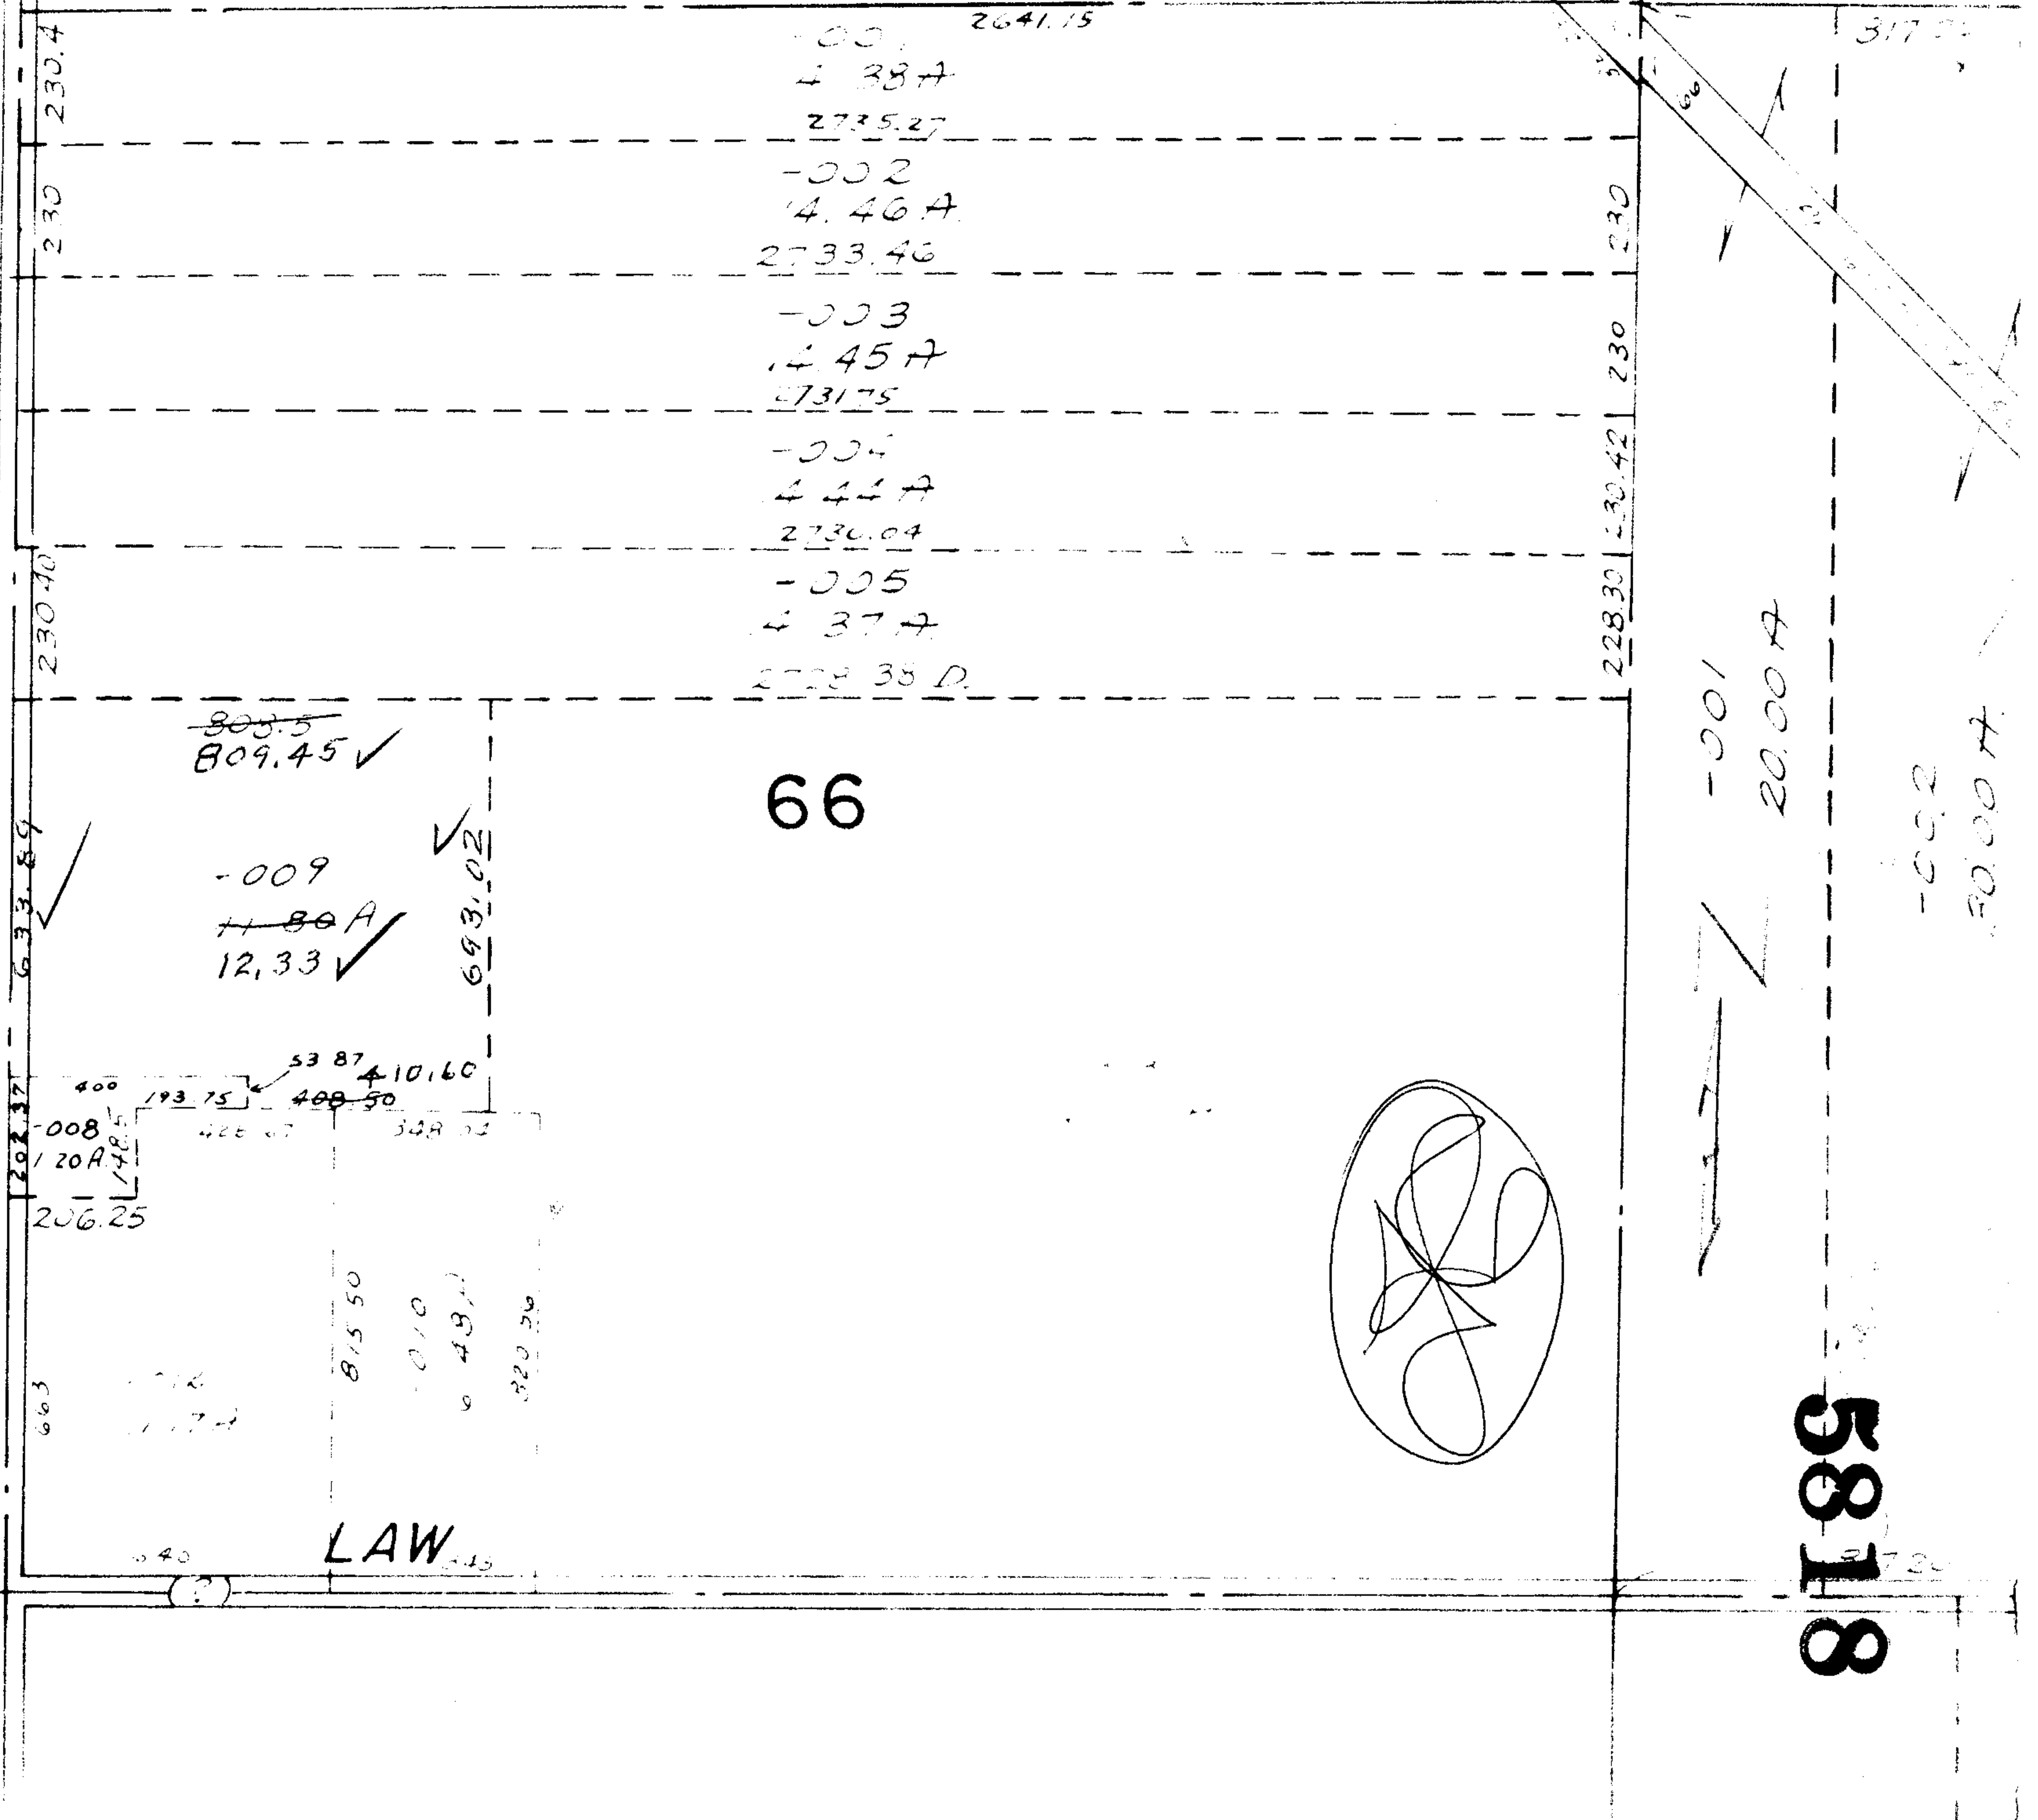

5818