


5823


-026
.46 A

-031

45.34

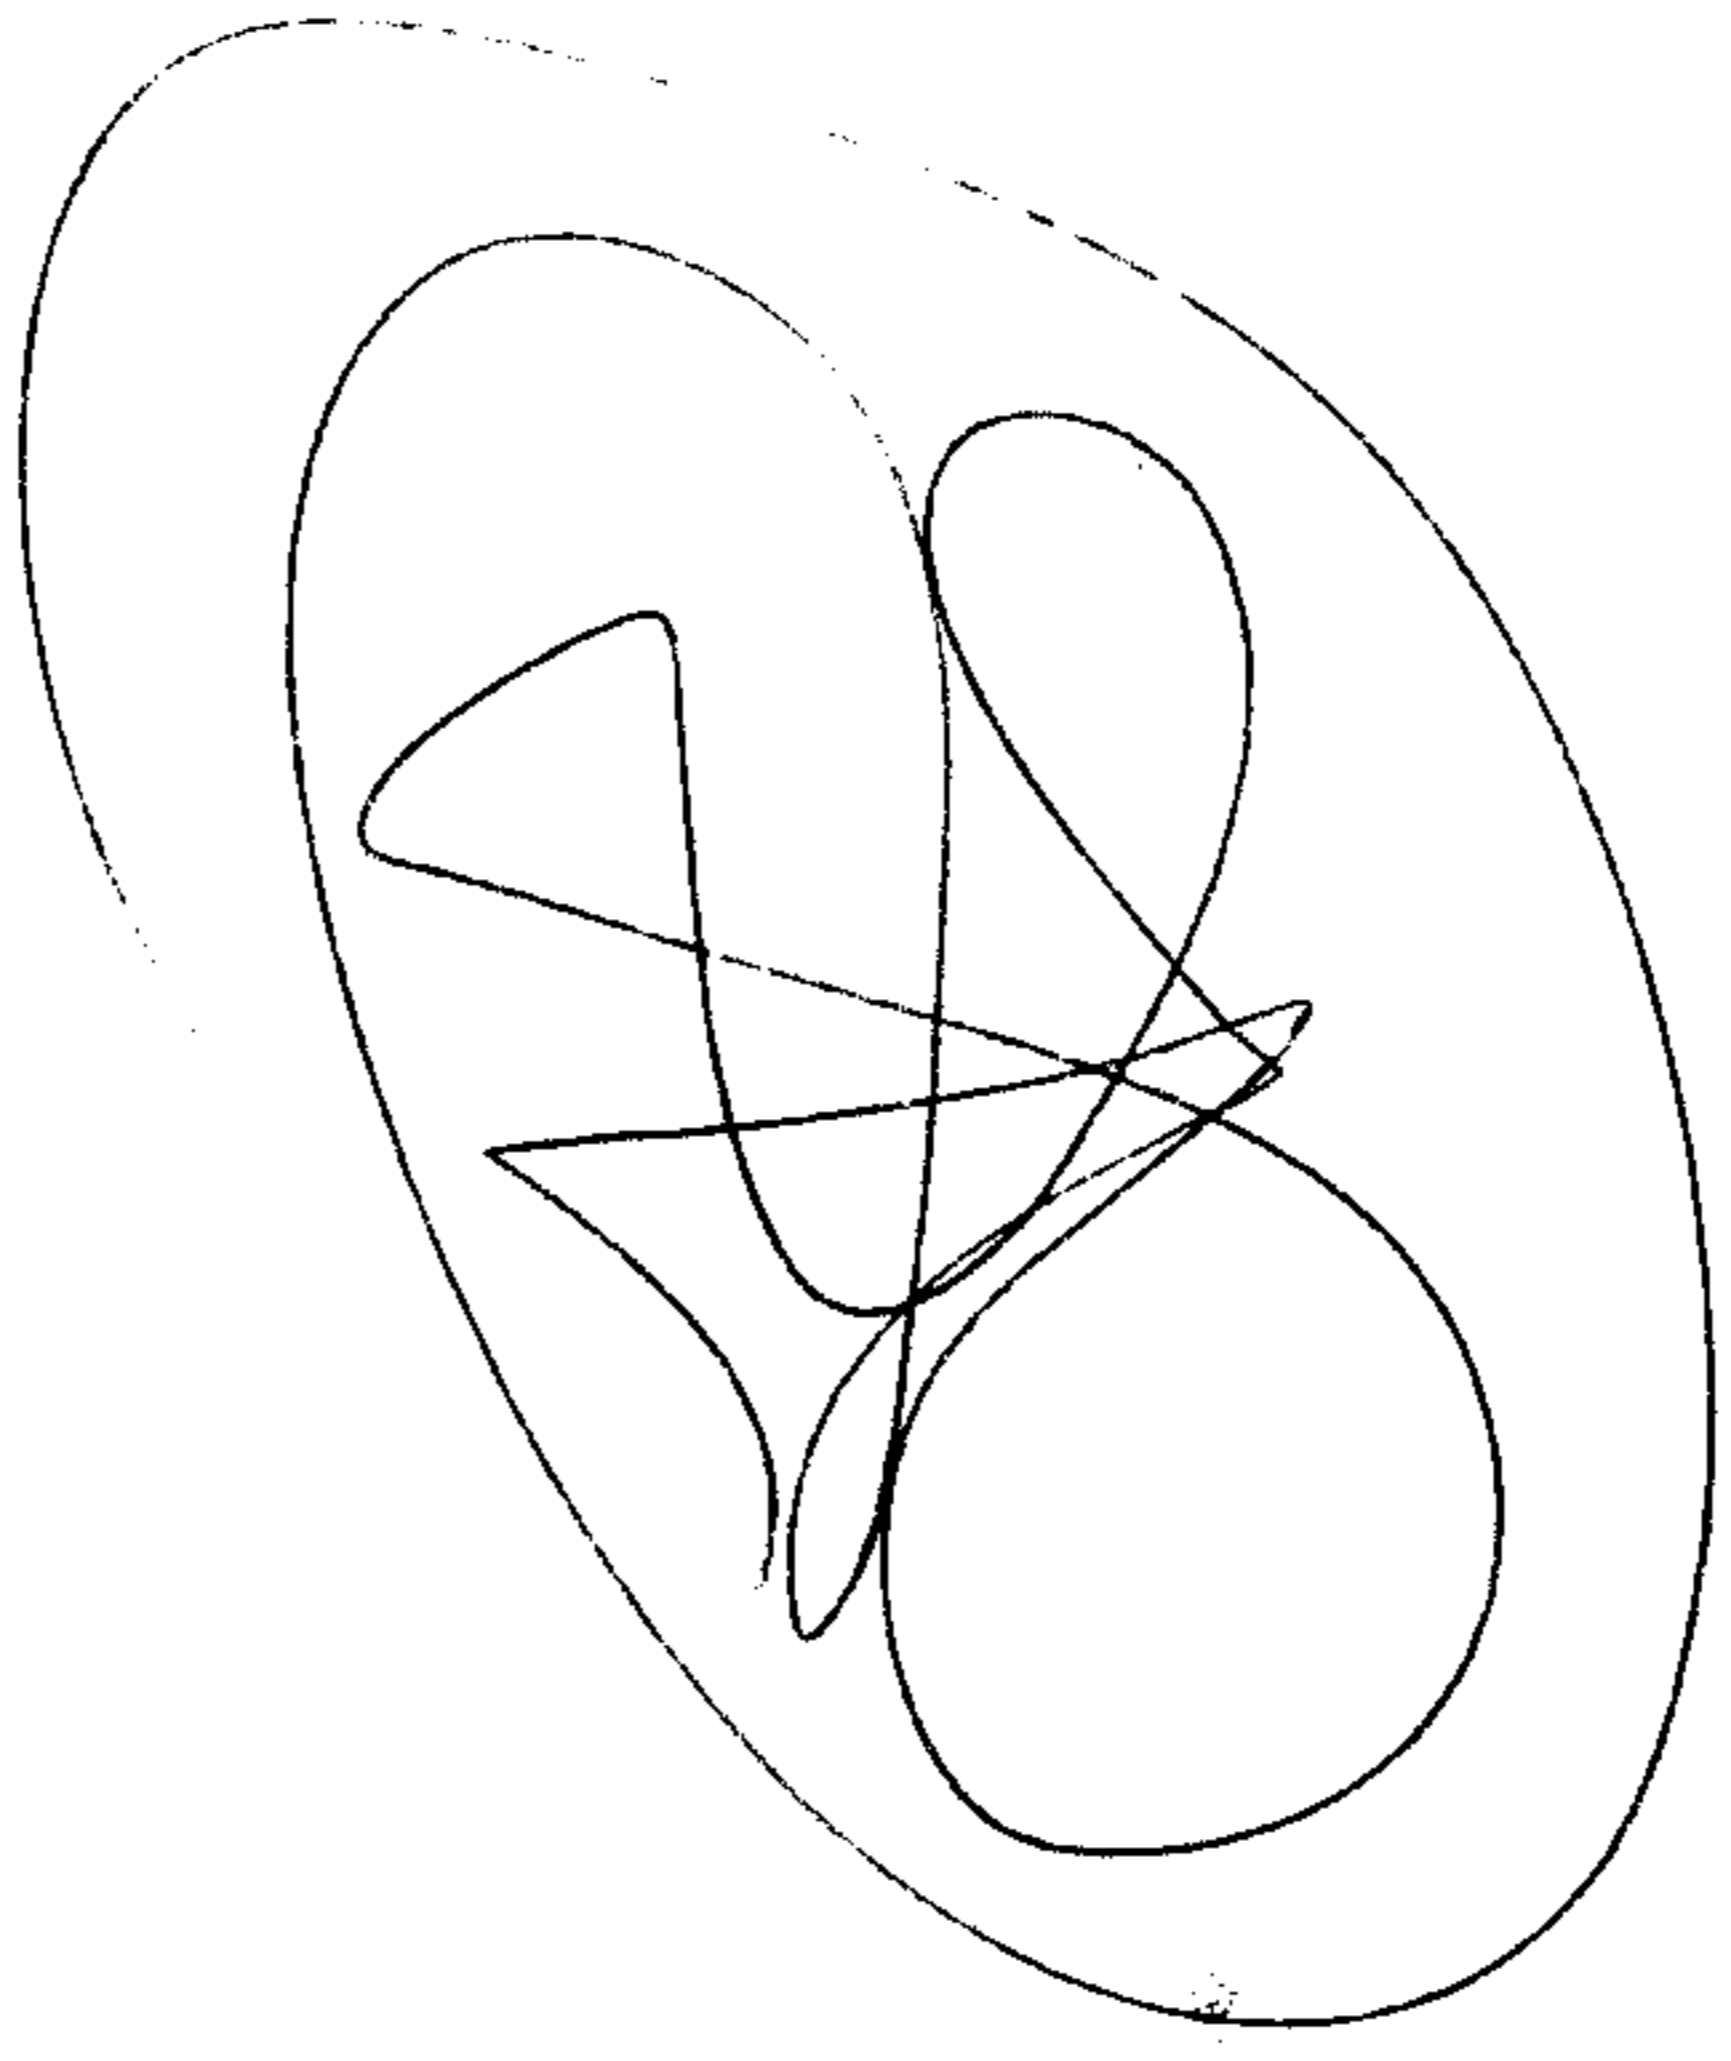

QUARRY

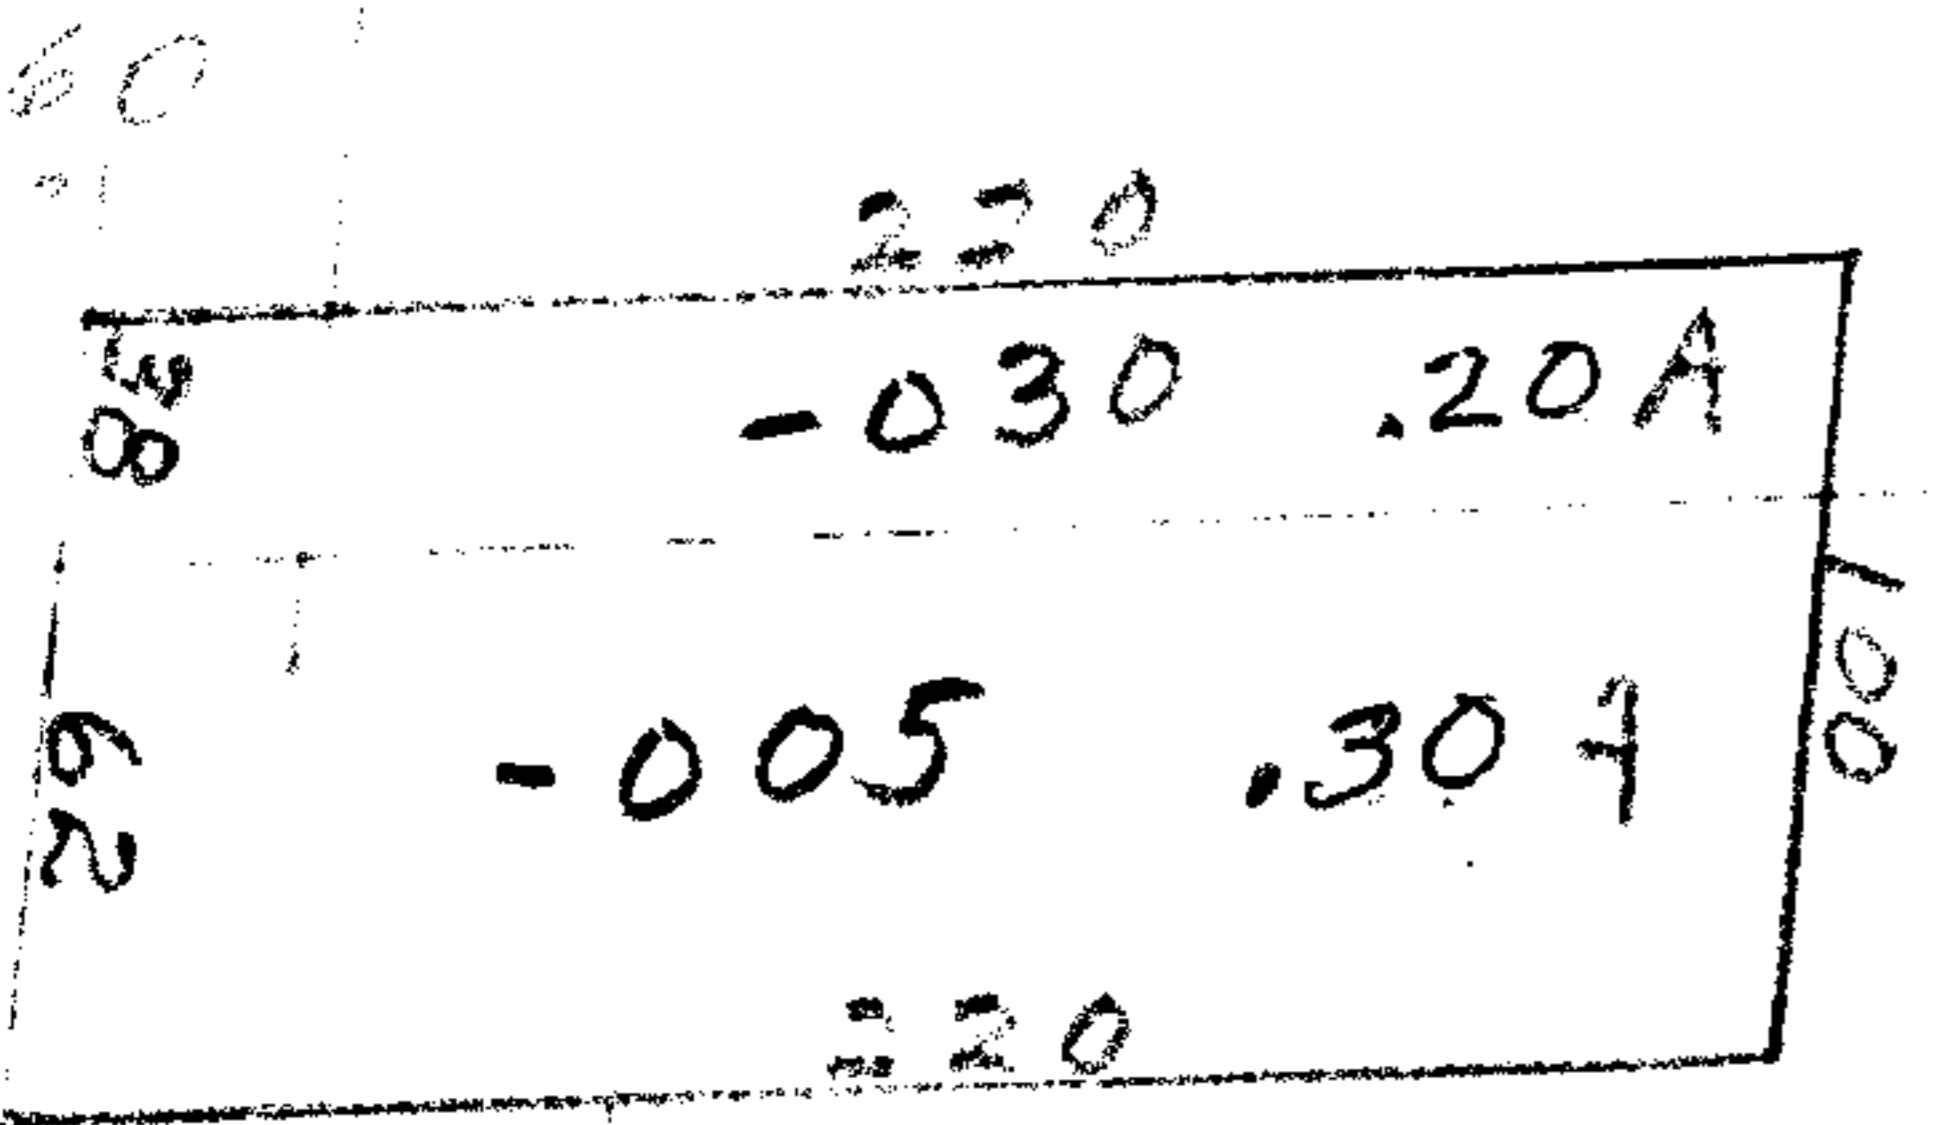

09-00-012-000-
-006
4.70 A

OL2
OL12
9-4

Move line to ...

09-00-012-000-001
~~5.60 A~~

APPROVED
LORAIN CO.
MAP DEPT.
DATE 4/20/72
9-00-002-A + 9-A
BY P. J. Kelley W

SEE
8.7.00.2

9/18-72

RUSSIA TWP.

SCALE: 1" = 100'