

SEE 11-A

RD.


11-00-071A

030
73A


CHESTNUT RIDGE

5830

APPROVED
LORAIN CO.
MAP DEPT.
DATE 11-24-72
BY LWH/A

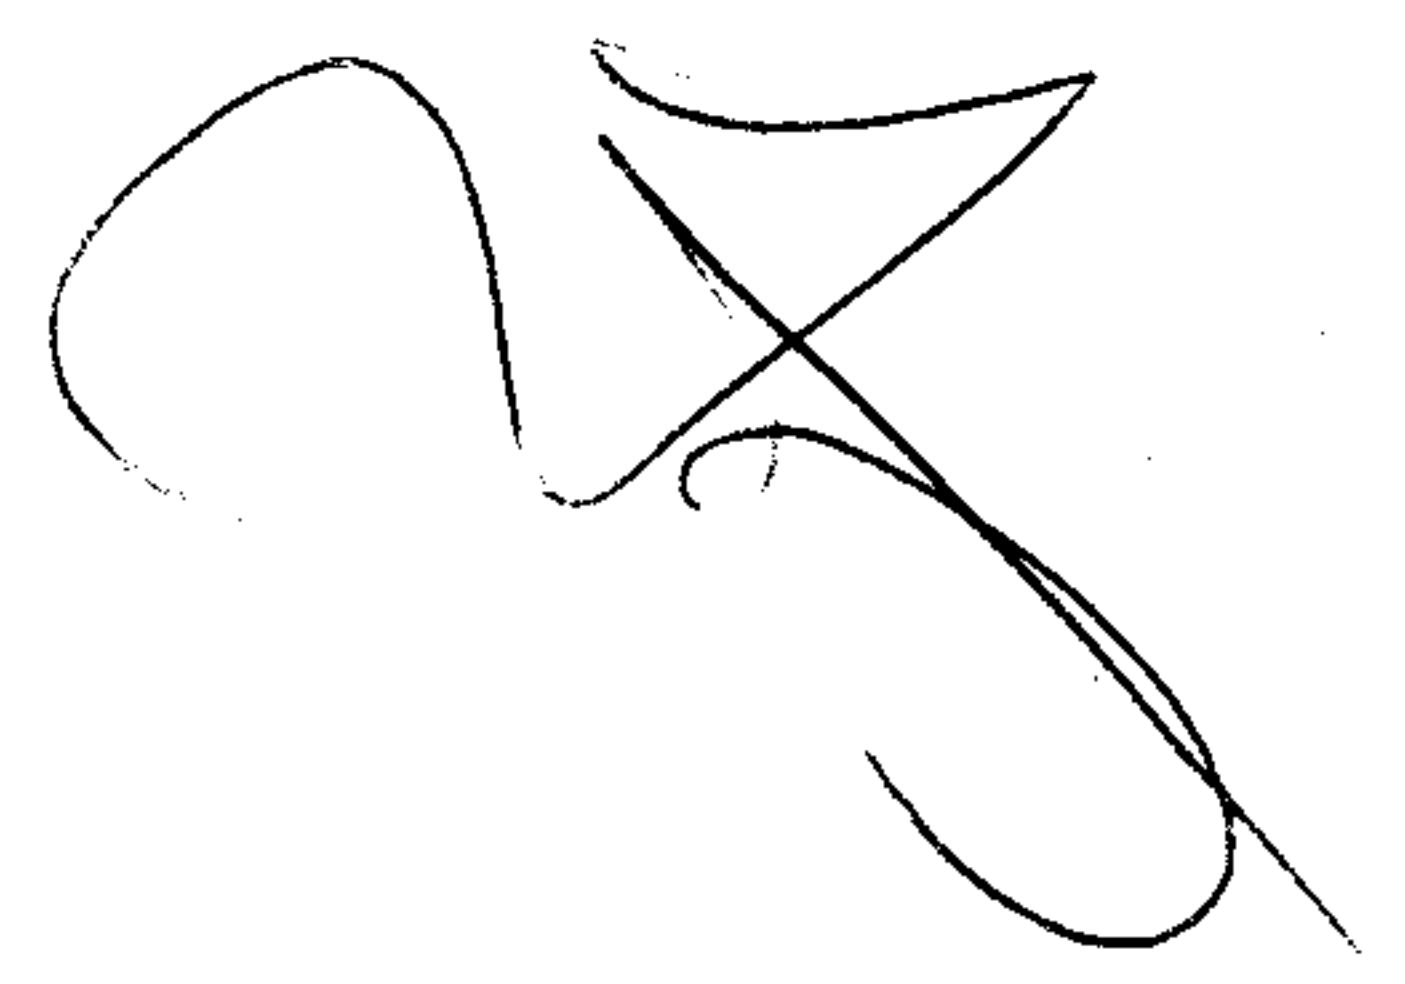

038
~~036~~
5492
54.79

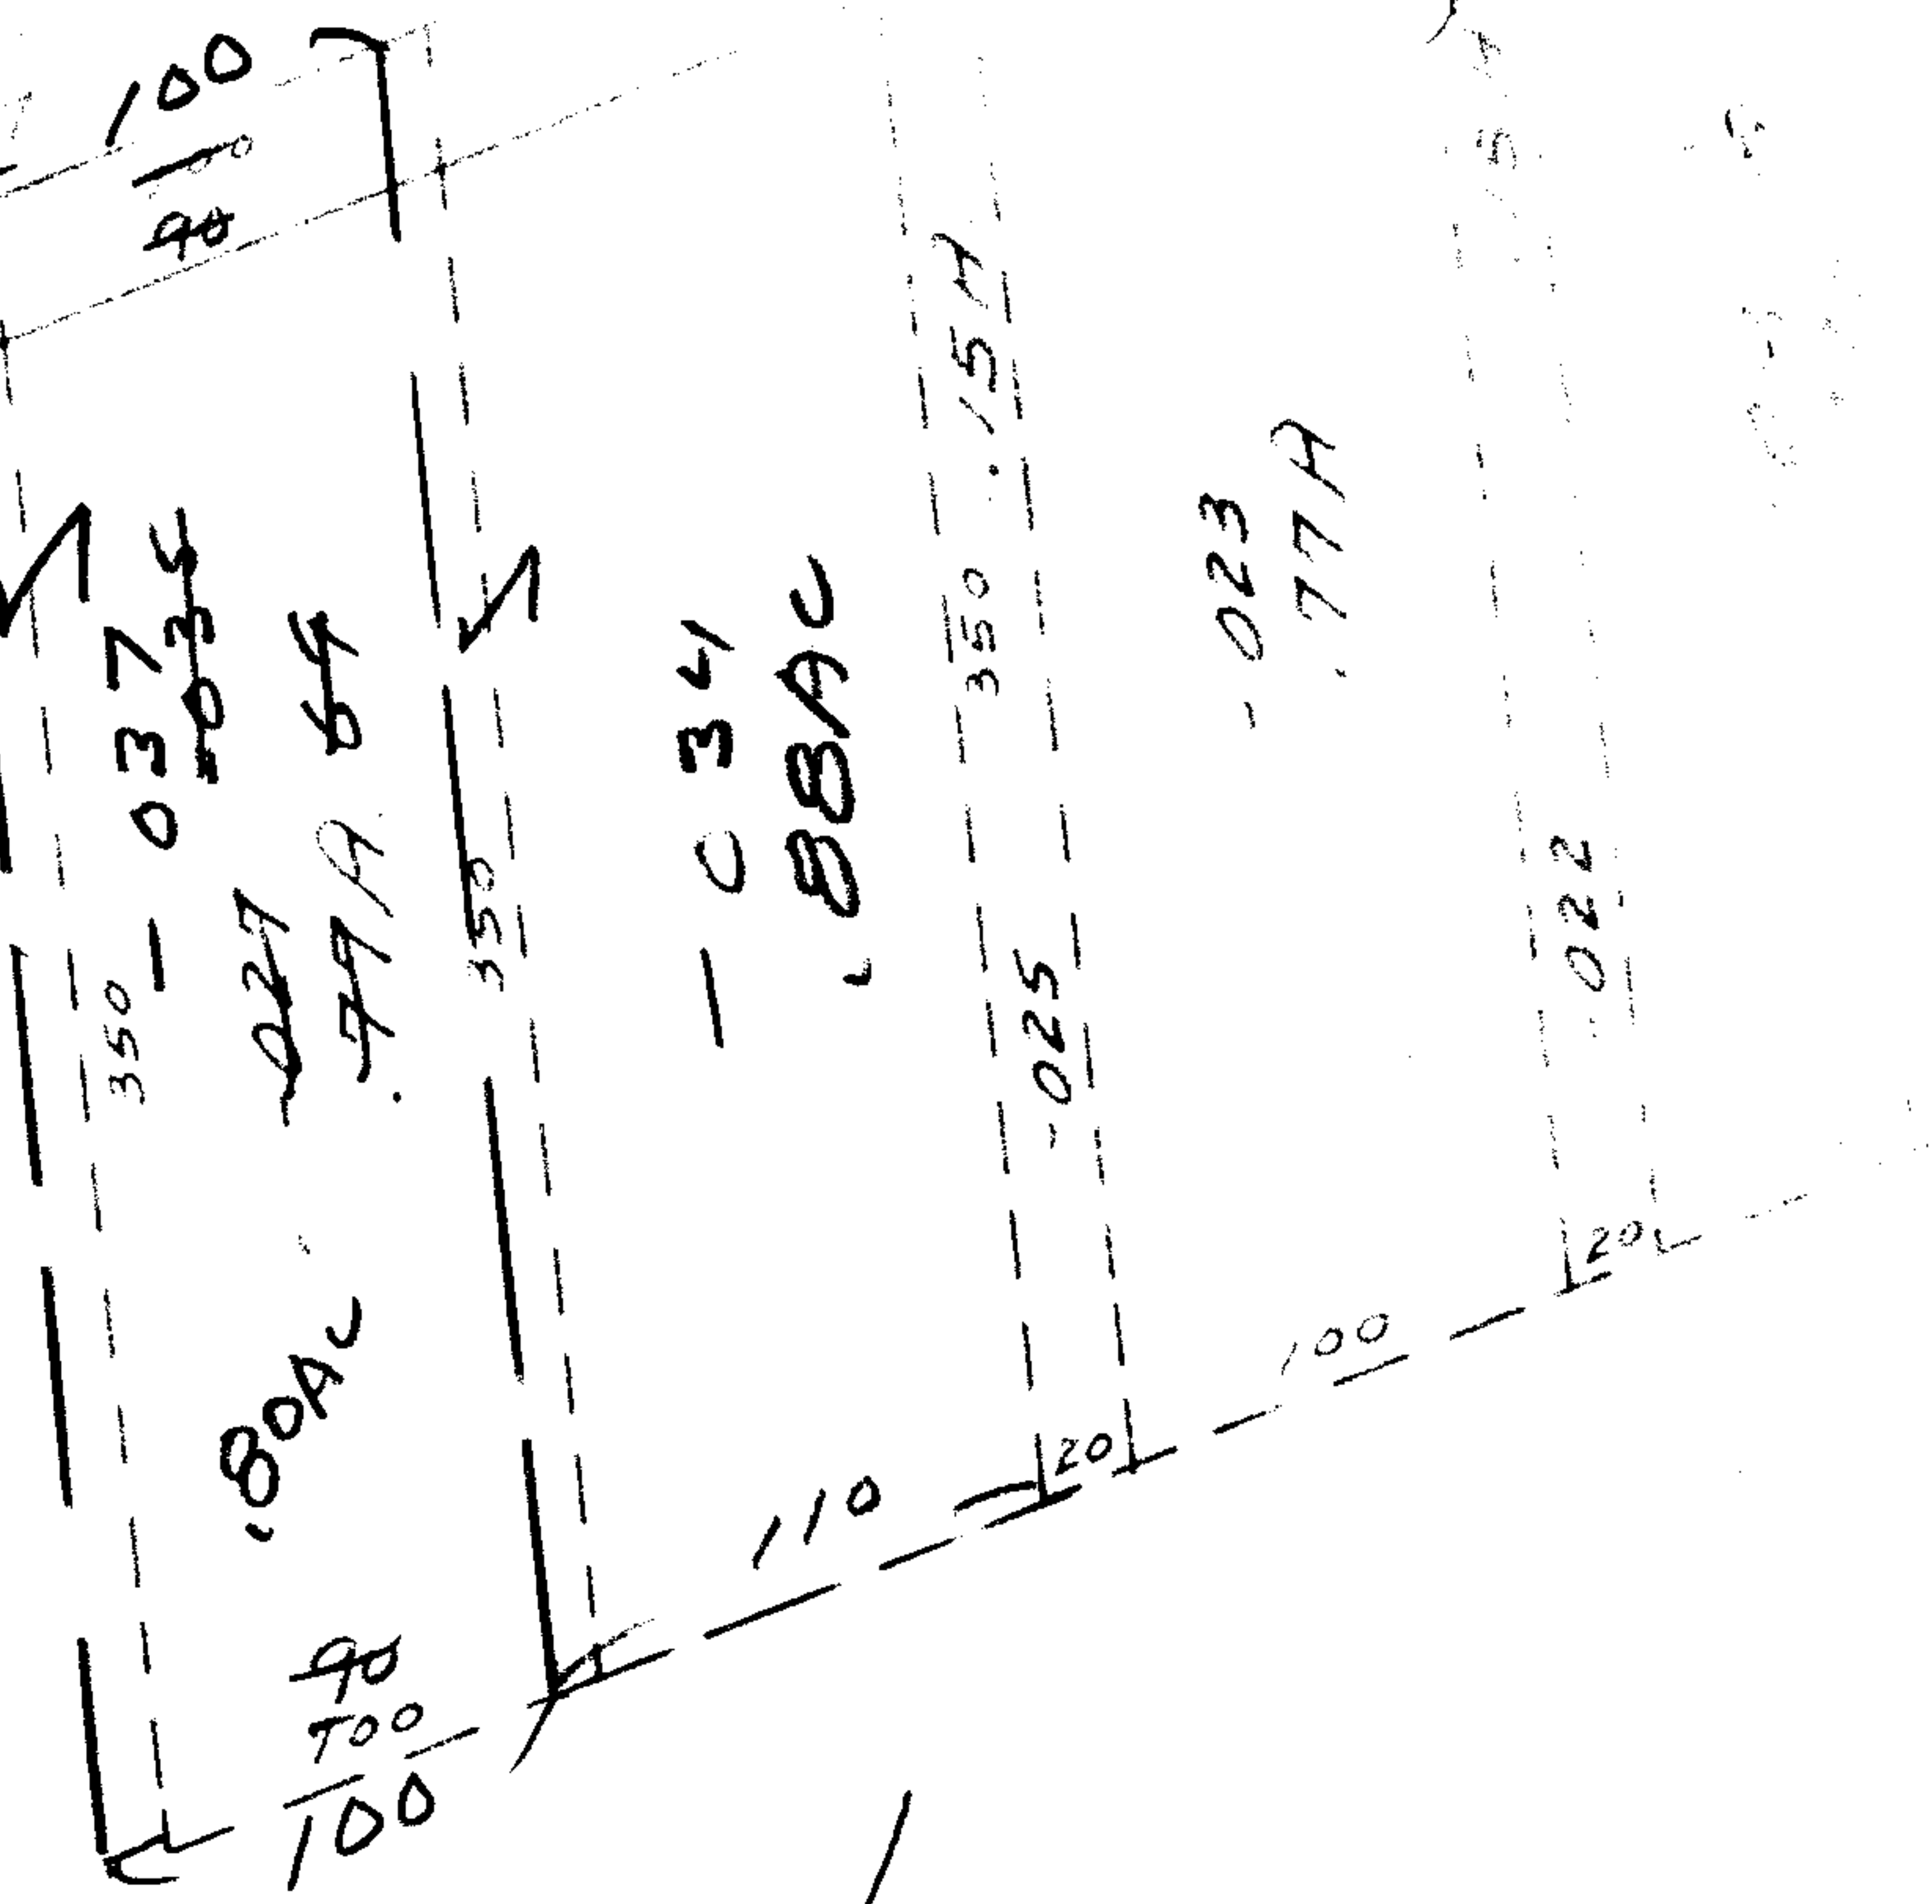

5830
A