

56

JONES

5835

(60?)

N

A

-004
33.00 A

330

70.65

-003
5.00 A

670.20

320

-001
40.00 A

A


-001

57

R

T

-004 ✓
-002
~~56.00 R.~~
54.50

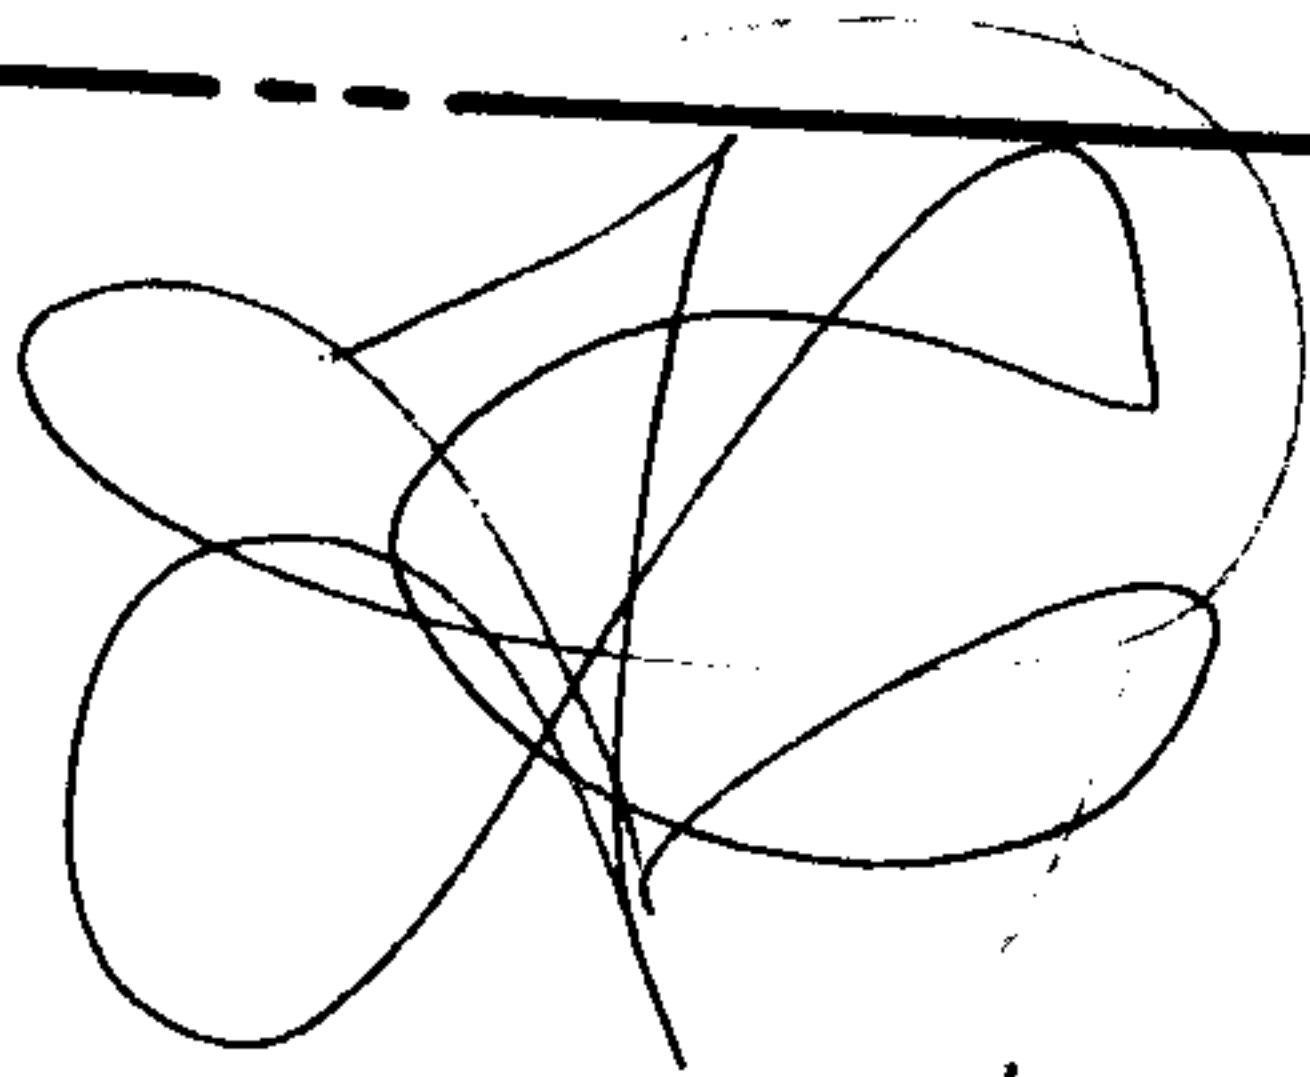

735 ✓
-005 ✓
1.50 A
43.50

1570

1320

d. s. 7-28

APPROVED	
LORAIN CO.	
MAP DEPT.	
DATE	4/25/72
	19-H
BY	R. J. Kelling

7/18-72

-001
91.71 A.

62