

5837

APPROVED
LORAIN CO.
MAP DEPT.
DATE 4/25/72
14-H
BY R. L. Kellum

7-2886 h.h.

9/8/72

-005
48 00A.

$$188 \times 233.40 = 43,899.20$$

$$43,560 = 1.01 \text{ AC}$$

223.40
195.05
1.00 AC
233.40

Check
DU59
P447

587.85

59
447.99
-002
257

1140

-004
20.49



139


-003 ✓
-001
94.50 F.
74.01 ✓

94.50
20.49
74.01

821.85

$$1140 \times 821.55 =$$

936,909	21.51 AC
41,356	20.49
	1.01

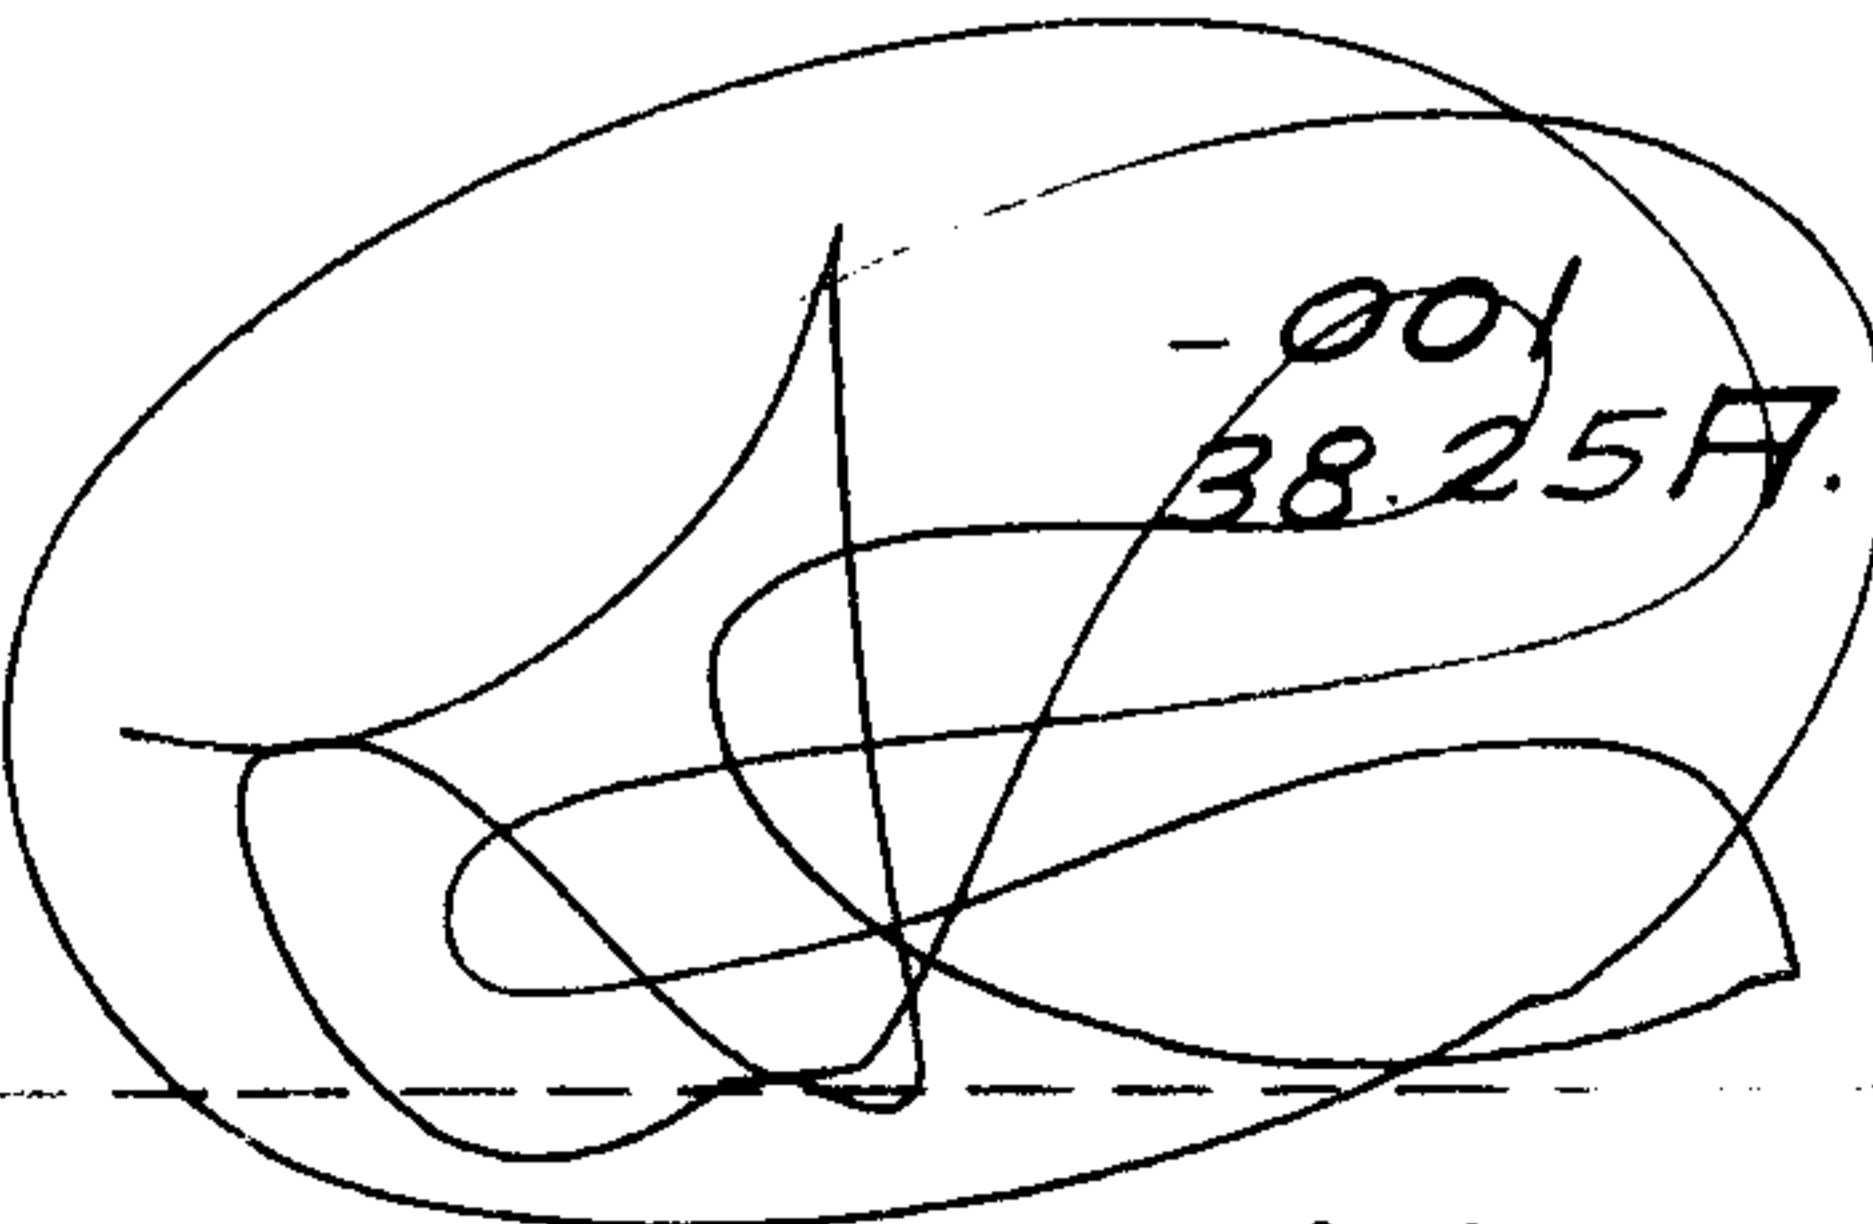

142

#5837

21.11.12

#5838