


5840

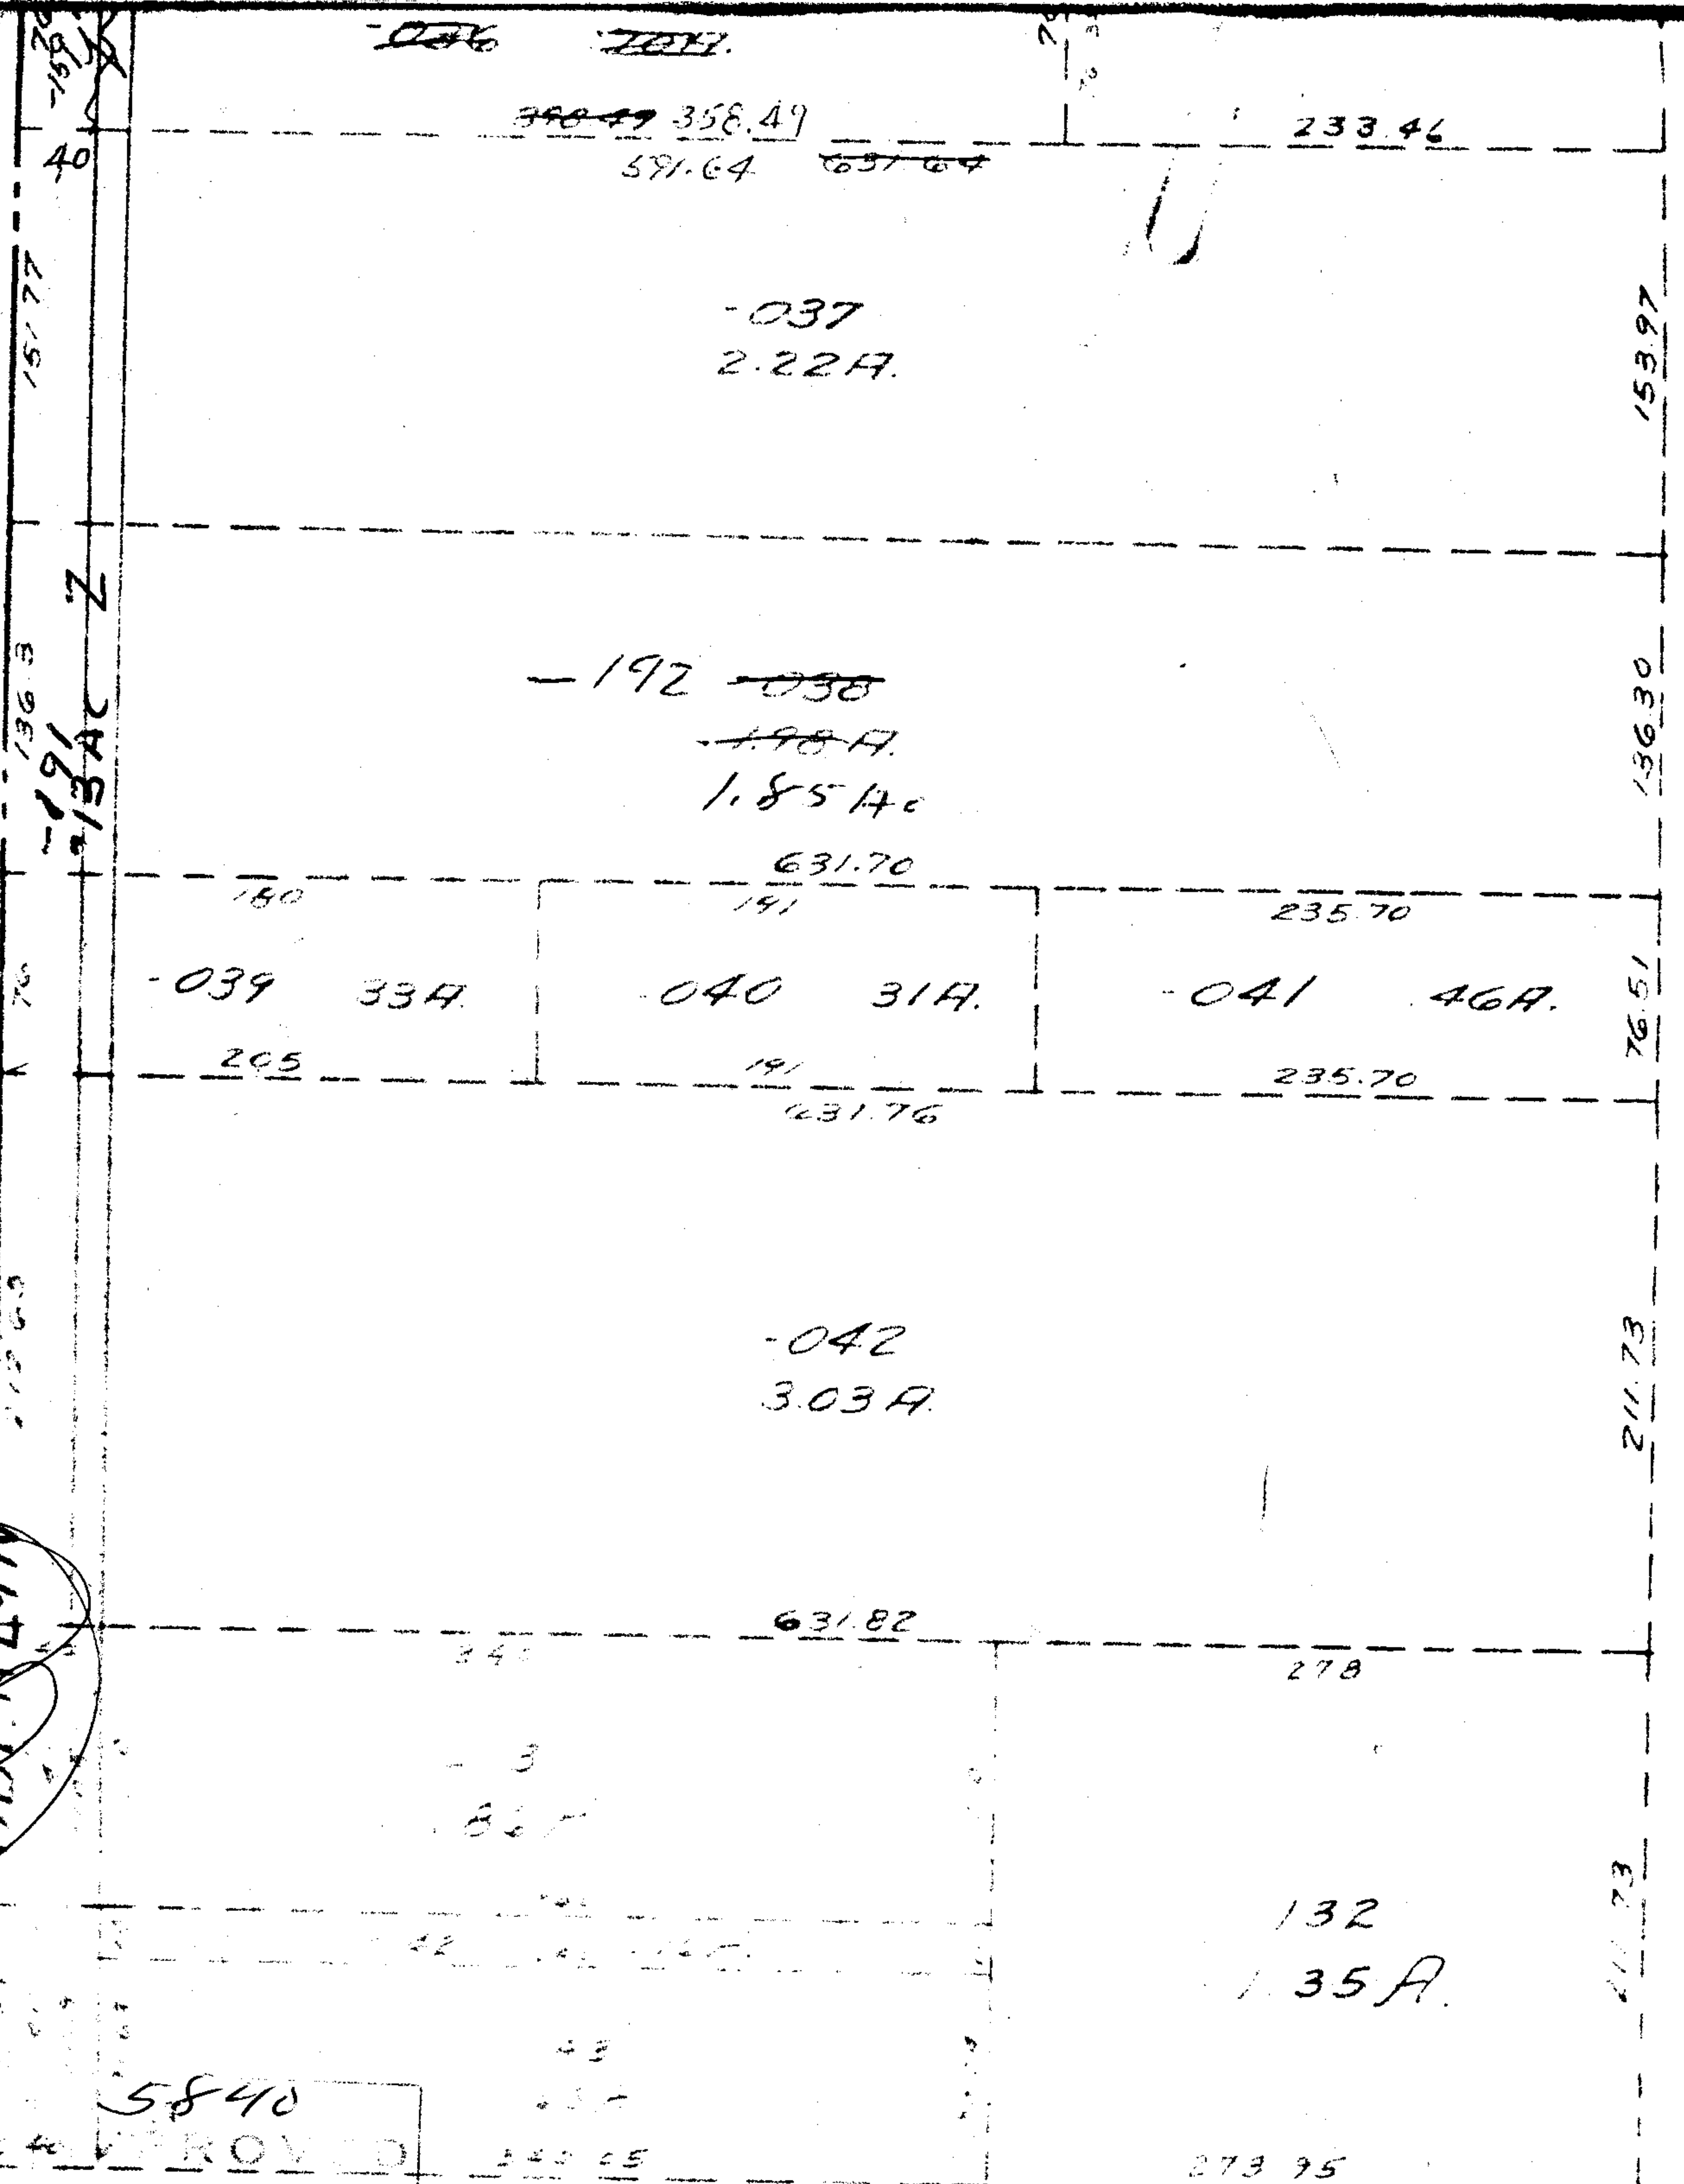

(Handwritten signature in a circle)

5840
 APPROVED
 LORAIN CO.
 MAP DEPT.
 DATE 5-1-72
 2-01-008A
 BY L.W. Hall

7-18-86
 S.S. 5-1-72

SEE 2-

BLACK RIVER TWP.

2-01-008A

SCALE 1" = 100'