



MEMORIAL

004
CJ A. Dup.
77 A. D.

P4 - 060
P4 - 089
P4 - 34.43
33,56

5848

SEE 6-126

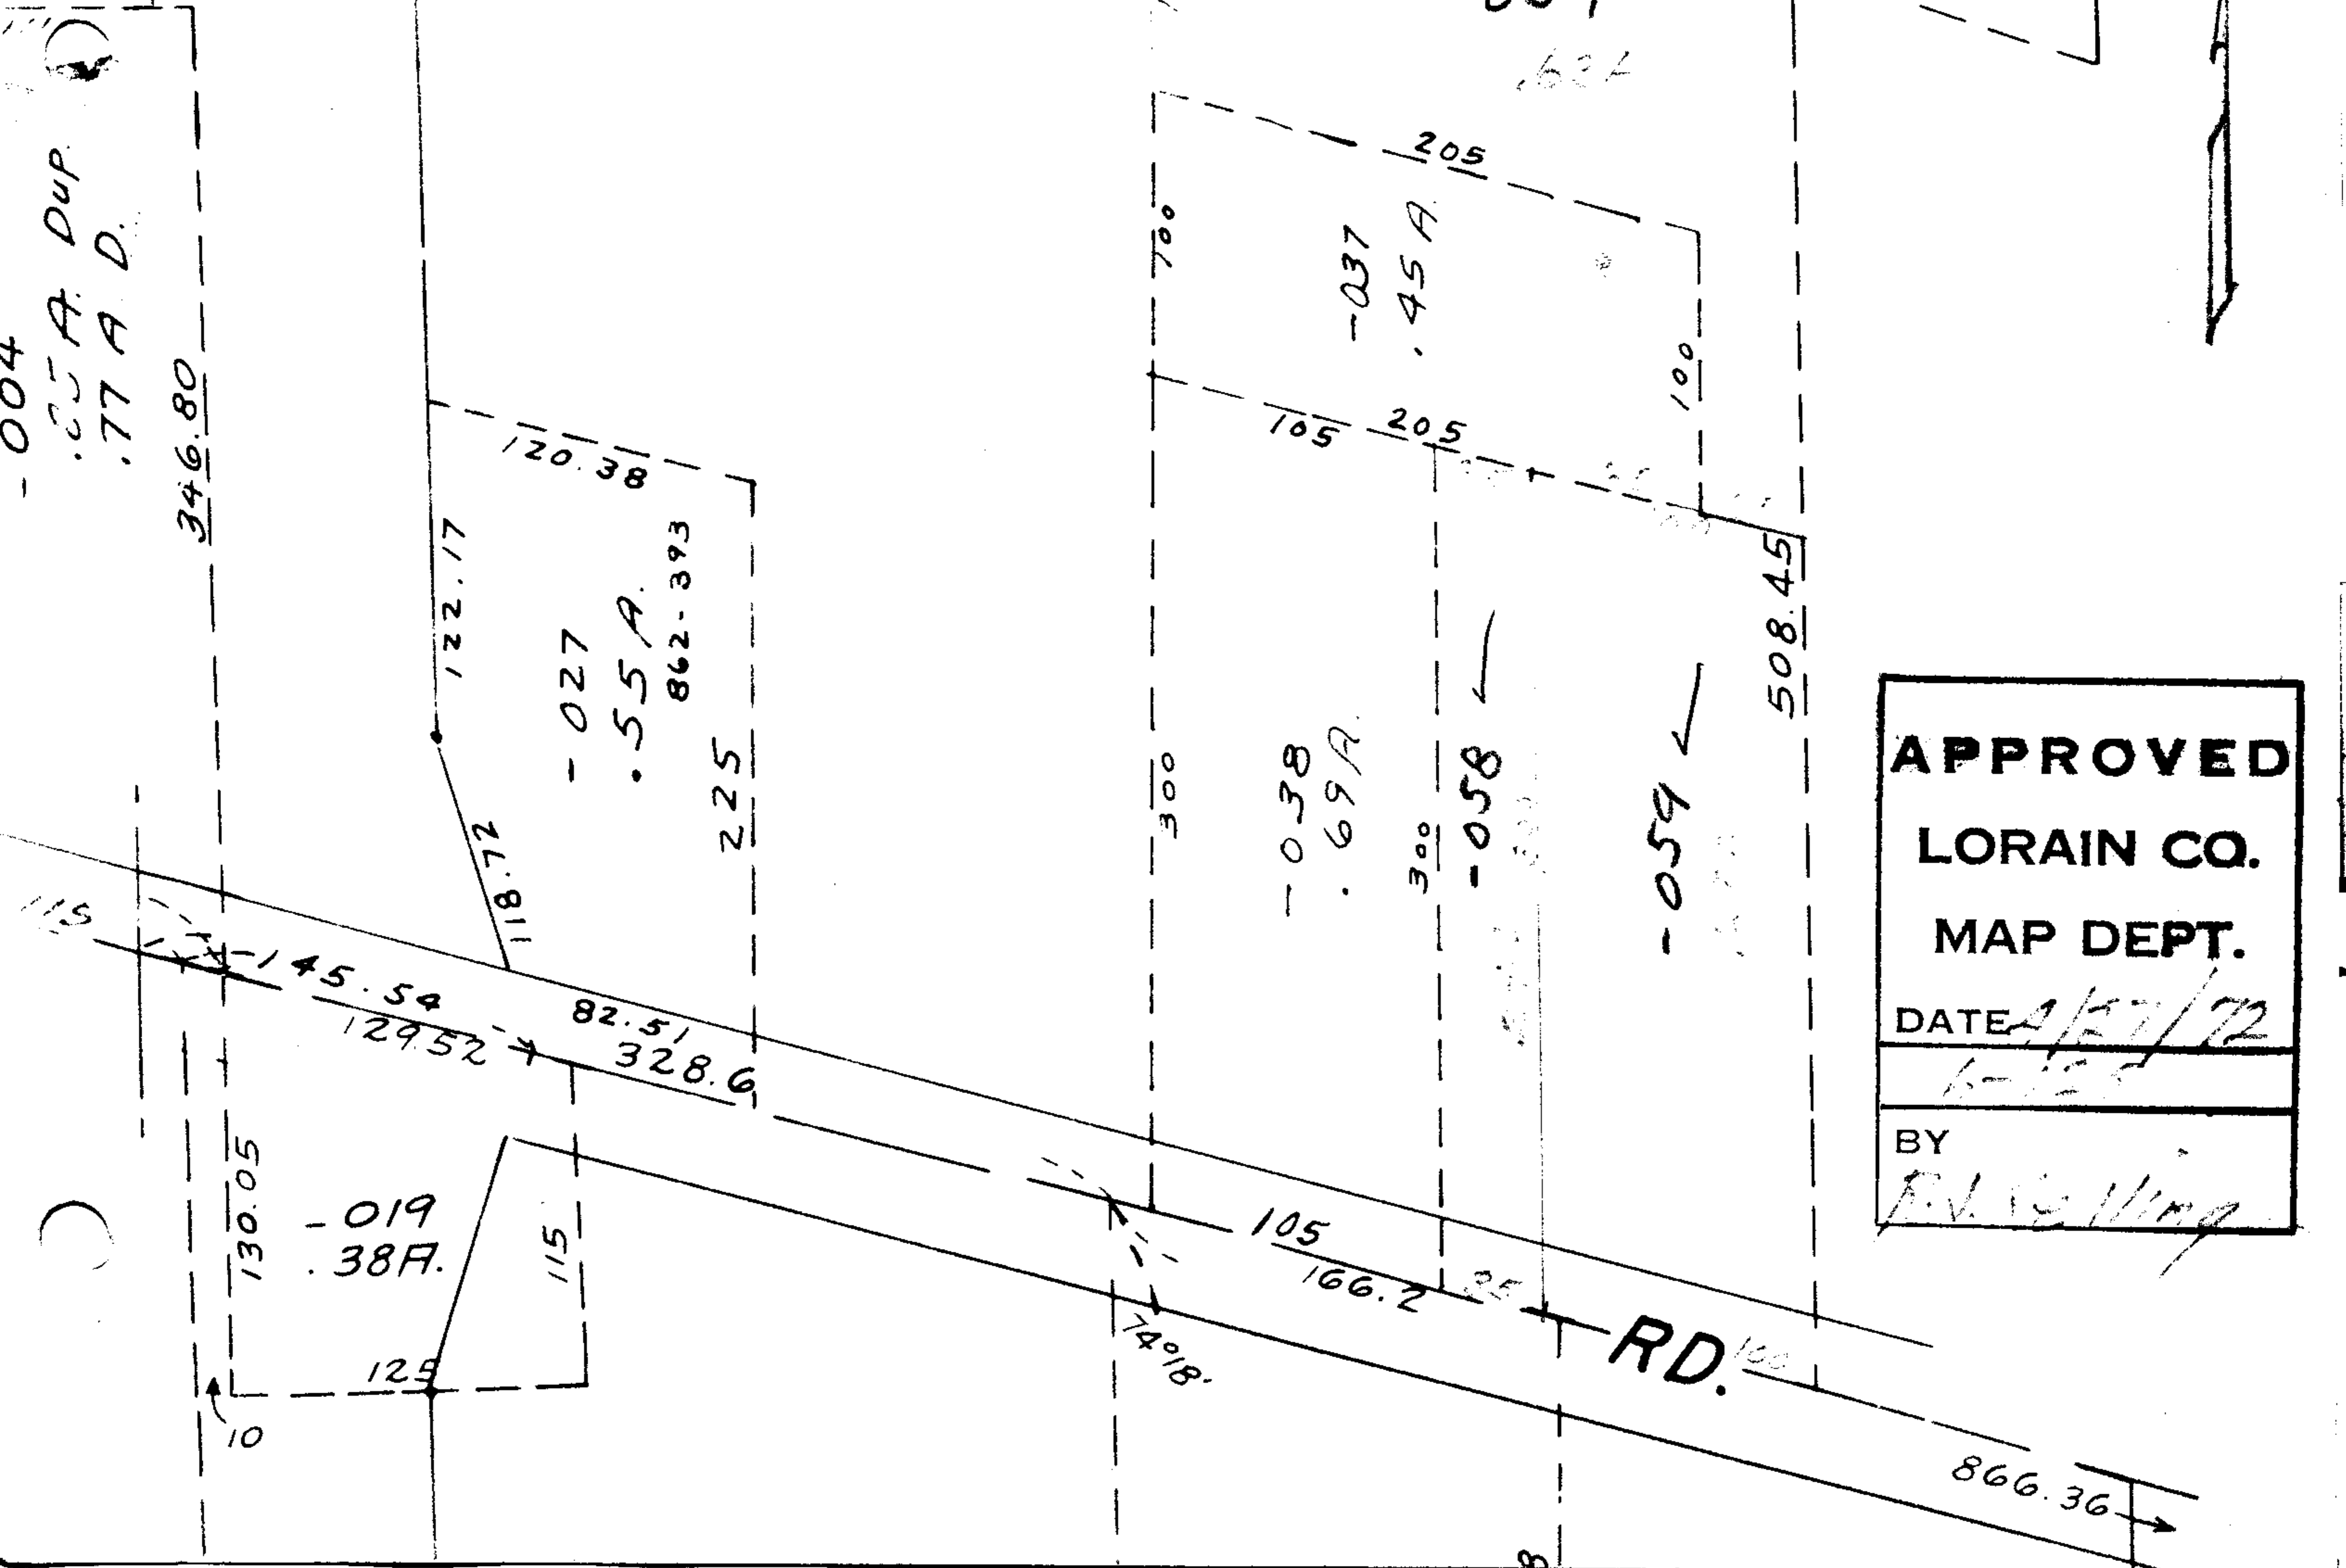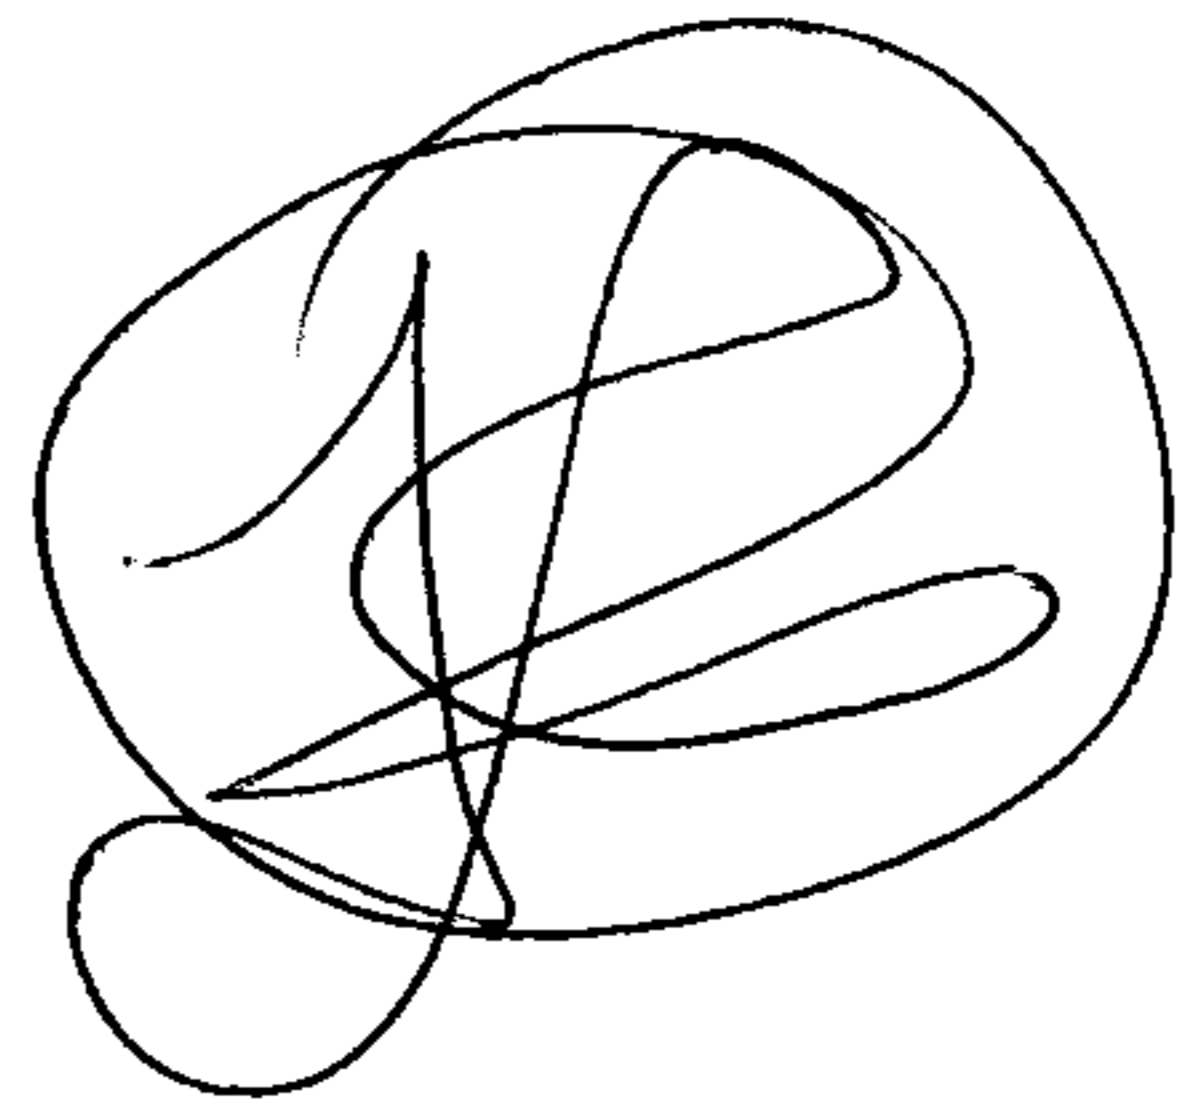

APPROVED
LORAIN CO.
MAP DEPT.
 DATE 9/27/72
6-126
 BY R.V. Hilling