

41	119.47
42-016	119.31
43-017	119.15
44-018	118.98
45-019	118.82
46-020	118.65
47-021	118.49
48-022	118.33
49-023	118.16
50-024	118
51-025	117.83
52-026	117.67
53-027	117.30

409.67

303

56.05

106

-004
5.38A


5849

Increase Ac. by Deed & Survey
Schmidt


Acreege Correction

-006
~~3.69A~~
4.00

574.13
~~569.58~~

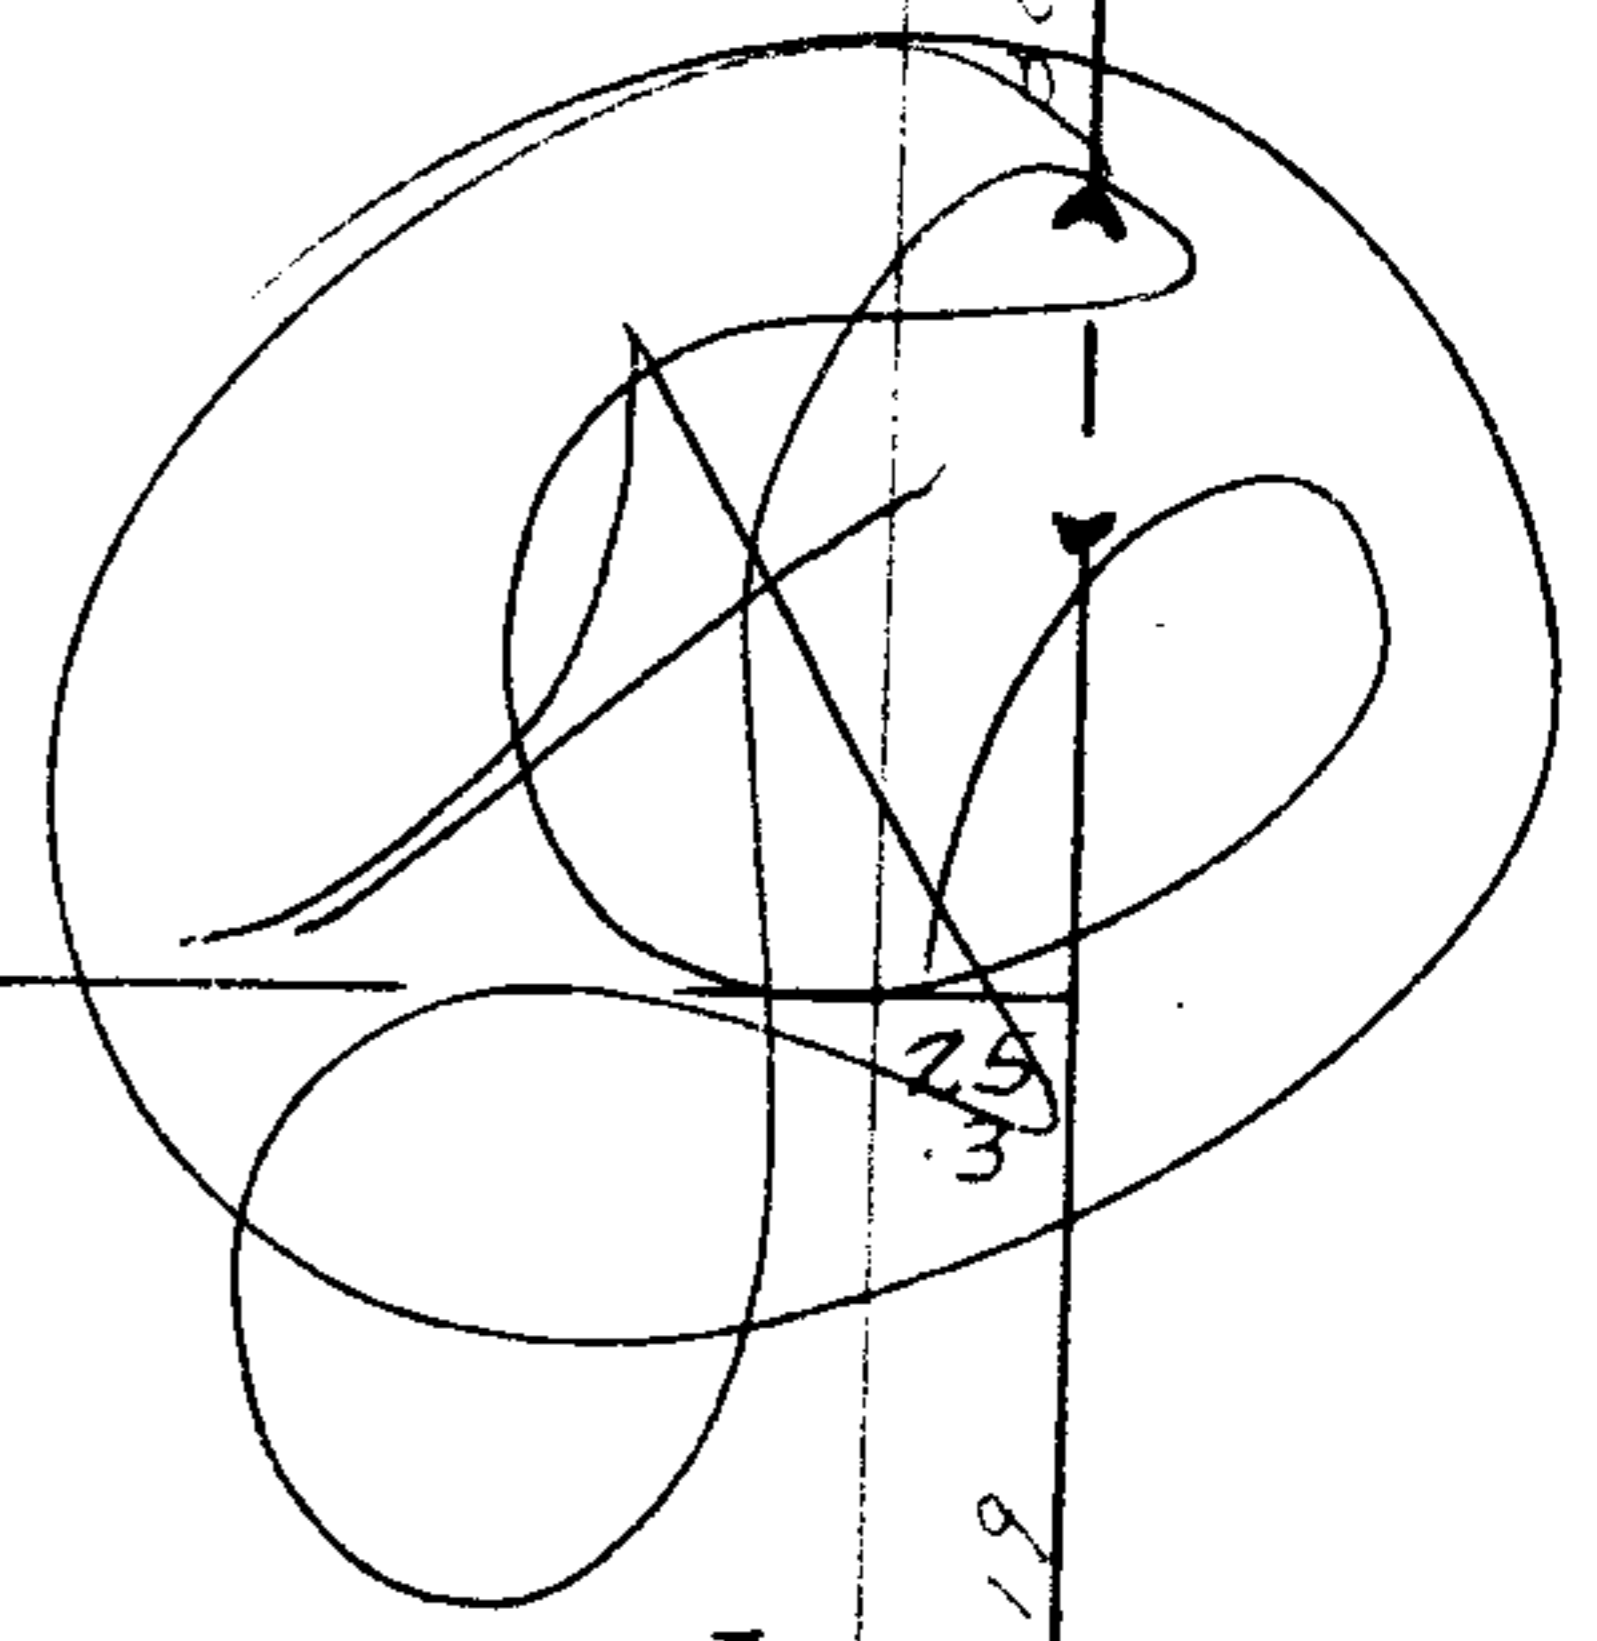

LUGAN

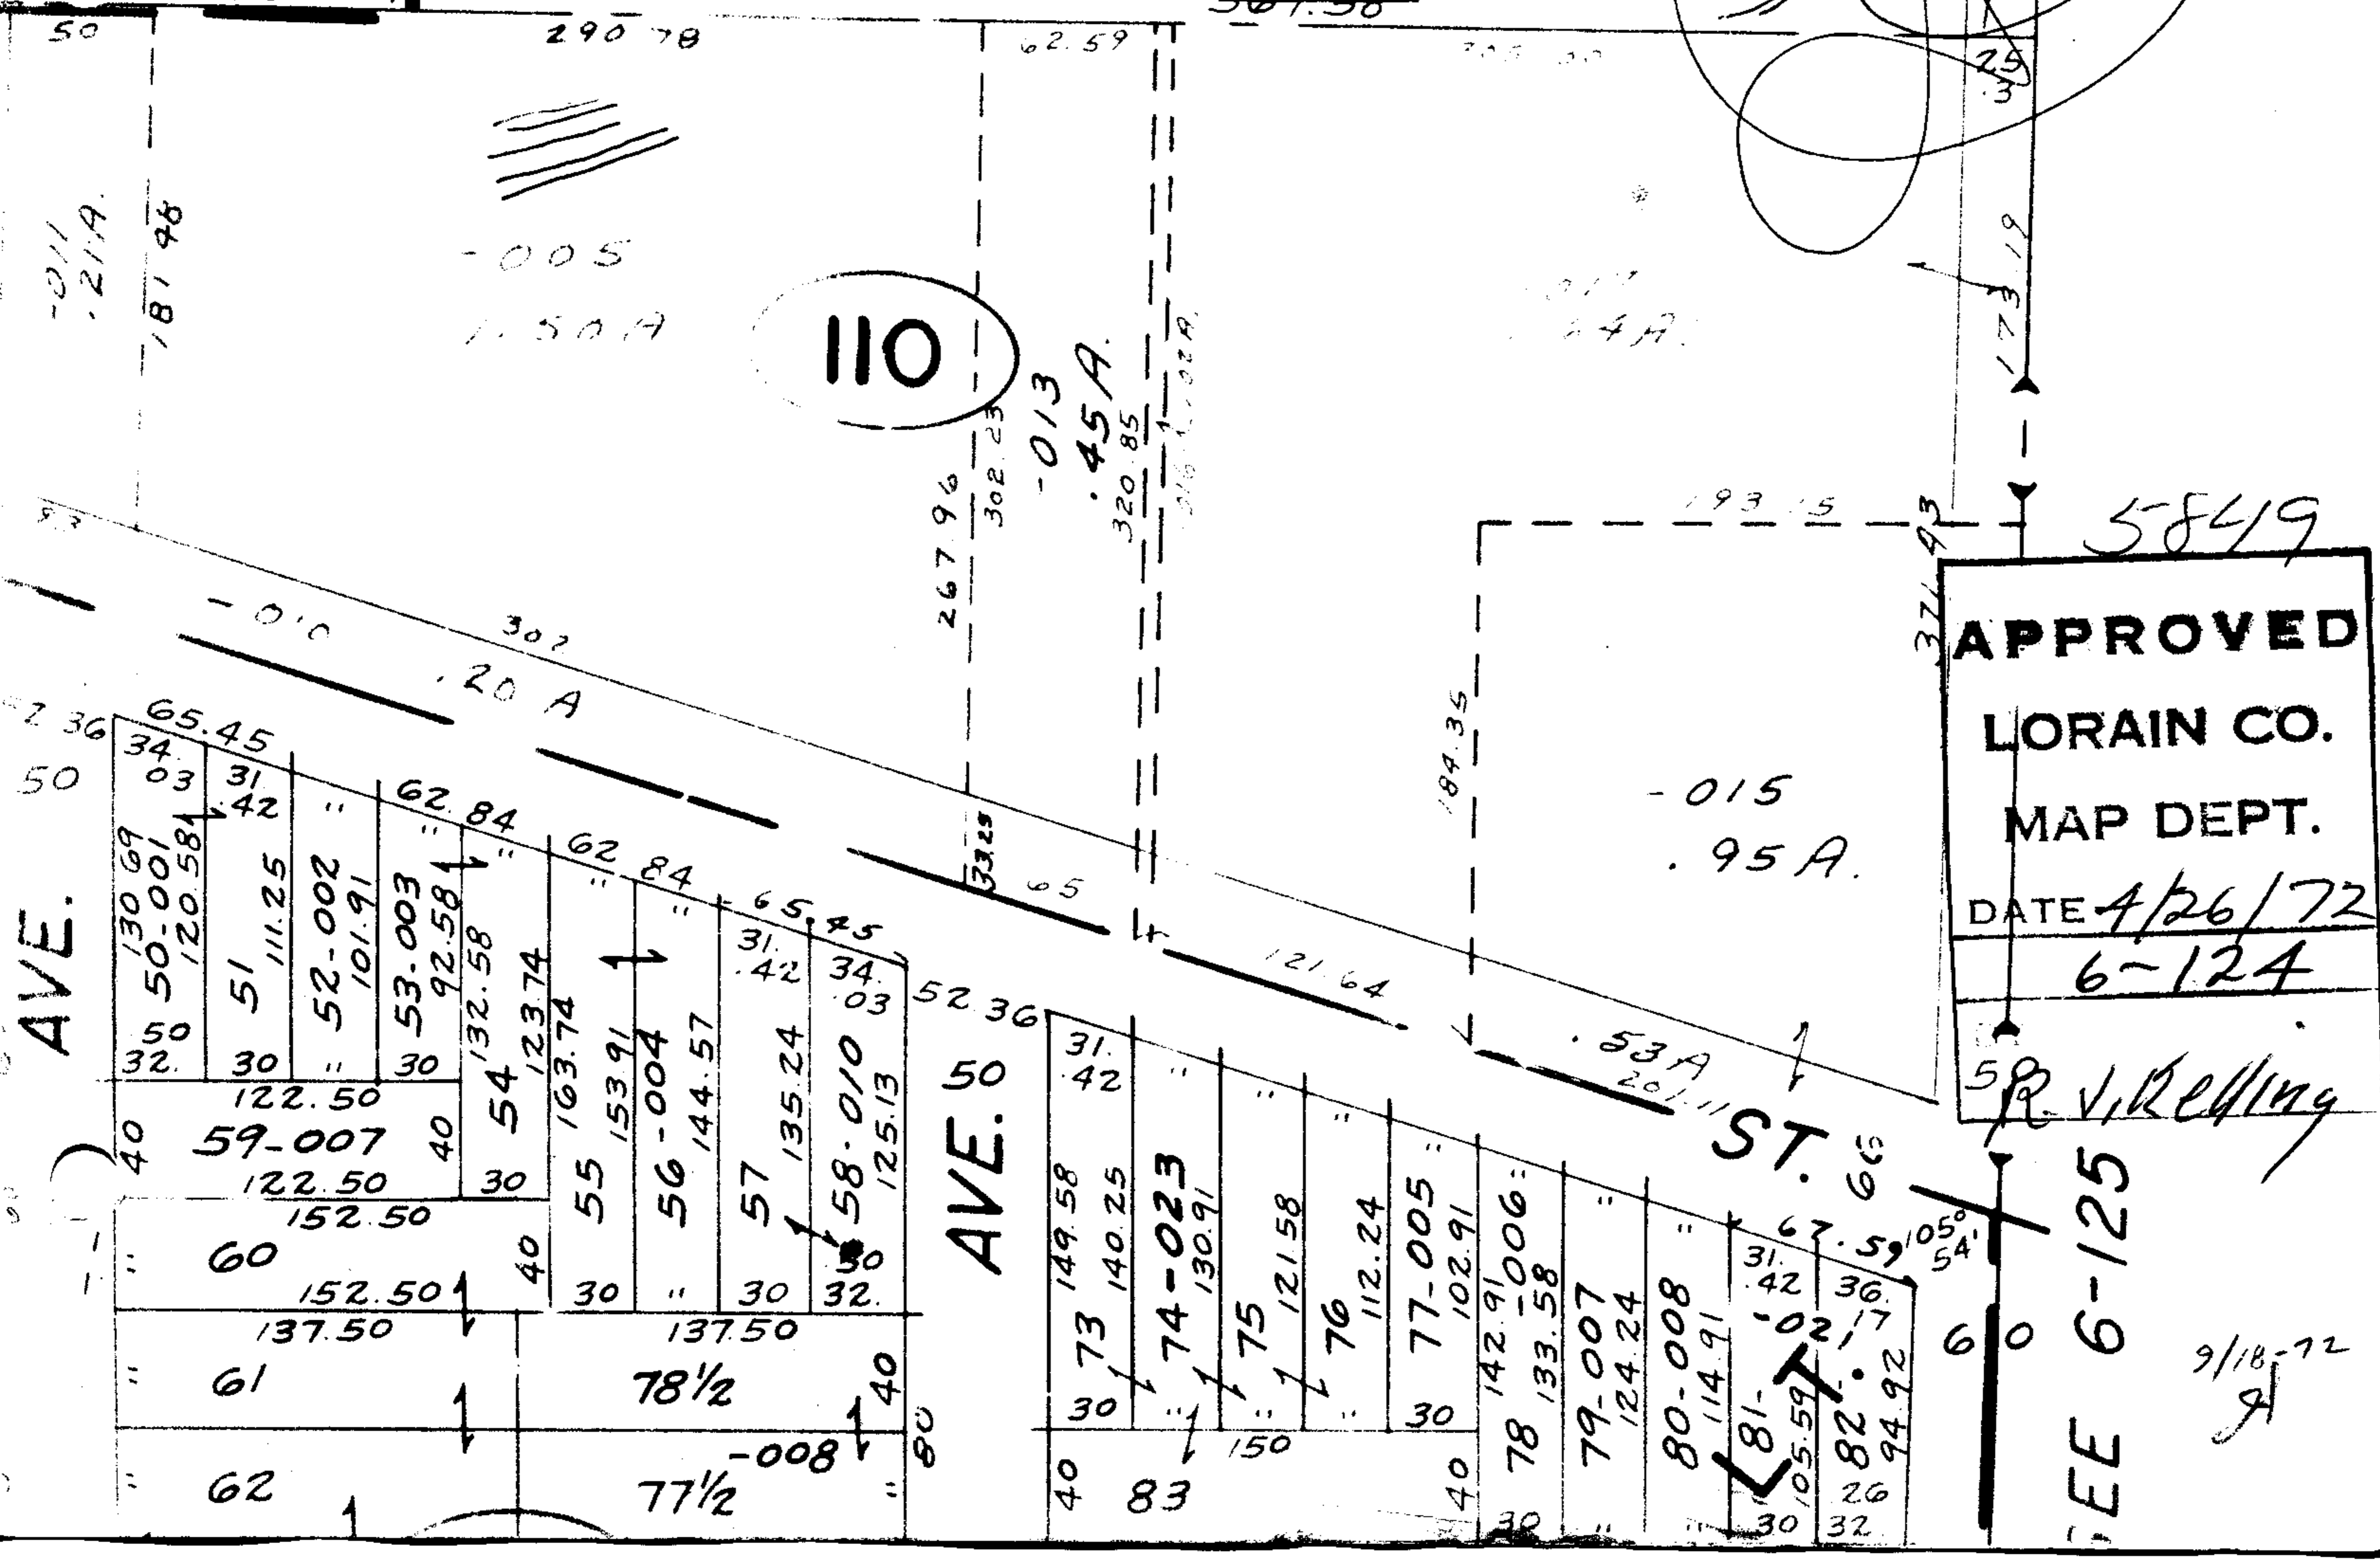

APPROVED
LORAIN CO.
MAP DEPT.
DATE 4/26/72
6-124

R. V. Kelling

SEE 6-125

9/18-72