

5853

46

200

2940 83

350

(60)

RD

175

350
-007
1.61A.

350
-008
1.61A.

350

-005
6.00A.

796.75

River


350

-012
13.79A

601.34

-013
71.32A

-018
-016
103.18

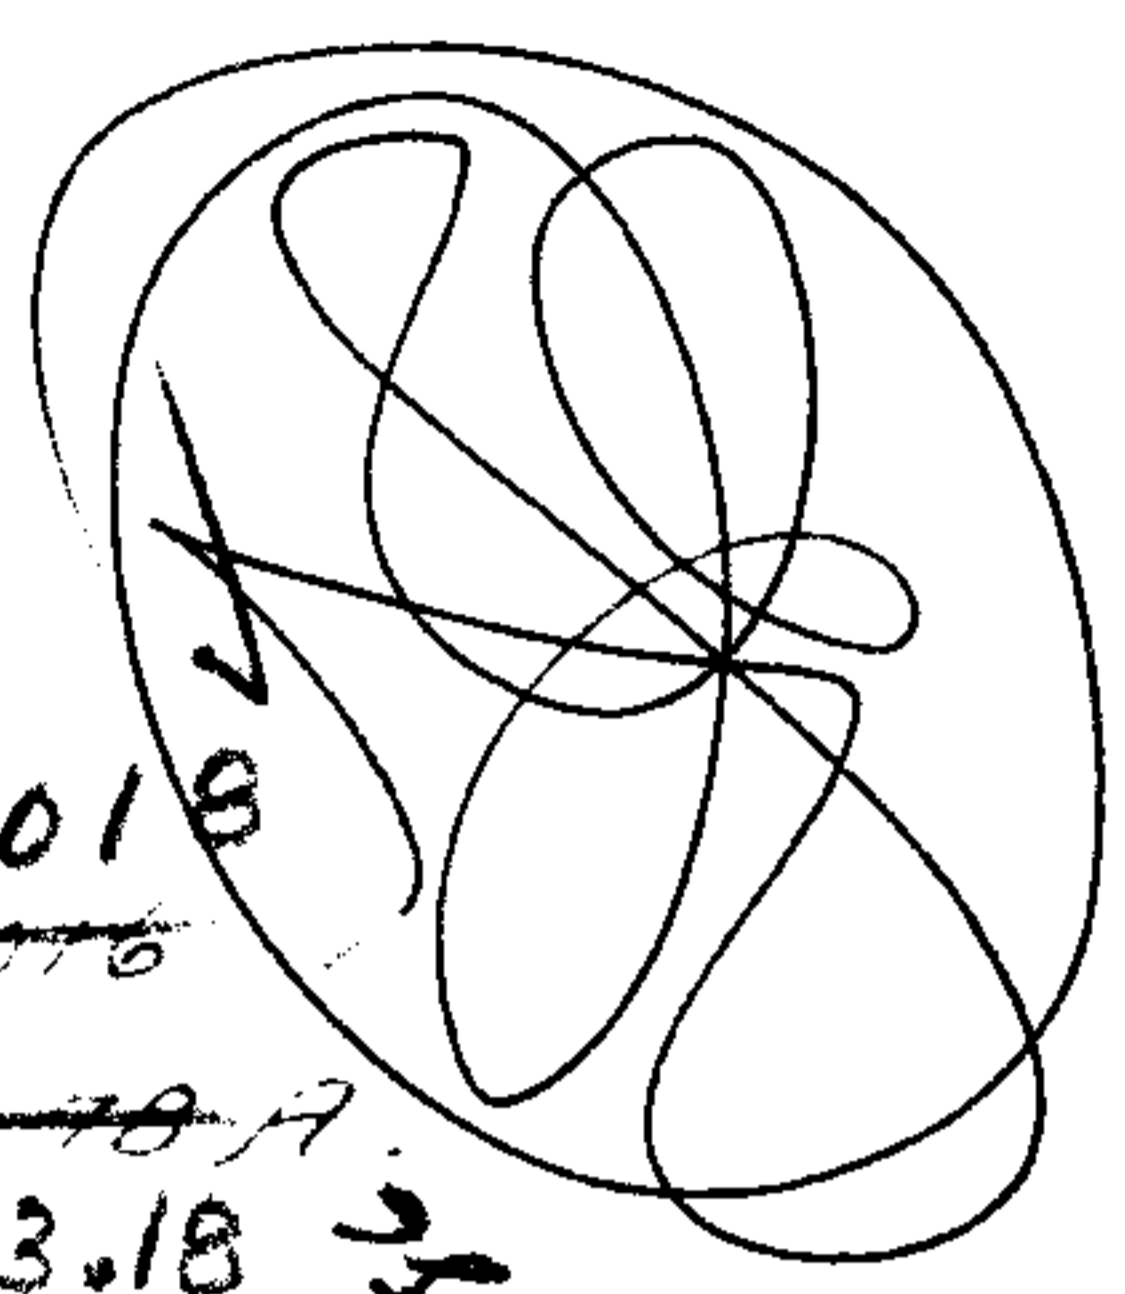

1941.64
1941.76

-017
15.60A.

APPROVED
LORAIN CO.
MAP DEPT.
DATE 12/1/72
BY R. W. [Signature]

41

350

302.95

SEE 18-B

