


5865

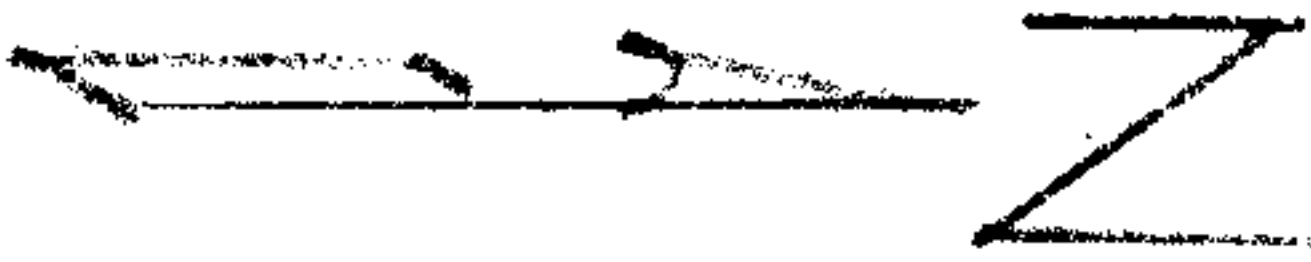

PARSONS

51 cal

~~-041~~

728 cal

1.24

~~-042~~

~~-042~~

284 AC

1.03

~~-043~~

524

~~-044~~

3.35
73
4.08

1.03
1.03
51
2.57


73
4.30
1.20
3.06

1.03
1.03
2.06
51
3.57

CARLISLE TWP.

SCALE 1" = 100'

SEE 15-D

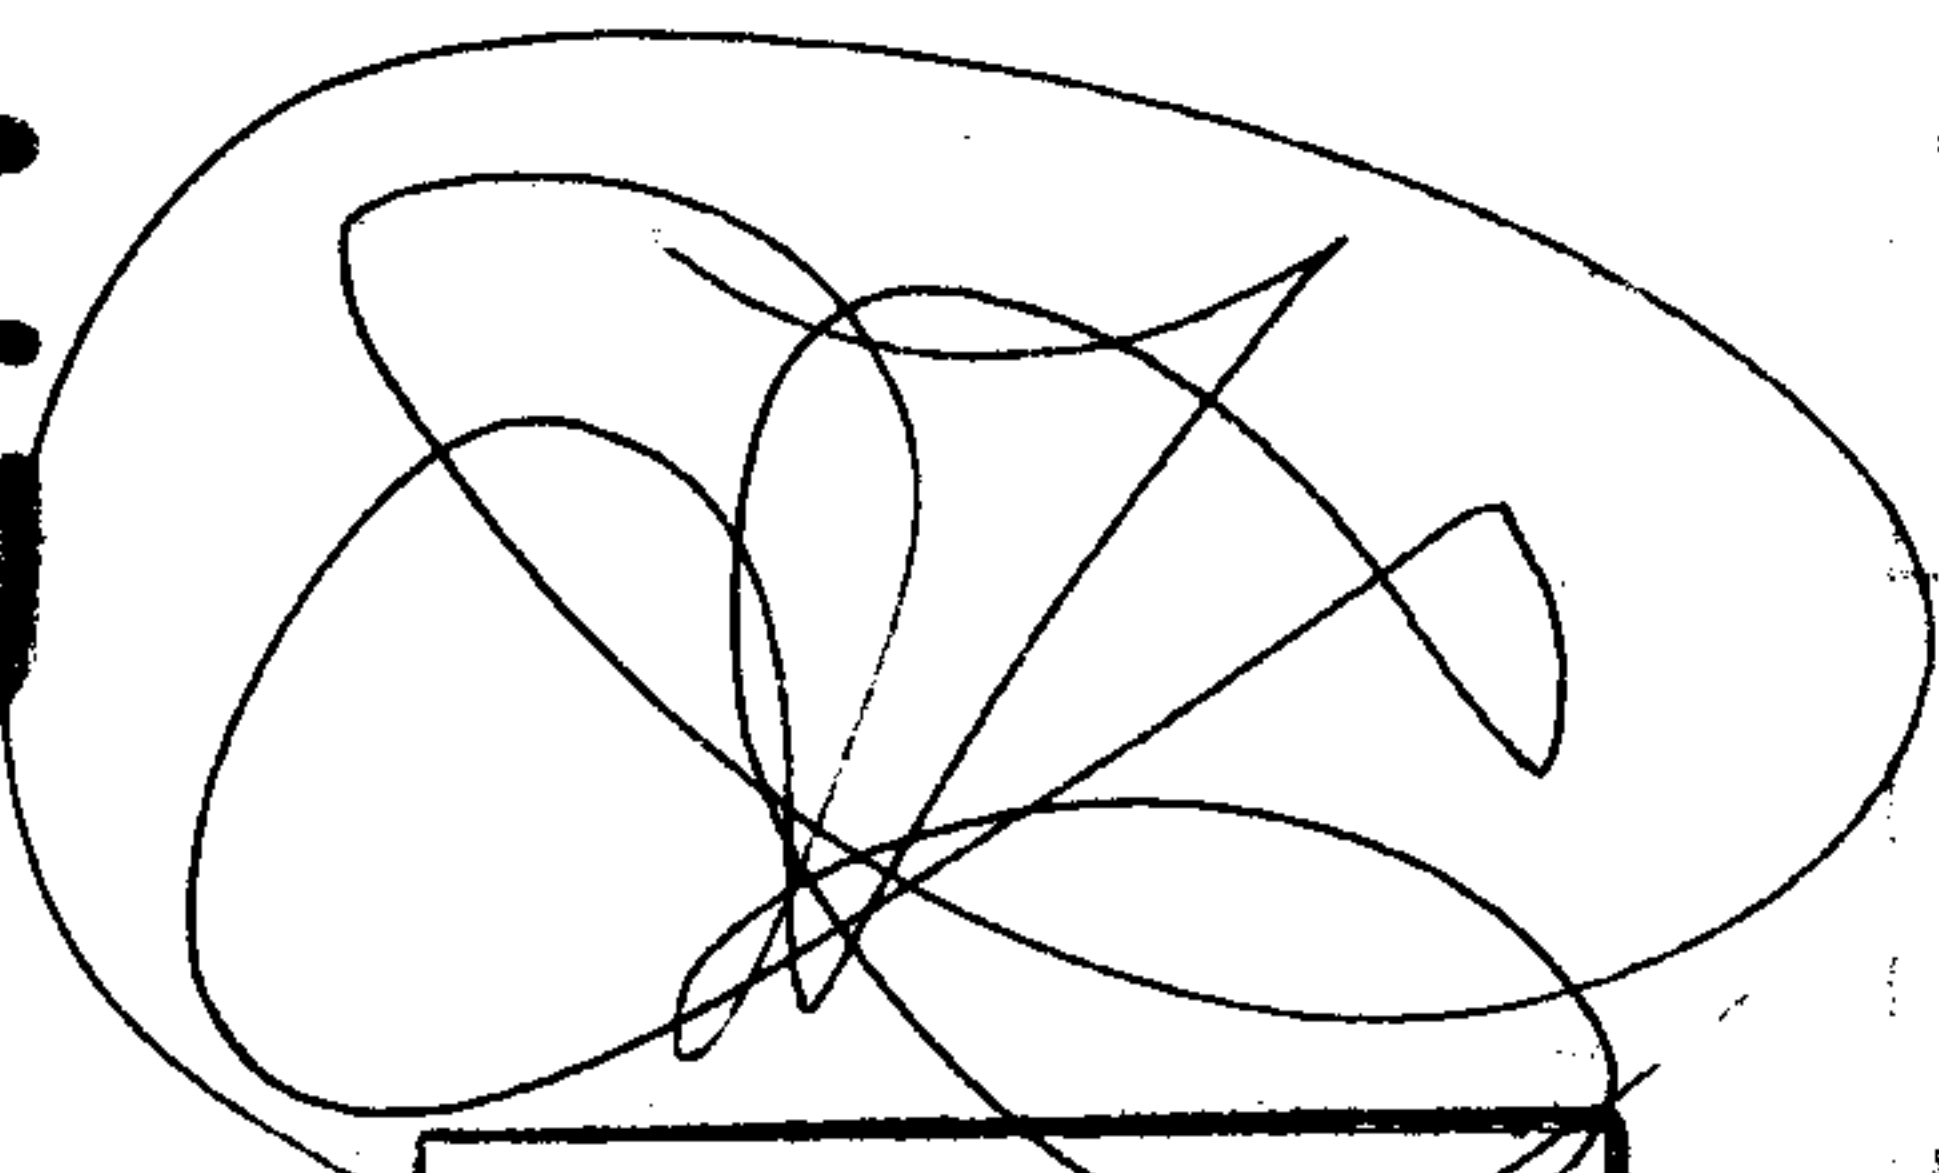

APPROVED
LORAIN CO.
MAP DEPT.
DATE 5/3/72
10-00-025-F
BY R. J. Kell

Attie
Offie

E 1/2 S 1/4

1730

1.03

See Rest
of Page
10-00-025F
for pt of
Remainder
3.57 LWT