

5867

-004
61.84

AKINS

231 188.57
-005 188.57
1.00A 231
231

435.7
-006 100
1.00A 100
435.7

100 200
-010 100
1.00A 100
-011 100
1.00A 435

(20)

363
-002 120
1.50A 120
363

423.5
363
-004 120
1.00A 120
363

175.13

275 125.10

← -008
dead. 171.63
722.98

275 834

410.57
410.67

-008
702.4

660.1

-001
77.84A

69

-003
23.66A


← -009
607
46.42A
46.42

177.52

-022

789.4

APPROVED
LORAIN CO.
MAP DEPT.
DATE 5/3/72
12-F
BY
R.V. Helting

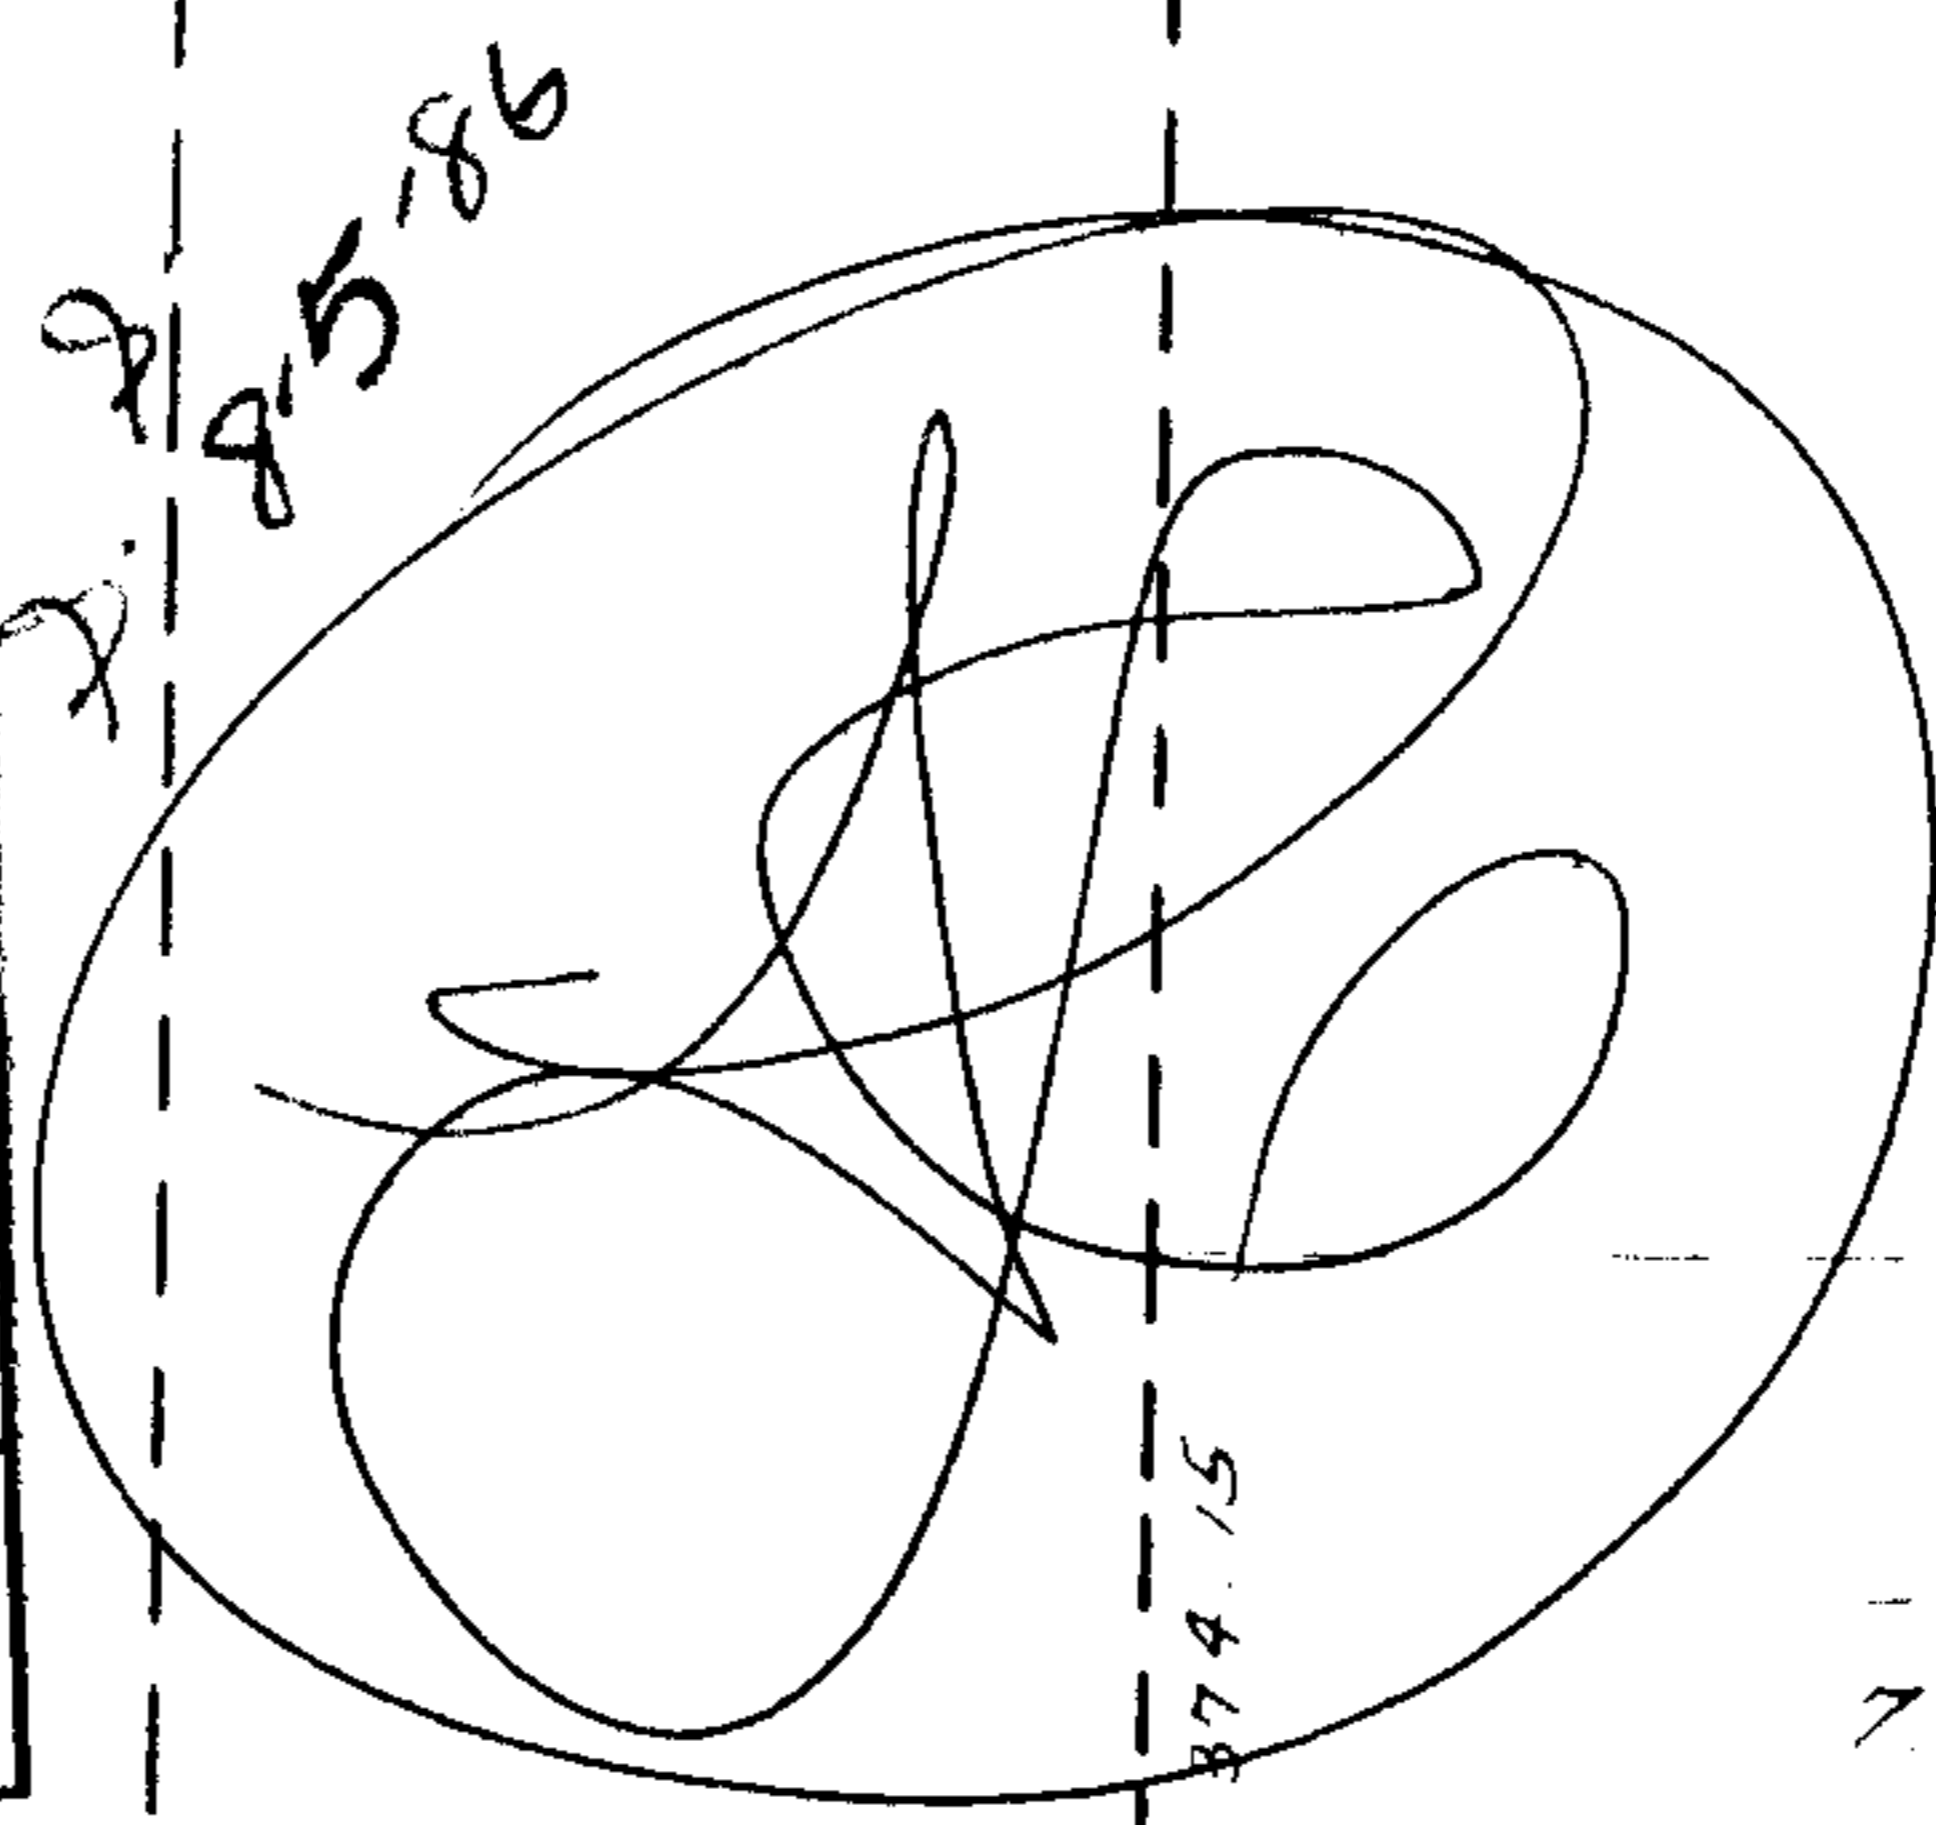

2.8
8-5-86

972.18
964.58

84°18'
7.60

872.95

991.98

-006
7.58A

662.31
660

259.20

749.10

-038
5.06A

-5.89°51'30"

-0
5.0

-0
4.