

FR 115x140
R 115x137.9
DU 992-1987
115 Connection

25x80.08 = 04 AC
-037

5873
APPROVED
LORAIN CO.
MAP DEPT.
DATE 5-8-72
76
BY L.W. Hall

~~024~~
~~37.99~~
-038
37.95

235.72
139.92


95.80

139.92
80.08

220.00

7-21-86
L.L.

13

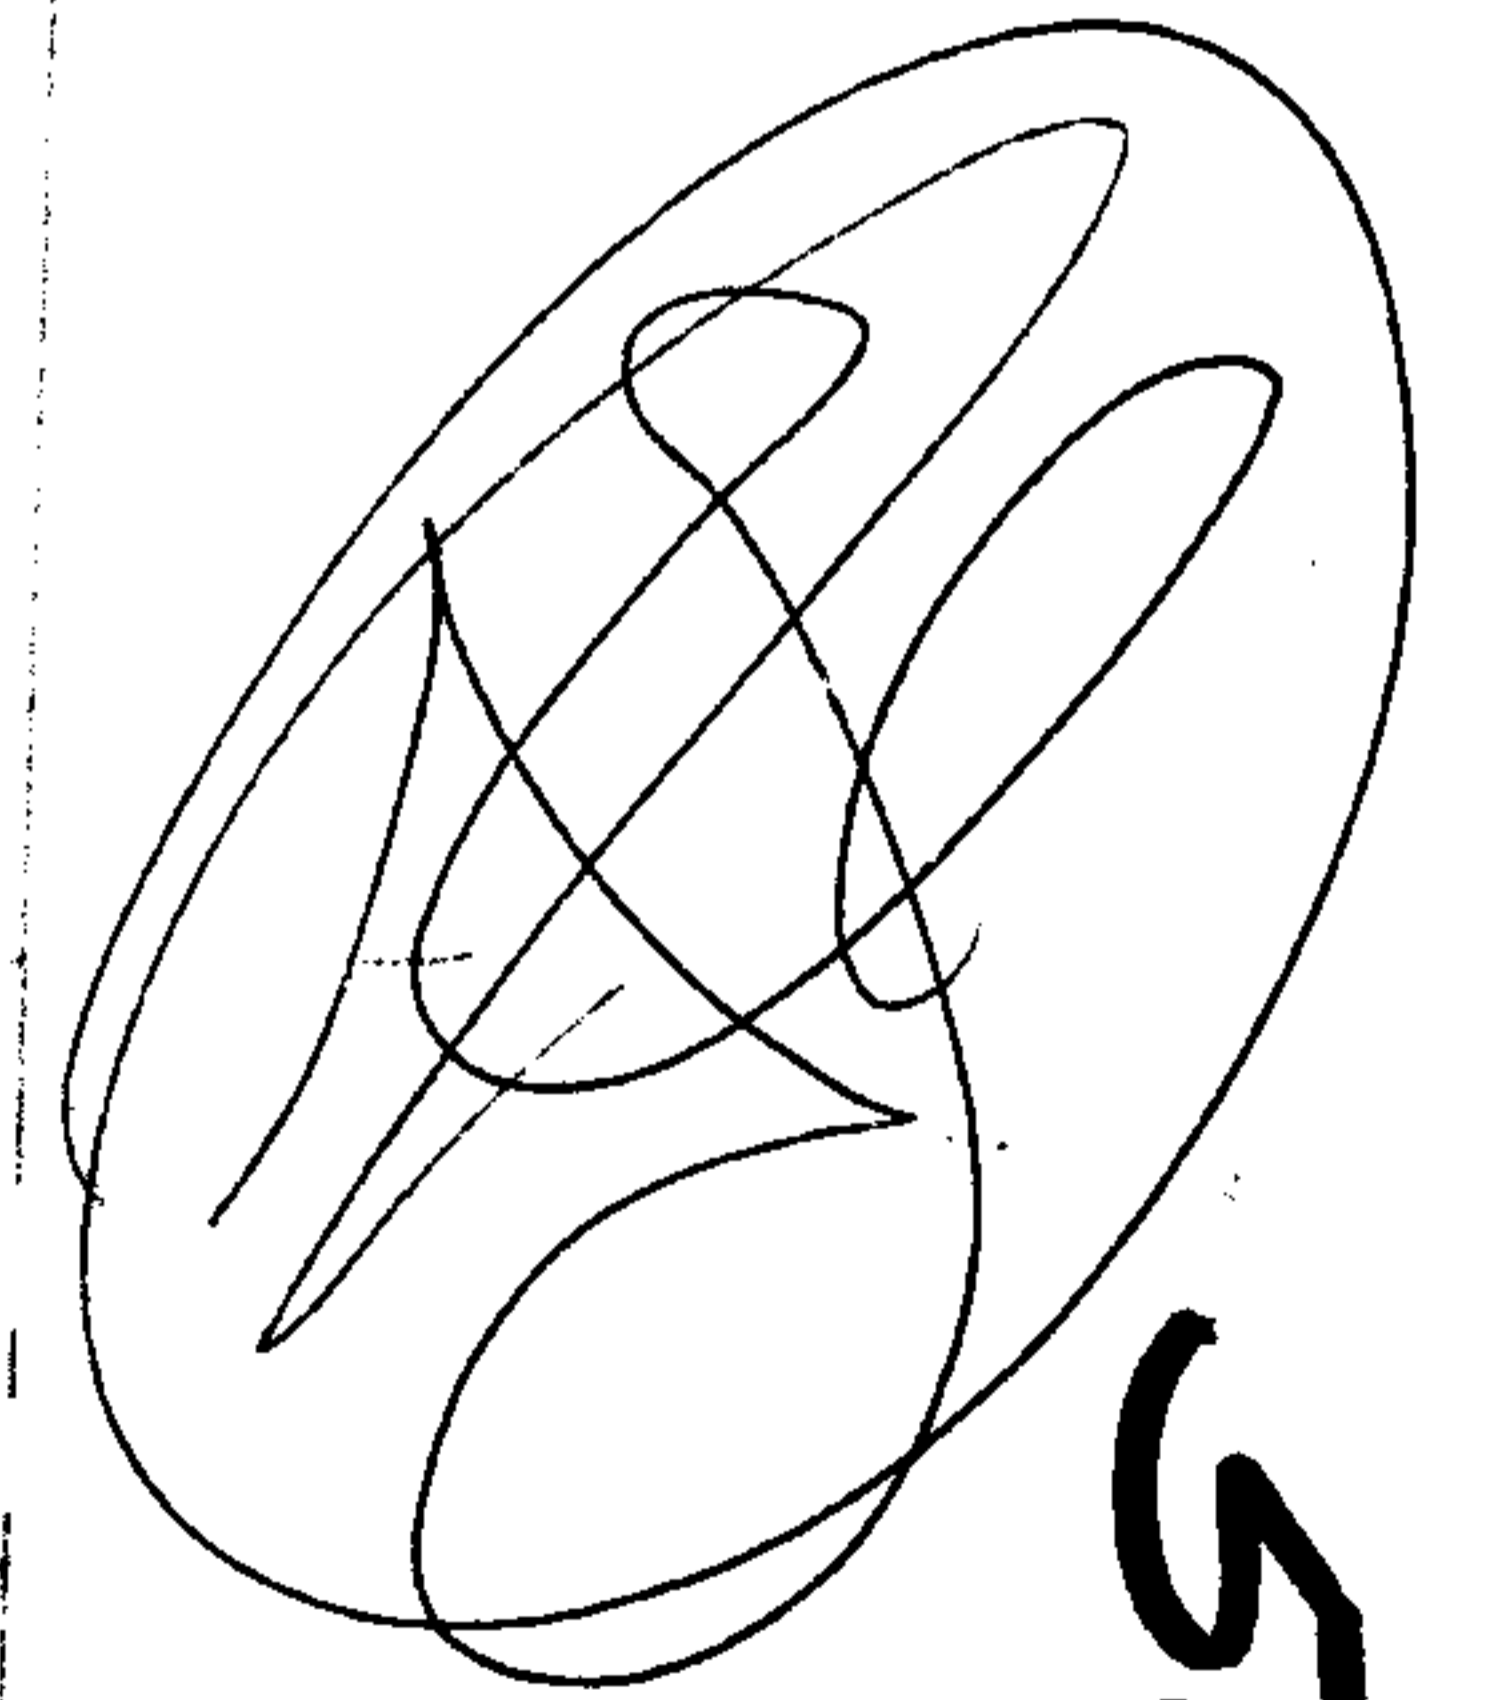

5873

