

5879

-003  
25.00A

005  
5.96A

818.4  
893.64

285.16

1265.8

838.40

1591.68

-004  
24.90A

-001  
88.30A - D  
86.51A - Dup.

-006  
5.78A

837.44

-010  
2.31A


1.33A

-008  
5.58A

835.9

5879

APPROVED  
LORAIN CO.  
MAP DEPT.  
DATE 5-9-72  
16-H.  
BY *[Signature]*

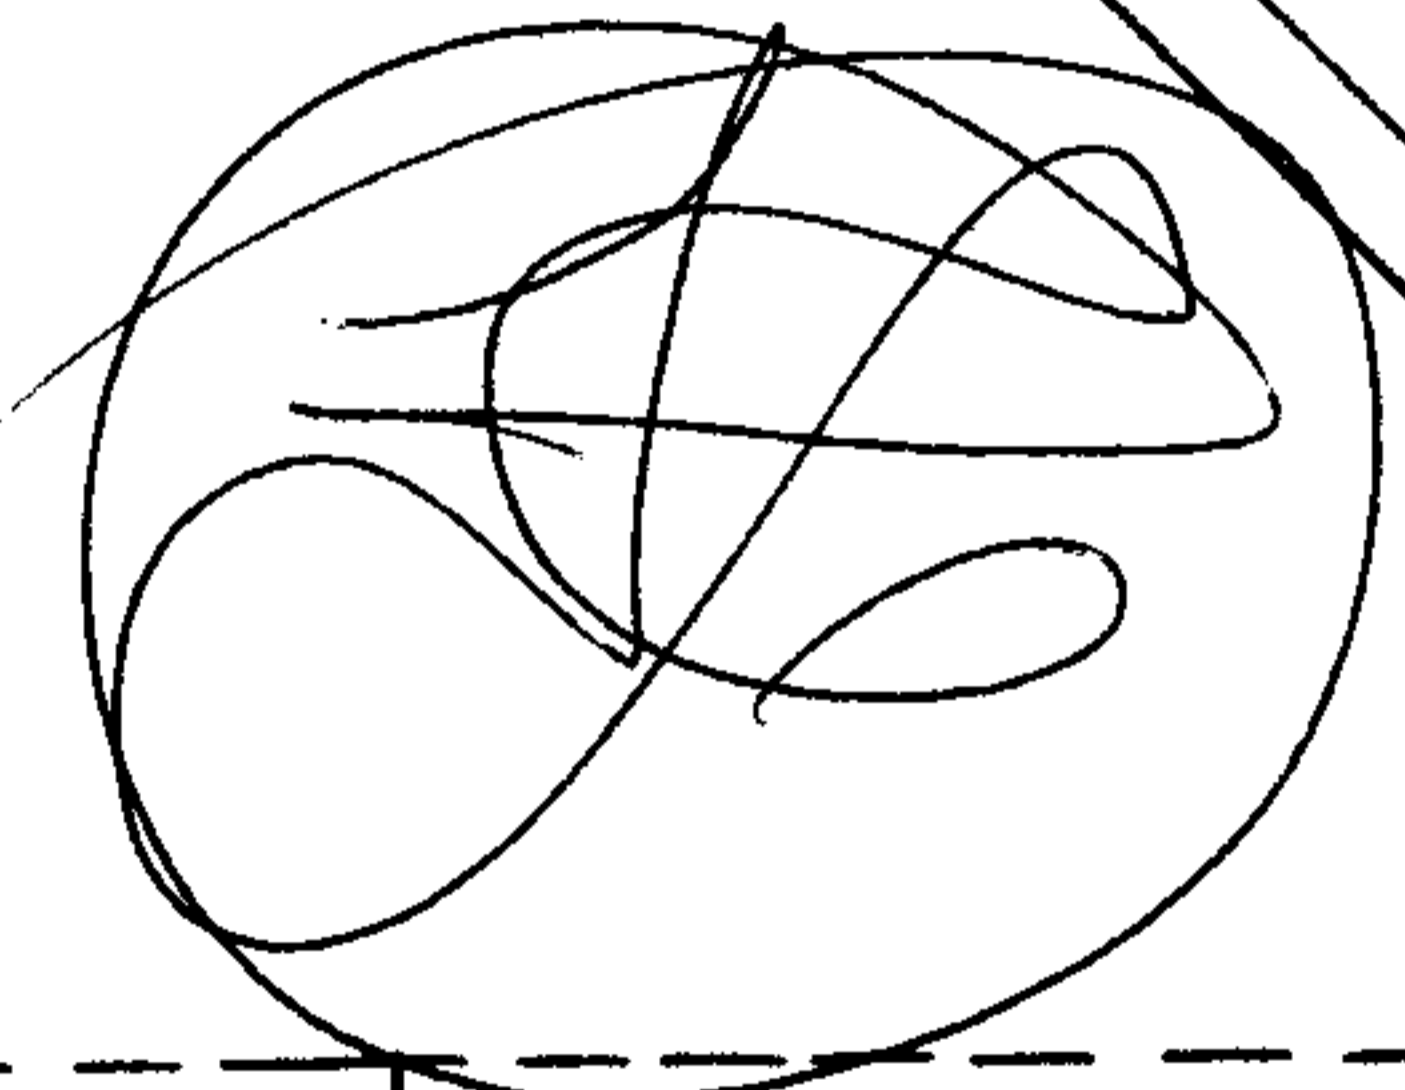

89

-014  
10.53A

893.64  
349.67

229.54

-013  
12.17A

1517.98

-011  
8.00A

1515.31

-003  
17.00A

348.49

227.54

2010

-013  
~~-004~~  
25.00A  
19.00A

767.13

-012  
6.00A

774.8

789.56  
190

190.60

1067.27

28.05

33

1252.68  
1163.40

MEDINA - ELYRIA 1892.20

201.3

468.8

300

190

290.60

11(60)

-005  
28.60A - D.  
27.70A - Dup.

6685

-001  
47.45A - D.