

53 - 118

11A
15.56
76
18
70
51 - 120
145
60
20
9.25

52 - 119

HICKORY VOL.

49 - 004
25

42 - 009

50 - 005

PT. 02 - 0

41 - 008

33 - 014

08-101-102
55A.


59.10
59.10
945.07

PRINCESS ANNE

5376
5886

APPROVED
LORAIN CO.
MAP DEPT.
DATE 5-11-72
2-01-008-A
BY *[Signature]*

QUEEN ANNE
STREET DEDICATION PLAT V.25 P.16

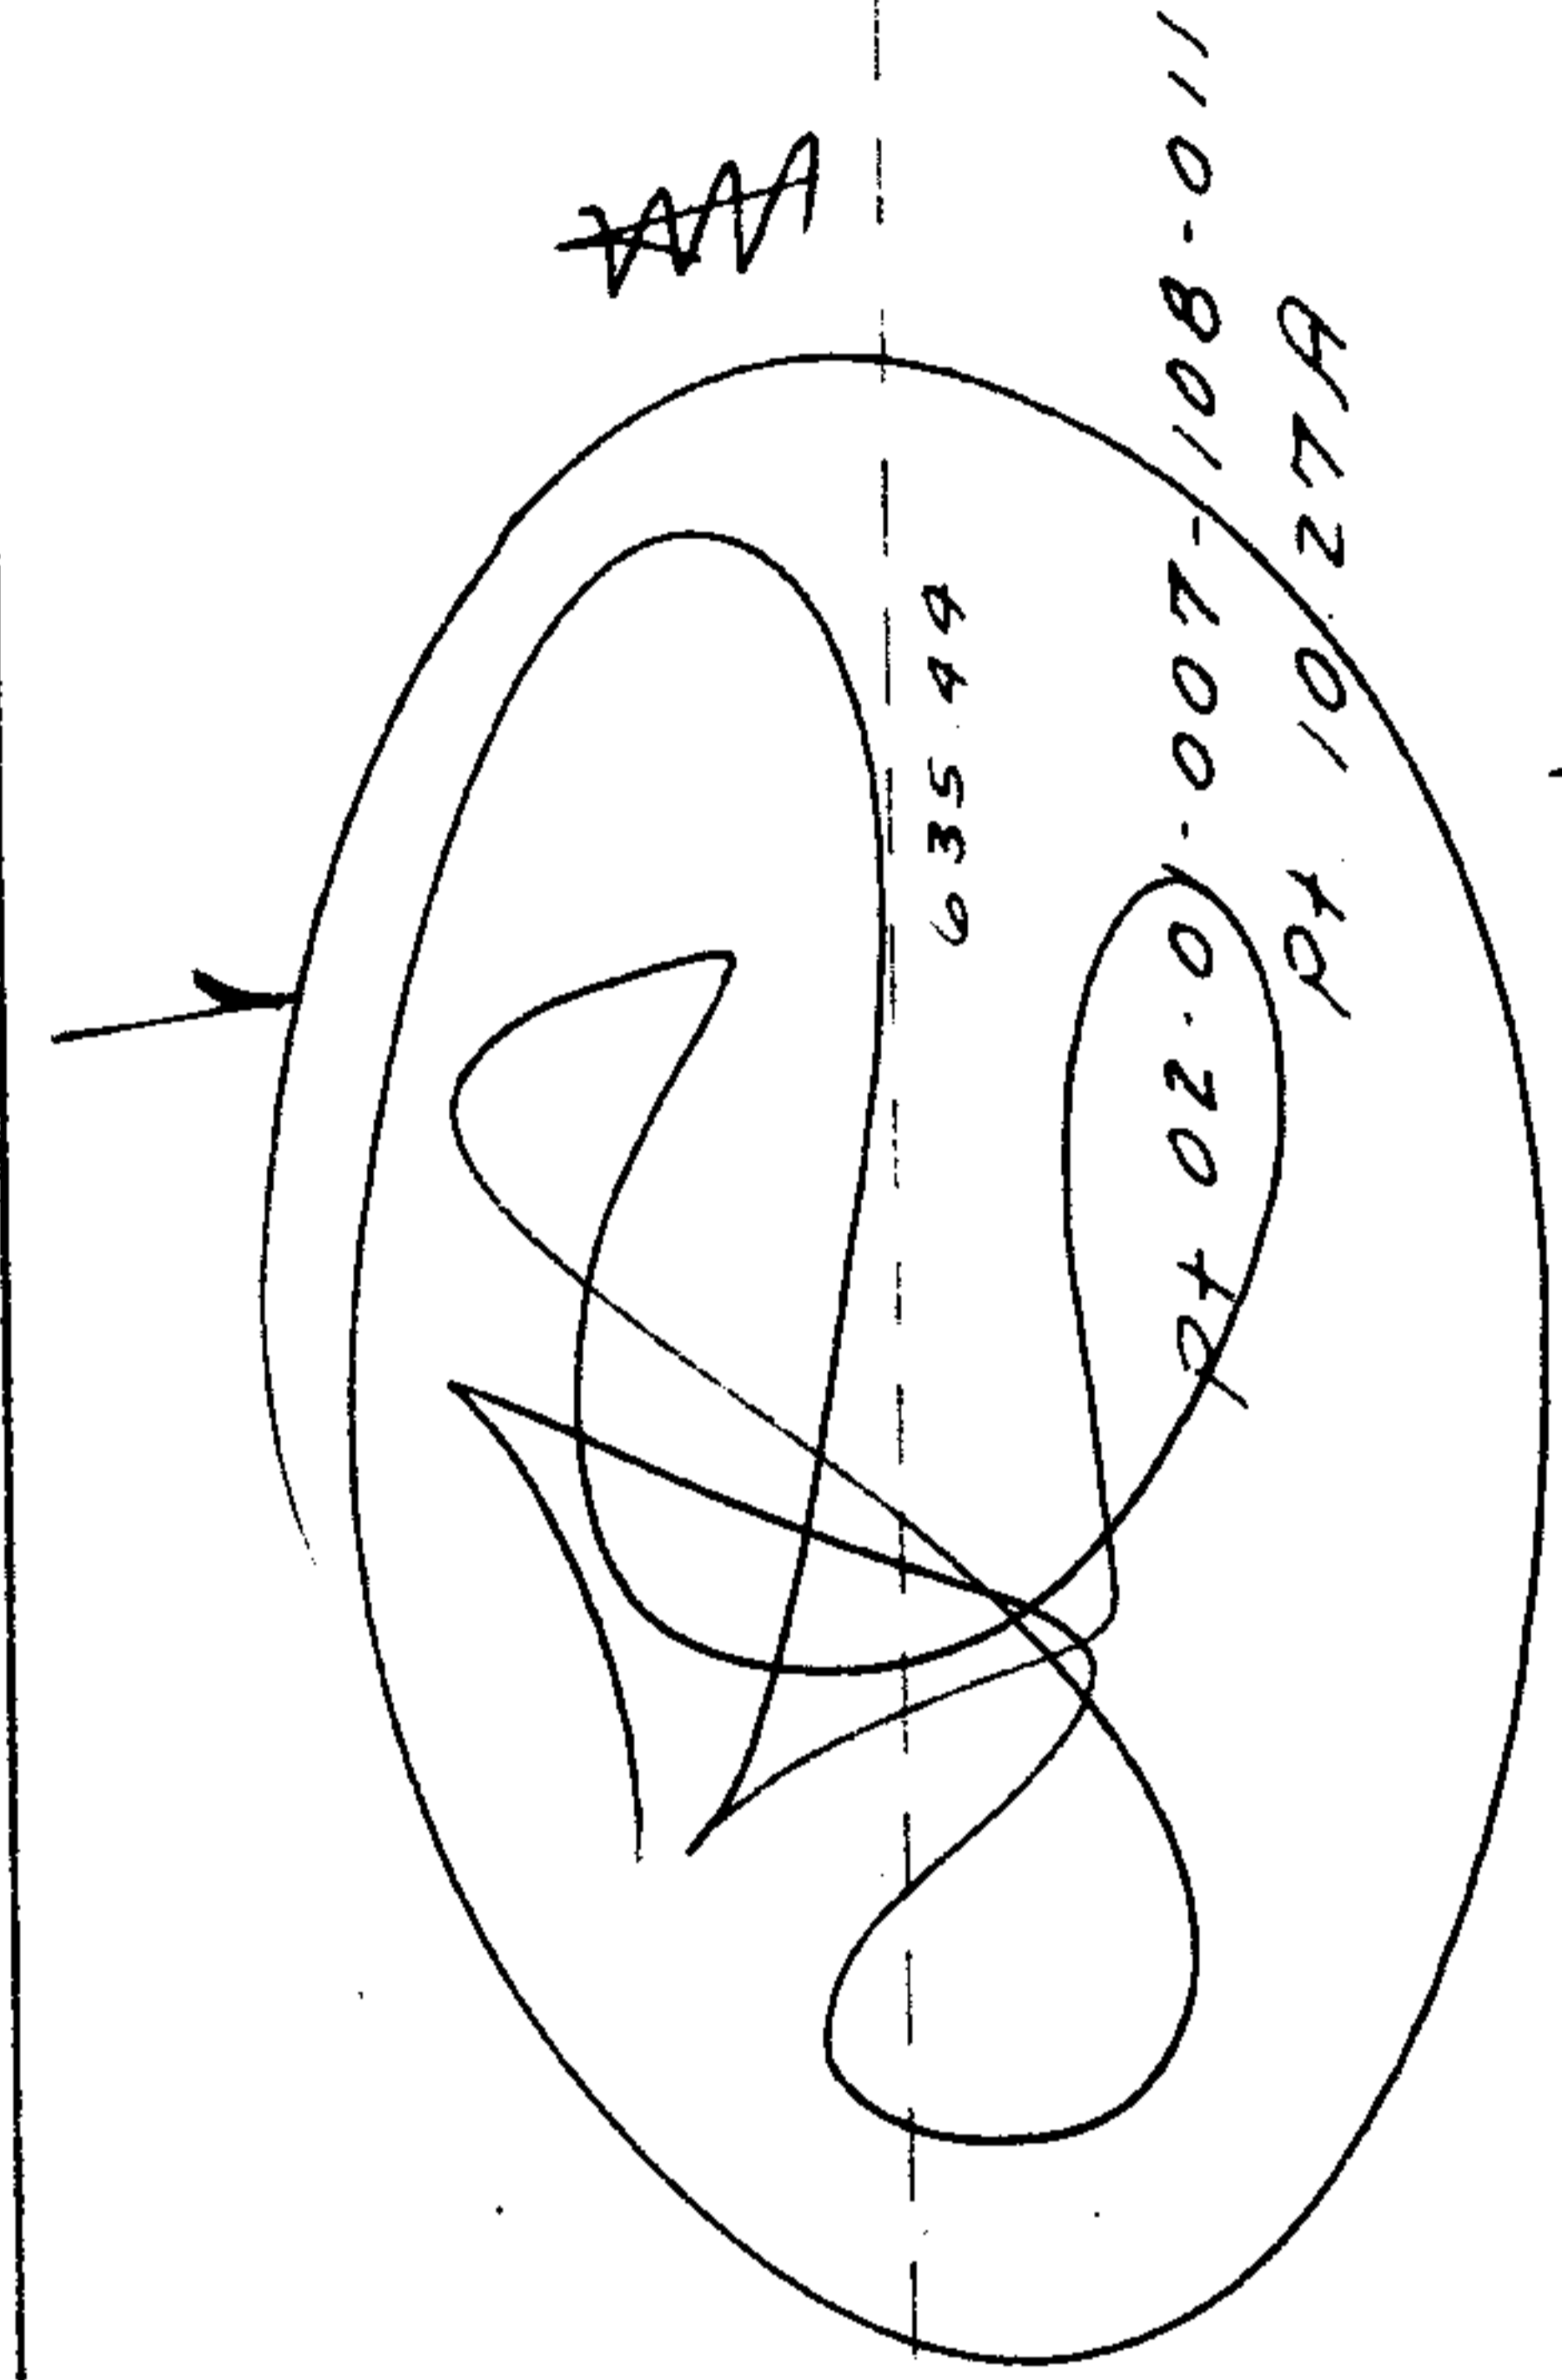

HICKORY HILL

SEE 2-01-007-A

W. 45TH

PLACE

2-01-008-A

5376-5886

99.25
029
54A.
118.31
18.11
030
54A.
99.25
120.24

(101)
PT. ~~144~~
PT. 940A
9.20A.
- 195

S.S
7-21-86

PT. 900-003
PT. 5.63A

193.70
-121