

5889

824.70 681.54  
-038  
2.00 A.

103

799.35  
-039  
2.00 A.

573.12

-046  
4.83 A. **5889**

APPROVED  
LORAIN CO.  
MAP DEPT.  
DATE 5-12-72  
6-39  
BY *[Signature]*

200  
-042  
90

-043  
90

-049  
1.00 A.  
~~247~~  
~~137~~  
267.30  
175.30

200  
-048  
0.39 A.  
200

125-009  
170  
200


-010  
0.36 A.

-011  
0.35 A.

200  
Pt.-003  
Pt. 1.00 A.  
105

SEE 6-40

261.30  
86.5  
175.30

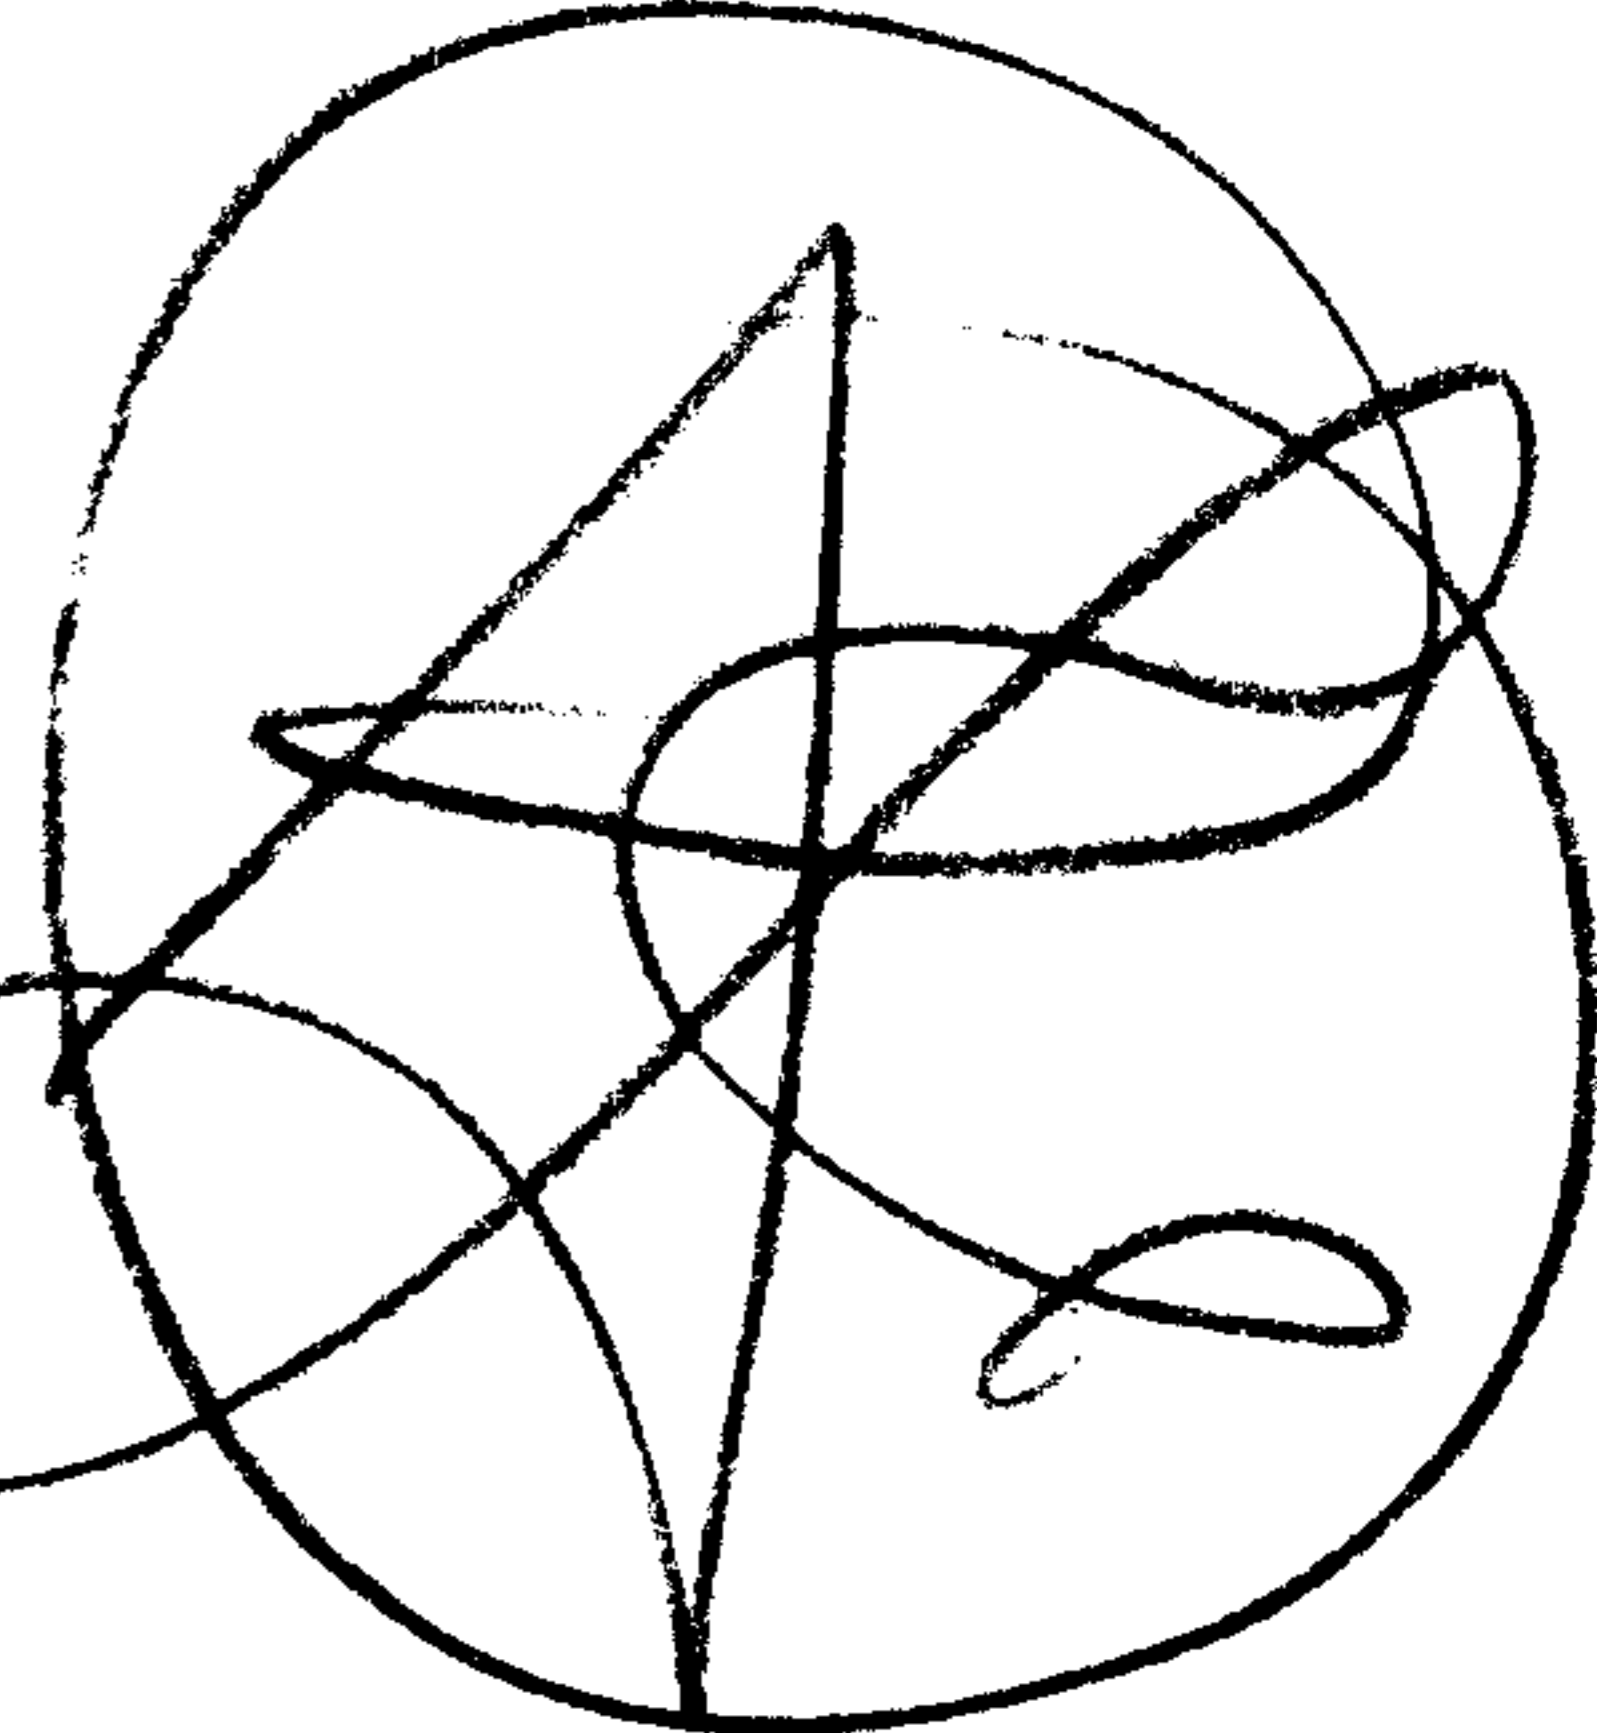

6-39

