
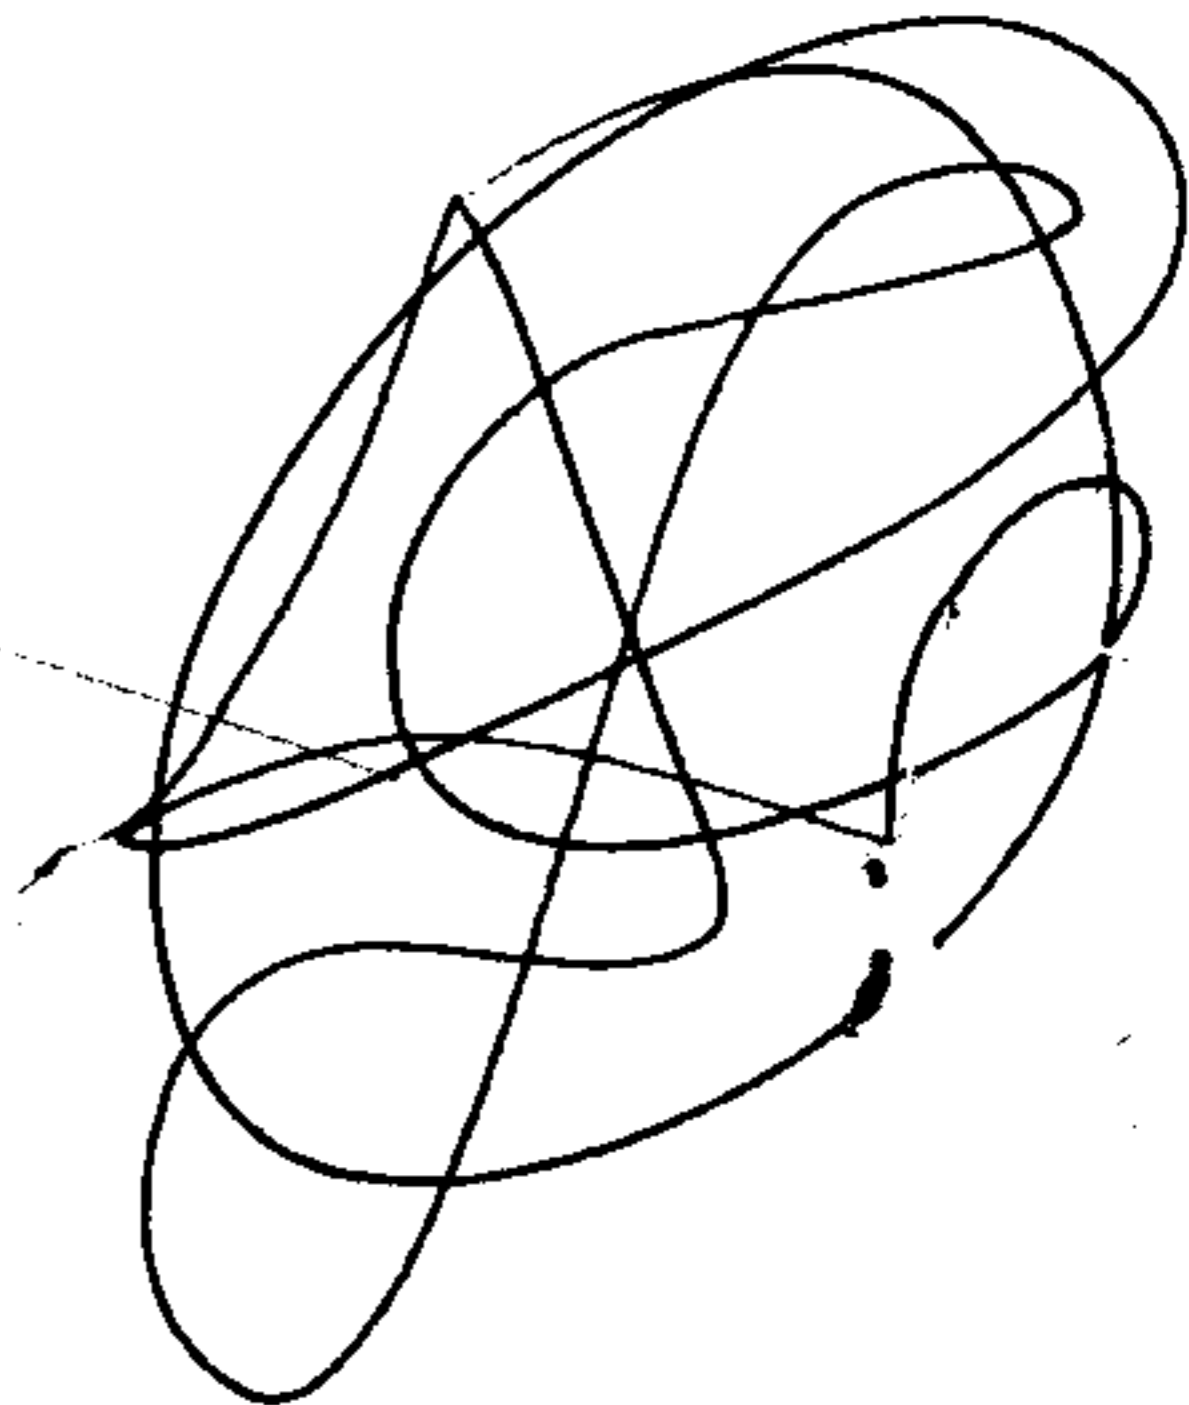


5896

Change Number & Acres
on Page 5-00-085

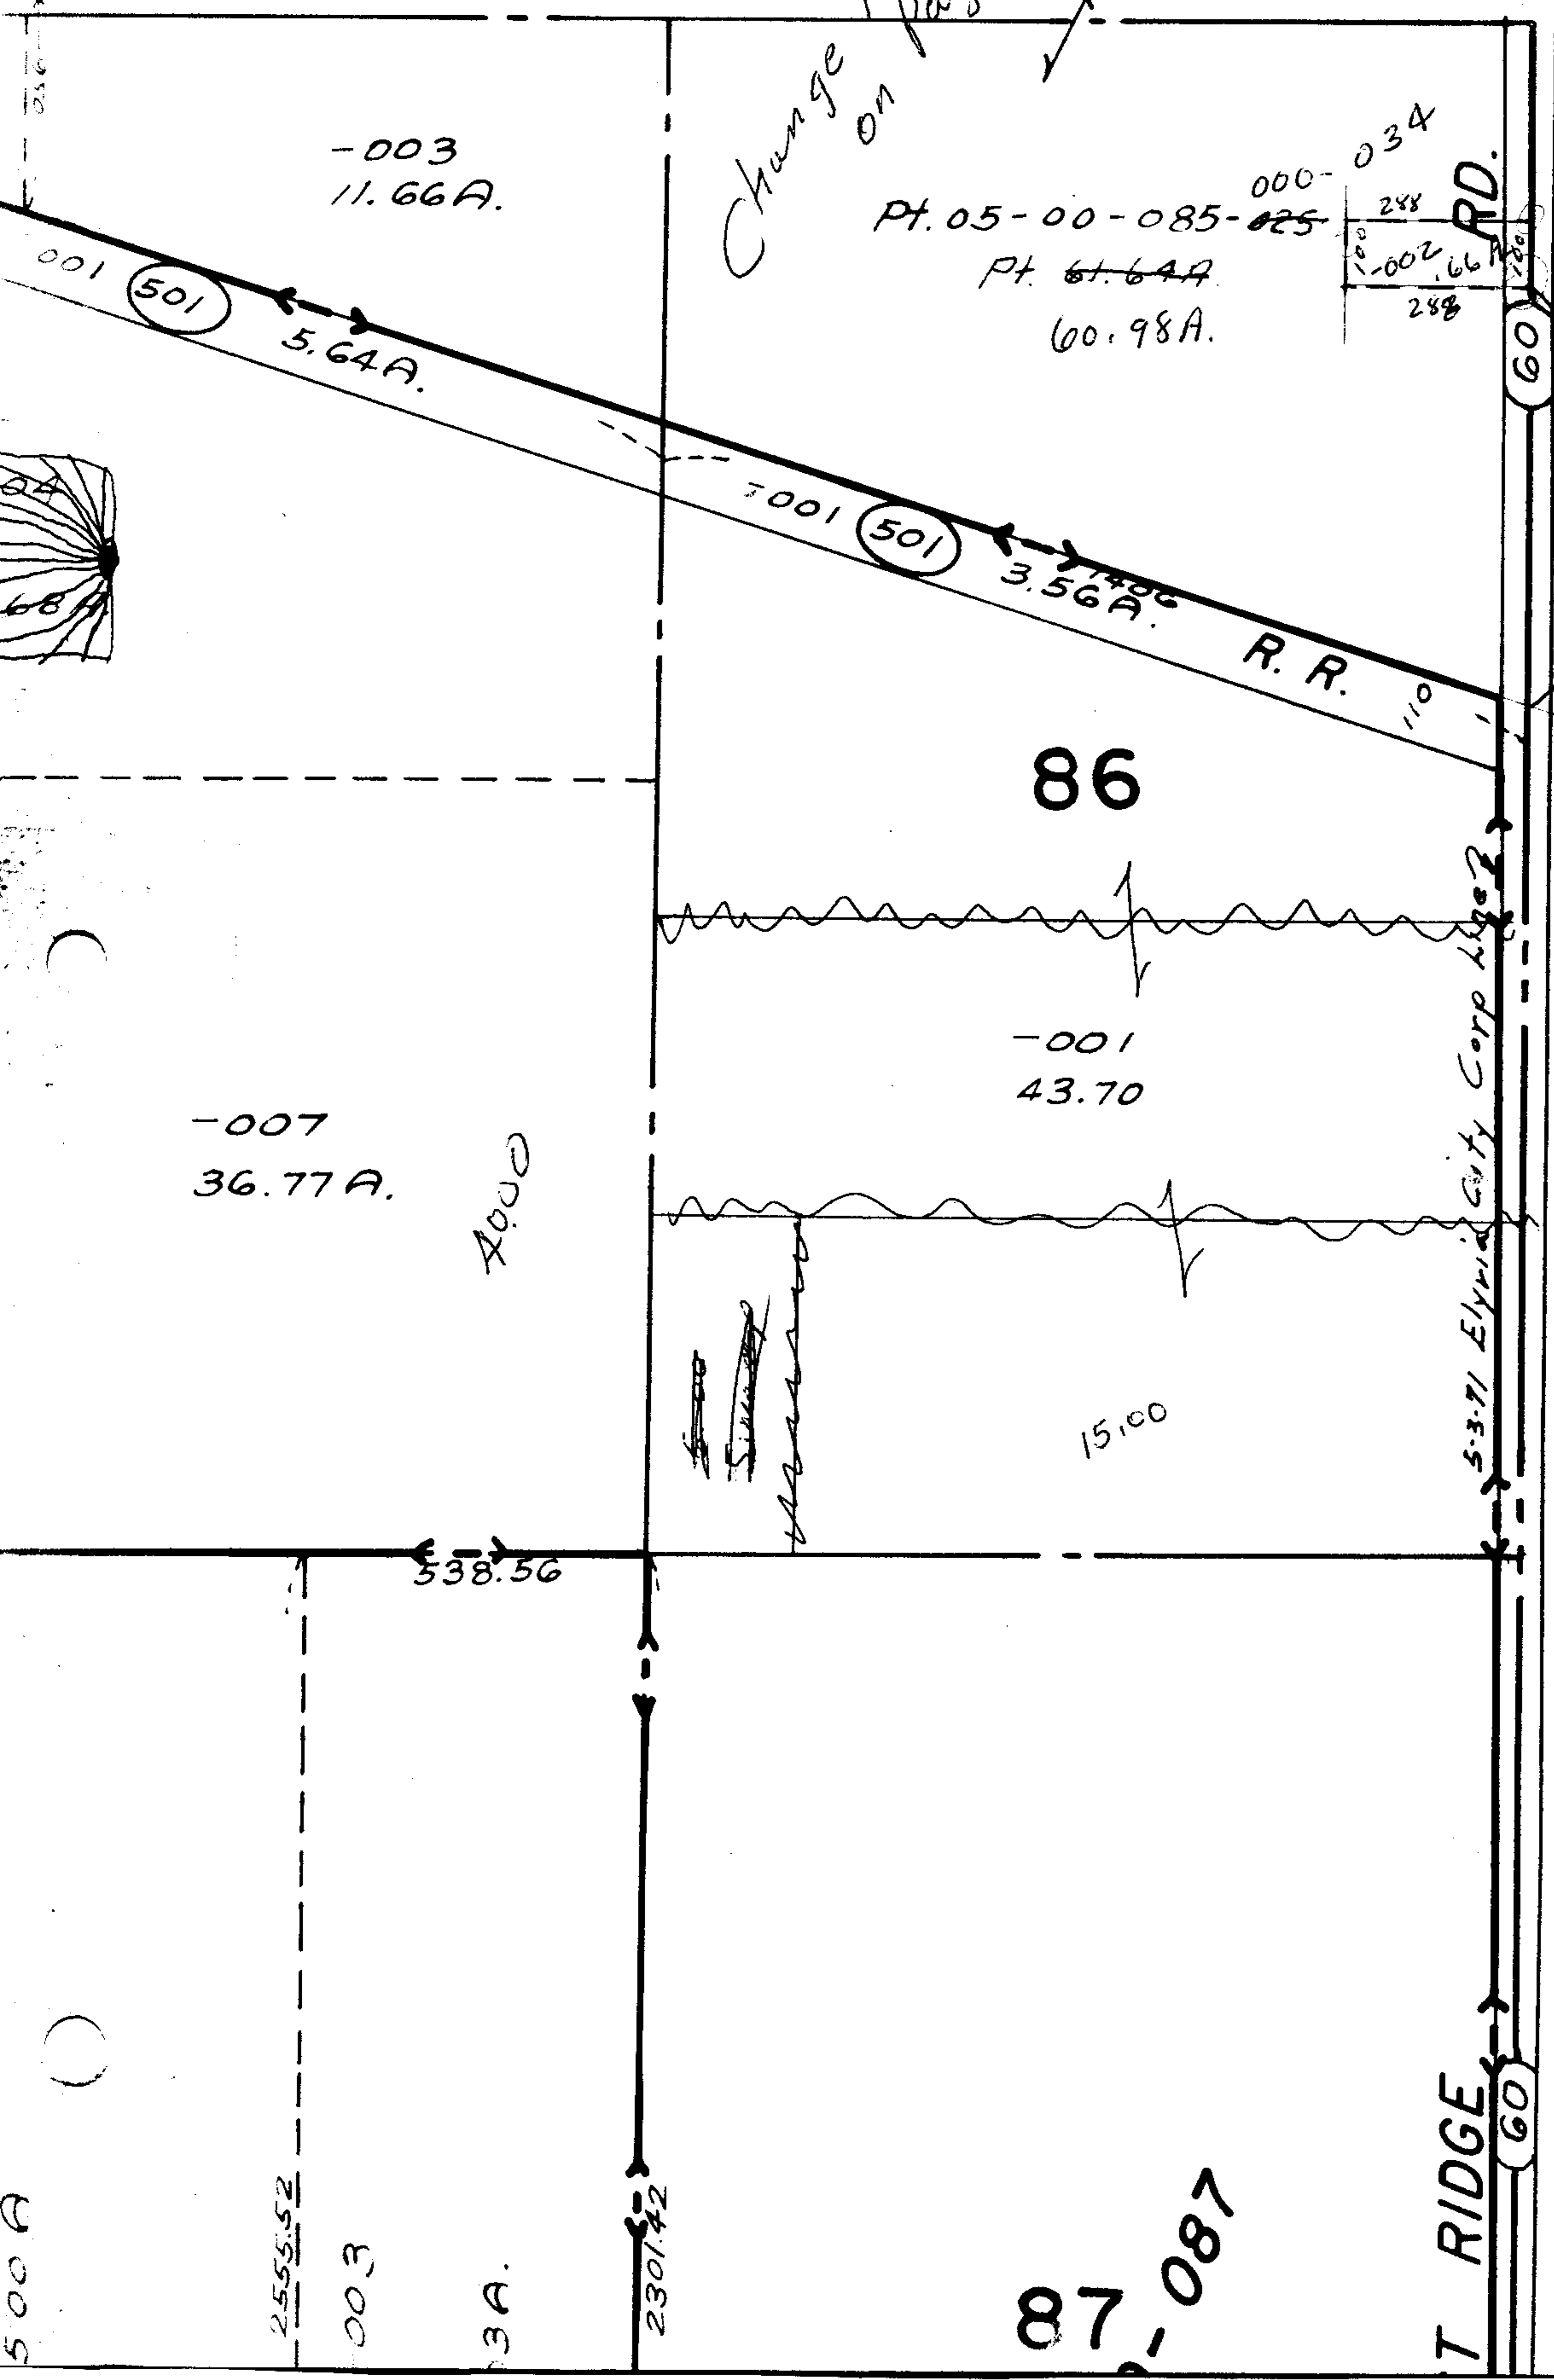

5896

APPROVED
 LORAIN CO.
 MAP DEPT.
 DATE 5-19-72
 5-145-00-085
 BY *[Signature]*

87-087