

5900

SL #29

00-008-A

76.50 76.50

-035 .20A
260.79

.239
.49A
215.55


.038
.55A
330.30

84.04
1497.15

34.02

-041
1.17AC
417.19

042
~~2.10~~
~~2.21~~
7.07AC
8.01

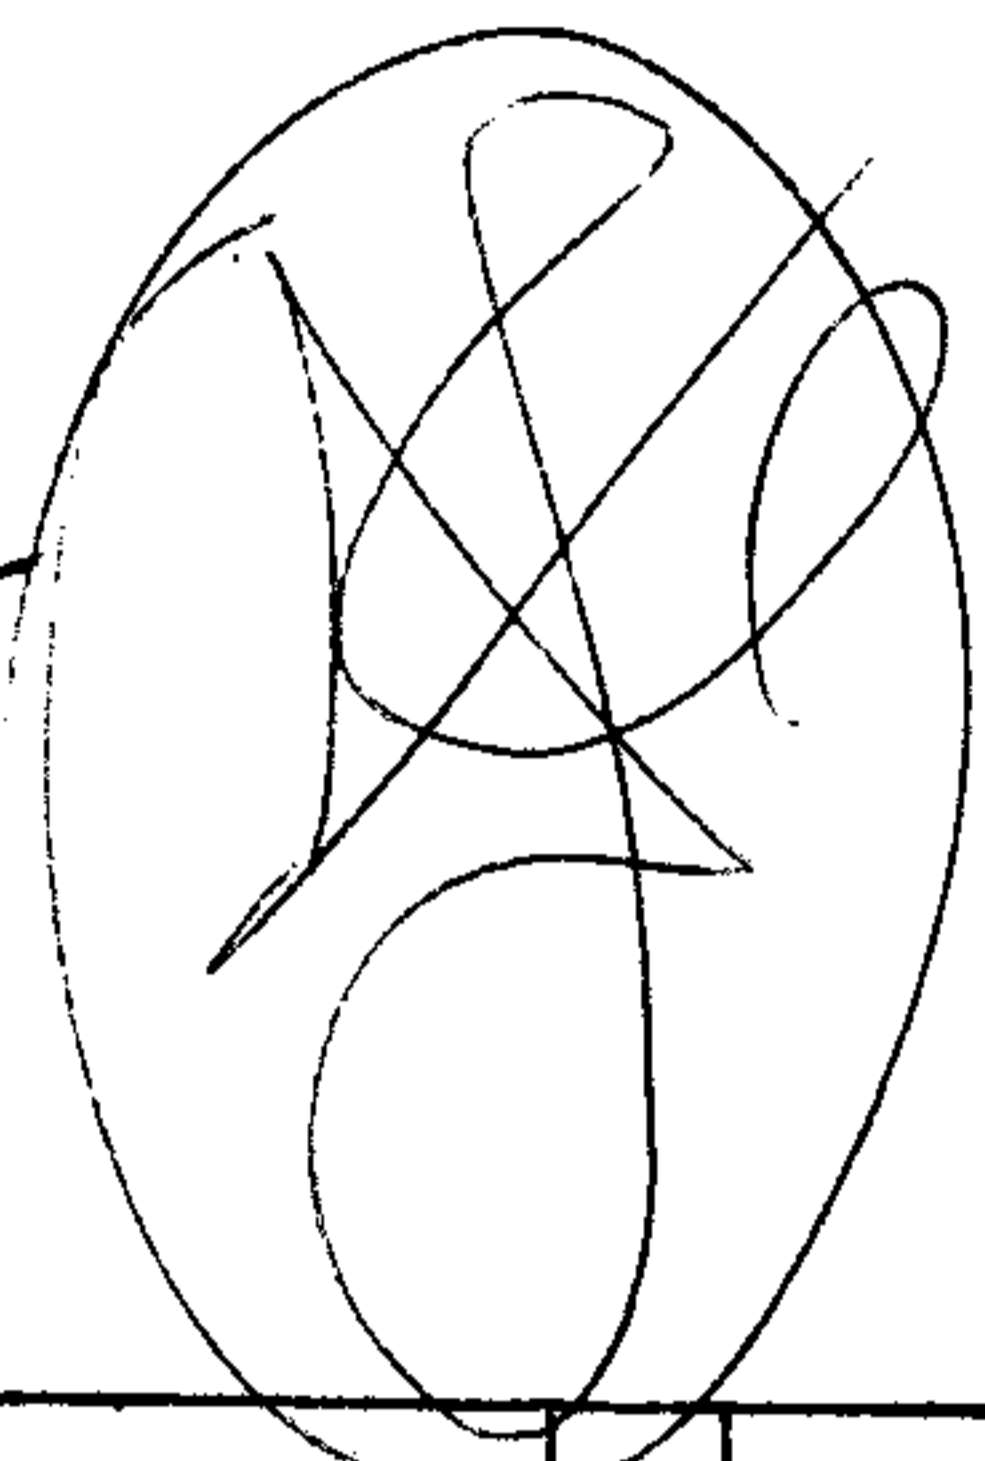

5900

APPROVED
LCRAIN CO.
MAP DEPT.
DATE 5-16-72
7-00-008C
BY LWHall

4.7
98-10-L

126.04
1035.75

Pt. 07-00-008-115-006
Pt. 6.25A
036 219.60
219.60 17A.

117

213.40

7-00-008C

76.50	17
"	18
"	19
"	20
76.50	21
233.71	
689.21	

MEADOW