

5901


D

RD.

18

(60)

356.4
-012
2.00A
248.75
150
250
24.45
1000
-003
5.74A
1000
250

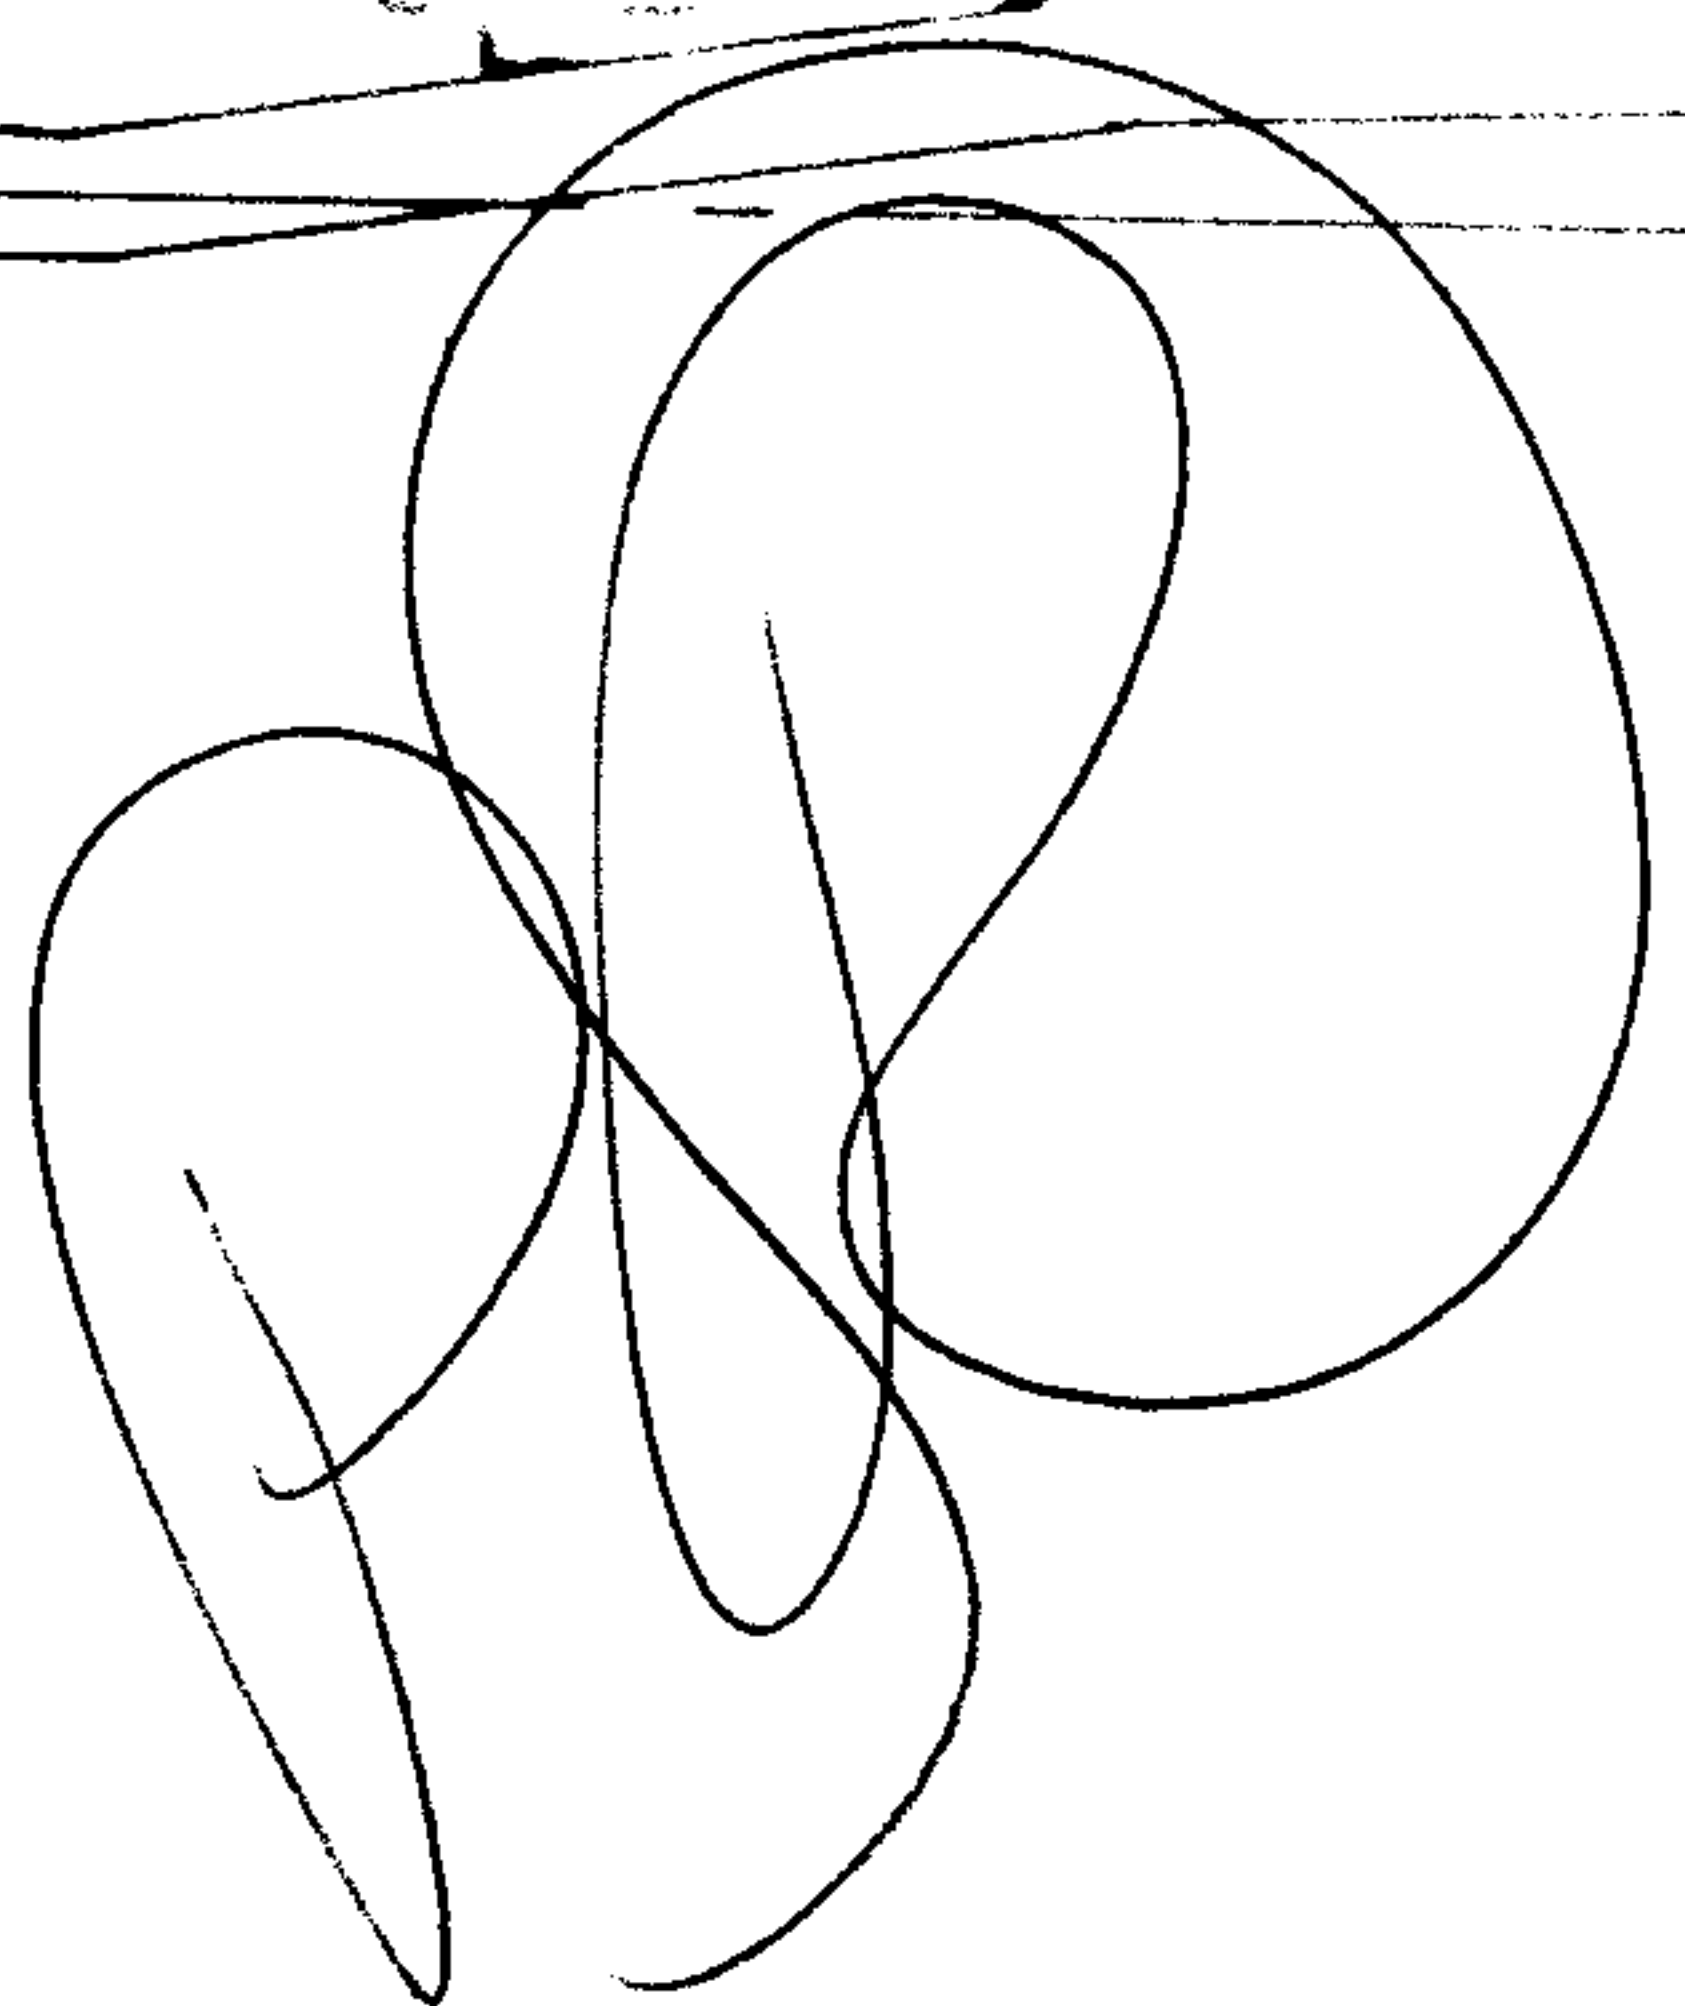

-020
-004
~~125.18A~~
120.18A

203.08
-017
1.00A
203.08
203.08
95A
405.84

RD.

(60)

-016
24.15A

18-80-L
8.8

5901

APPROVED
LORAIN CO.
MAP DEPT.

DATE 5-16-72

18-H

BY
Colwell

689

90°44'

3

794.75
-019
5.00A
794.75

279.6

008
50.10A