

5910 5910

See Also
1-00-028A

PT 025
~~PT 019~~
~~PT 77.11 AC~~
92
PT 72.82 AC


See
Also
1-00-026B

77.11
- 3.28
73.83
91
72.92

1-00-026A

- 026
3.28 AC

- 027
.91 AC Cal

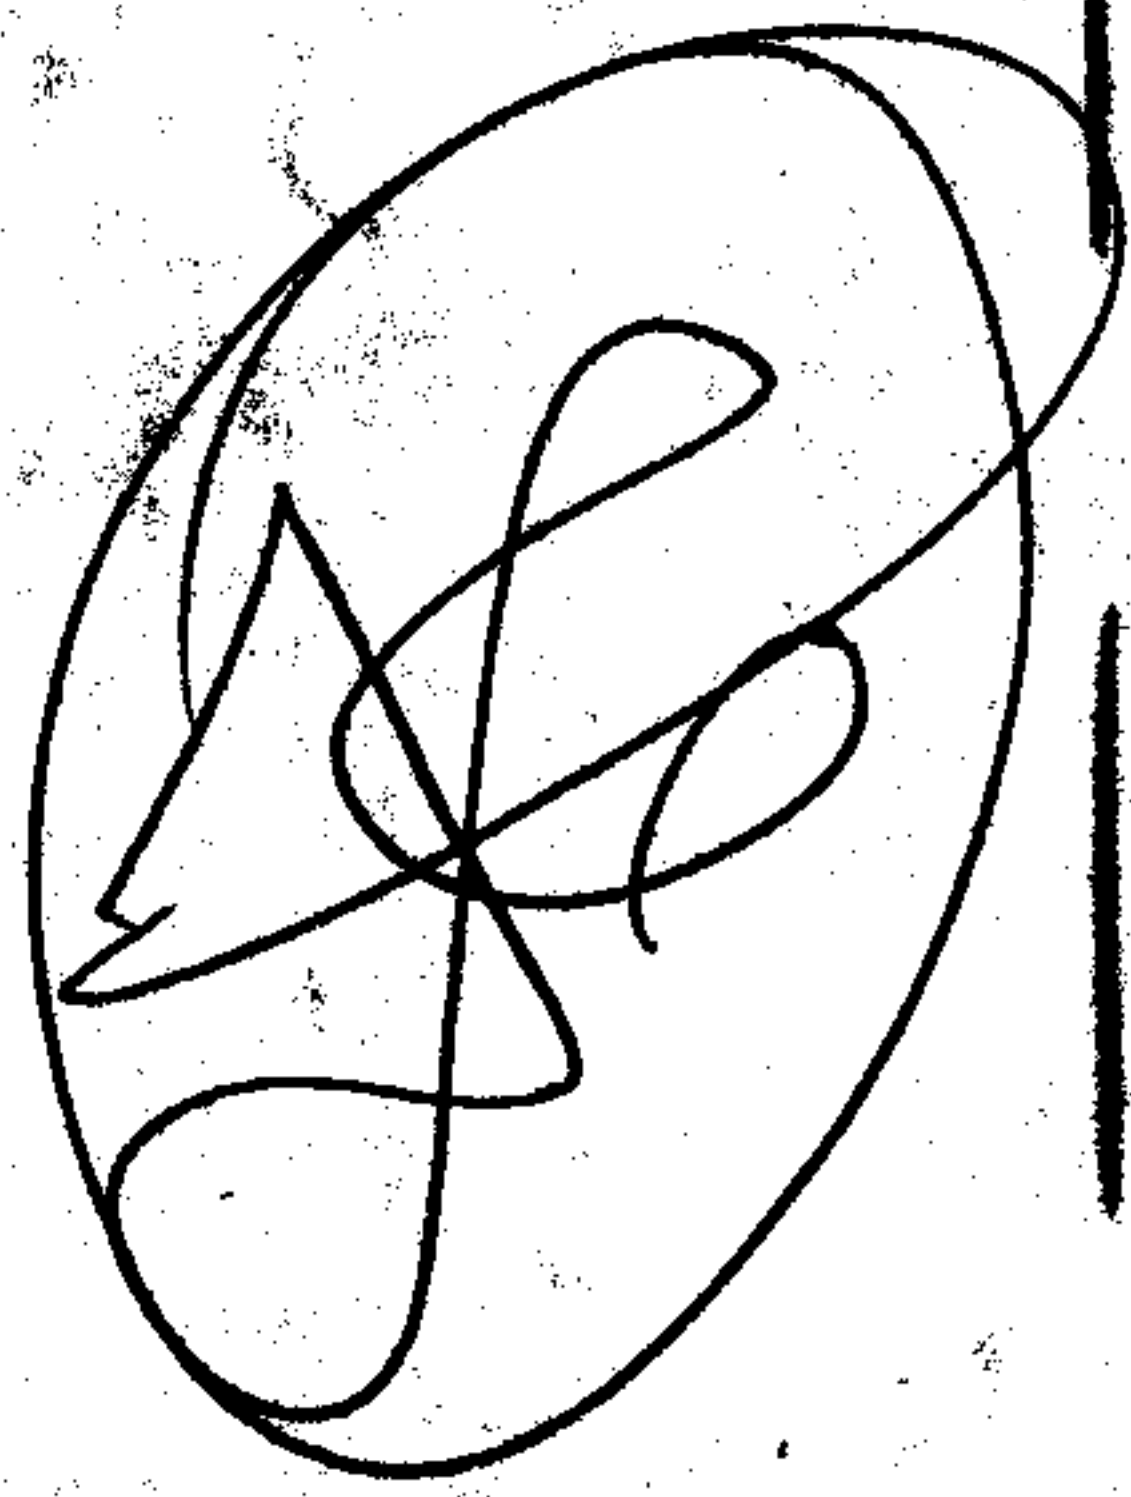

7-21-80
S.S

SEE 1-00-027-B

APPROV
LORAIN CO.
MAP DEPT.
DATE 5-19-72
1-00-026A
BY 026B
033A
L.H. Hall

39975 ÷ 413 = 917 AC

91
328
7282
77.01

675
x 65

208.66

244.84
157.21

615

65

200