

5917

MEDINA

NORWALK

PT. 17

RD. 60

-007
49.05 A

-001
30.00 A

1699.50

1140

-001
30.00 A

-002
17.50 A

1721.28

-003
18.00 A

APPROVED
LORAIN CO. MAP DEPT.
DATE 5/23/72
17-E
BY R.J. Kelling

-002
50.00 A

926.45

~~1760.88~~
1450.88


-008
-003
45.82 A
43.46
16

310
-007
2.36 A
310

-004
24.28 A

744.60
447.8

813.25

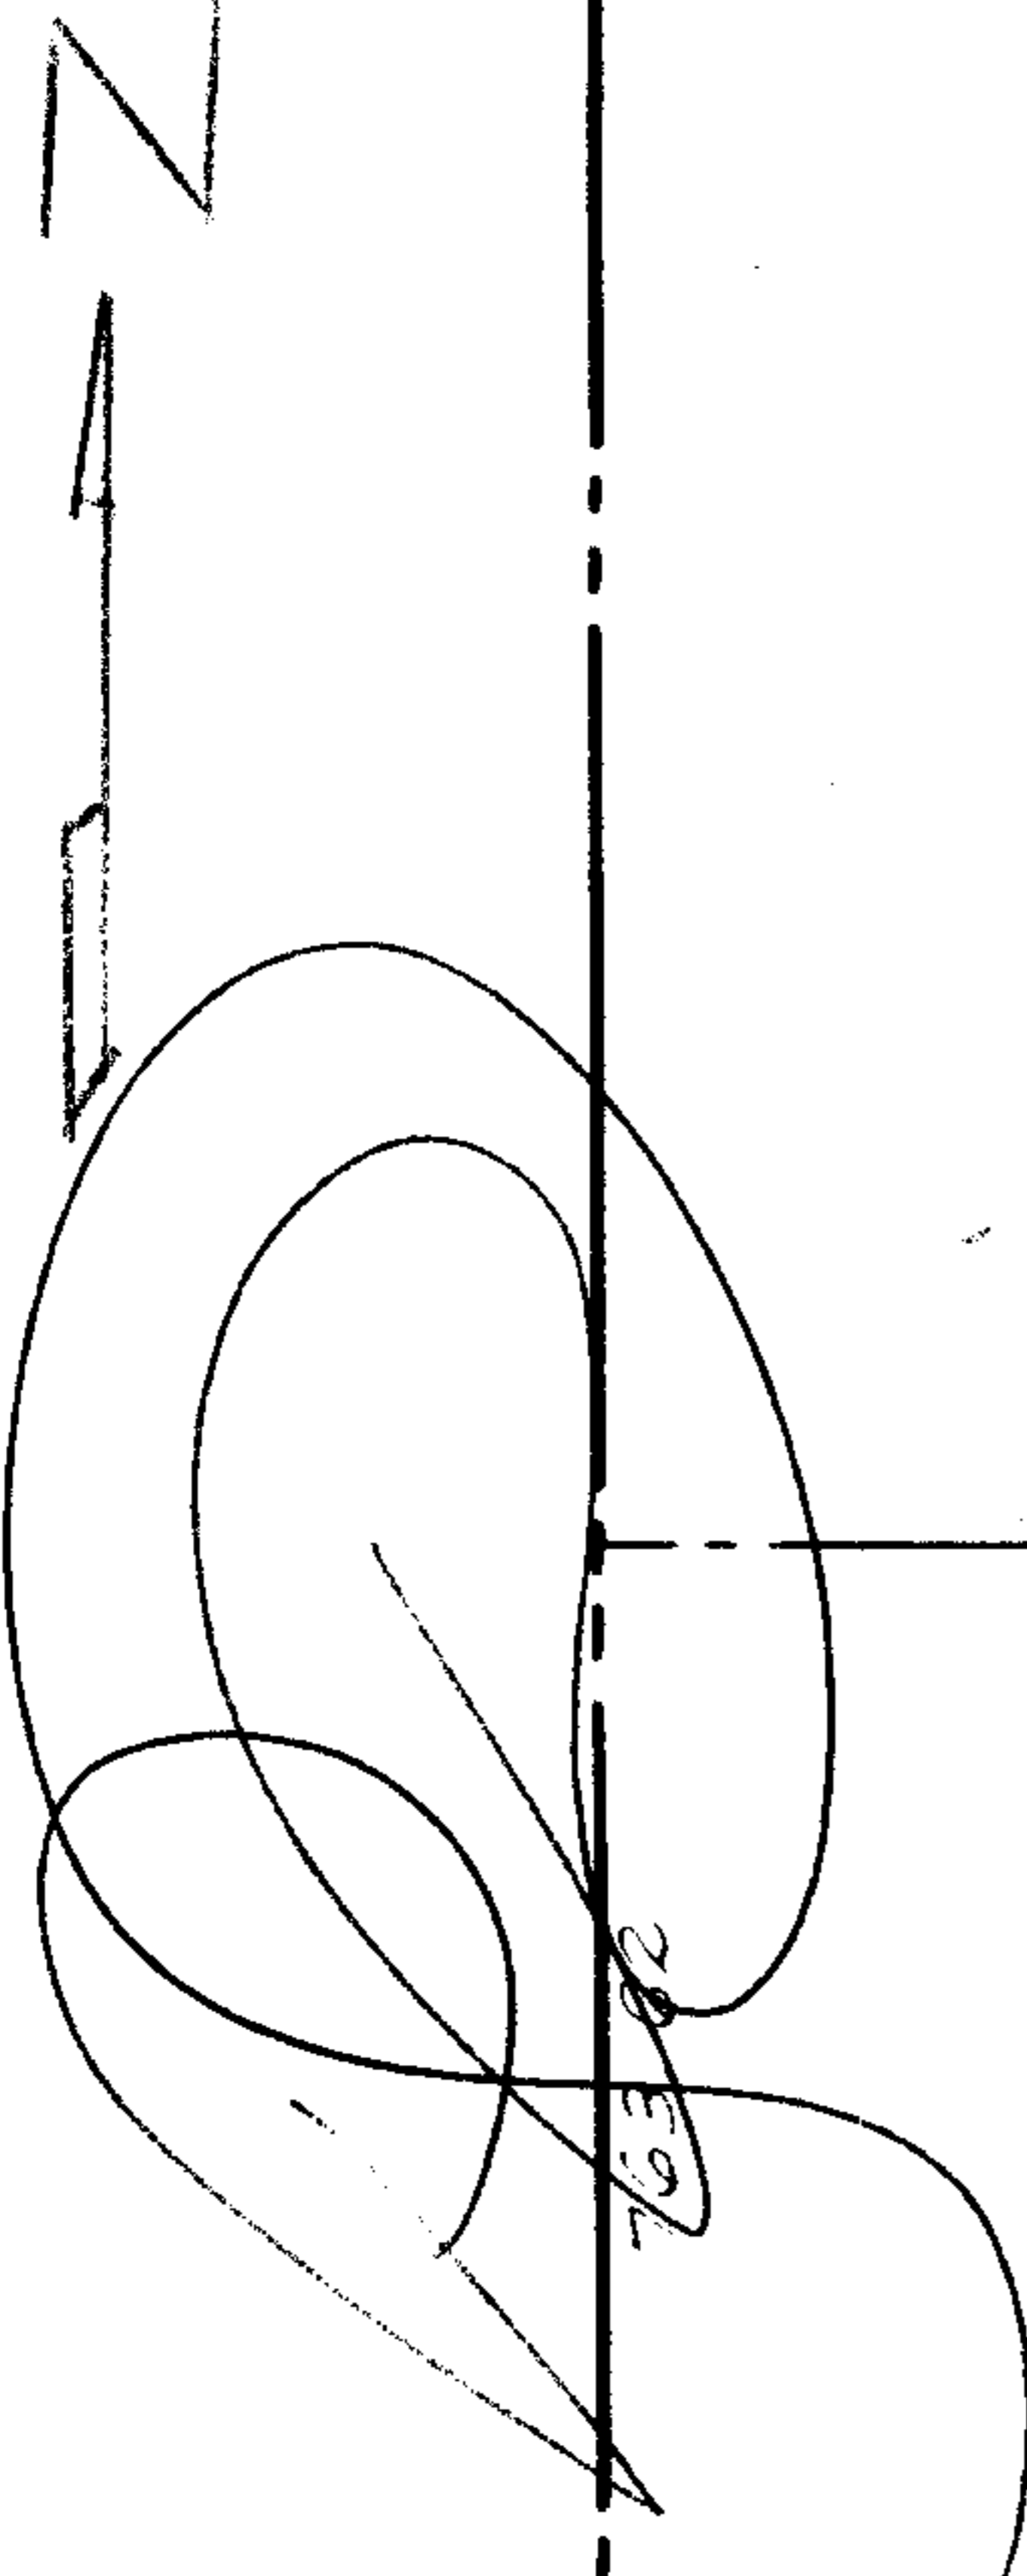

1247.60
503
744.60

171
332
503
~~1760.88~~
310
1450.88

1251.36

1251.36

247.6
332.880

1218.9

(120 ± 90)
-006
4.07 A
1032.60

25 937.62

90