

5919

182.05

623.58

-026
~~-025~~
~~4.99A~~
3.61

118.23

463.58

101


300

-024
3.19A.

300

1130

463.58

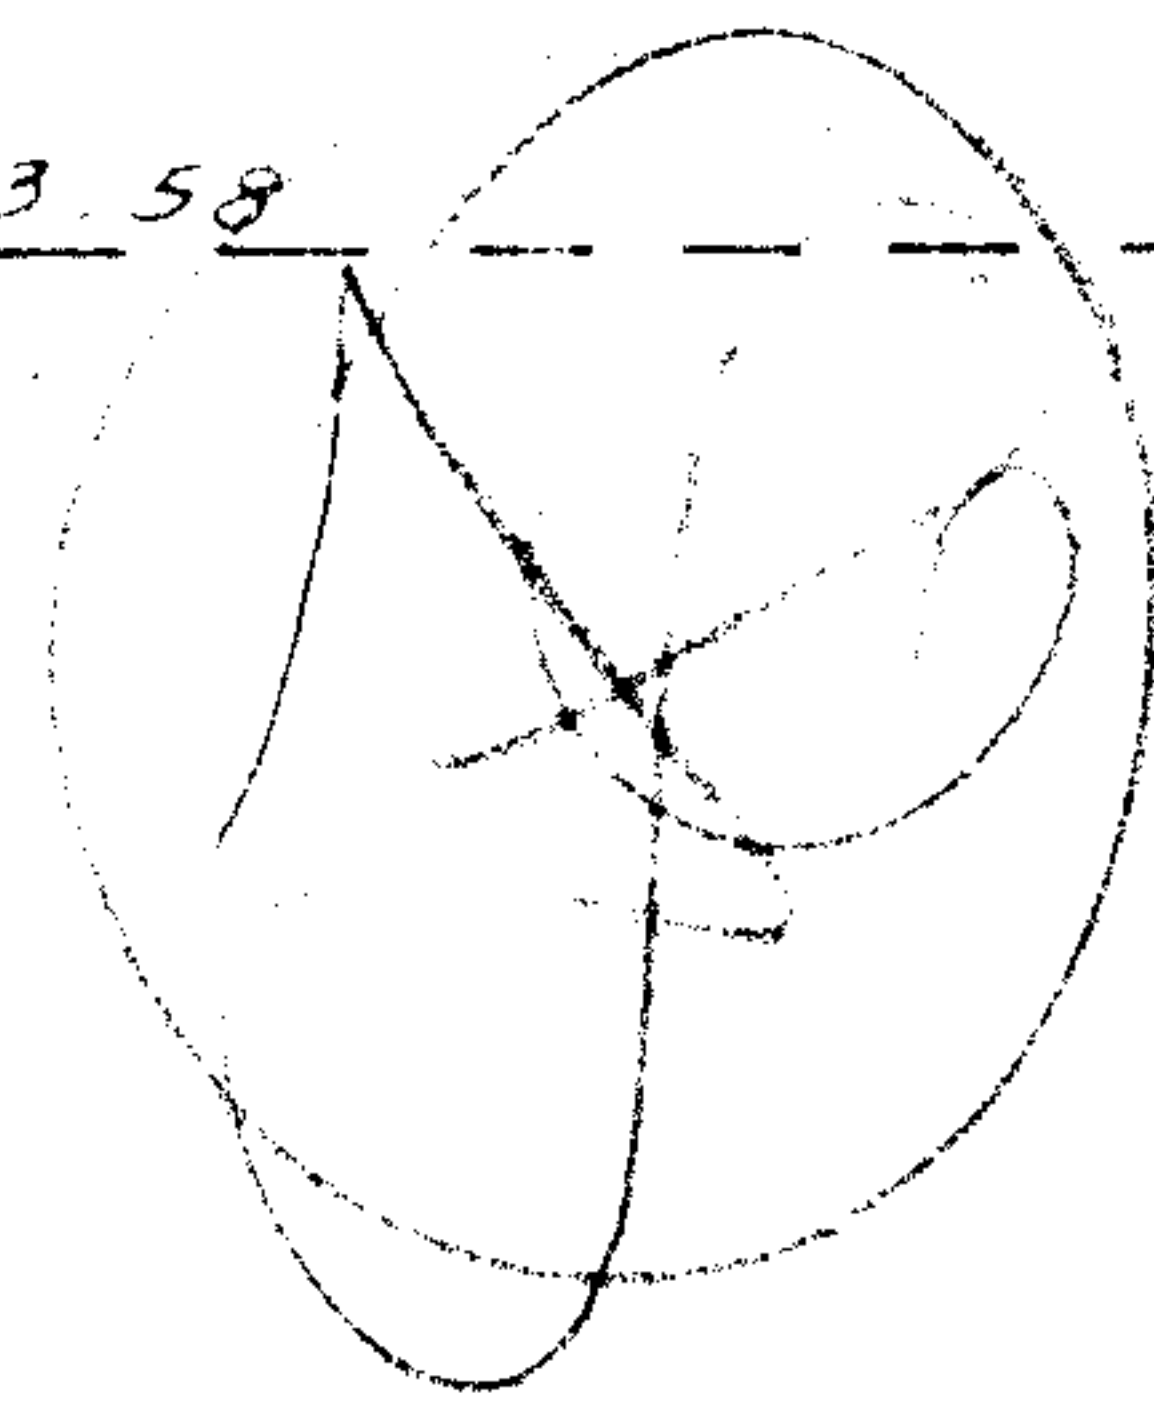

SEE 9-00-077-B

400

-019
4.00A

S.S. 7-22-86

APPROVED
LORAIN CO.
MAP DEPT.
DATE 3/24/77
9-00-077A-
BY: R. J. Kelling

400

-027
1.65A.
1200

1557.60

112.58