
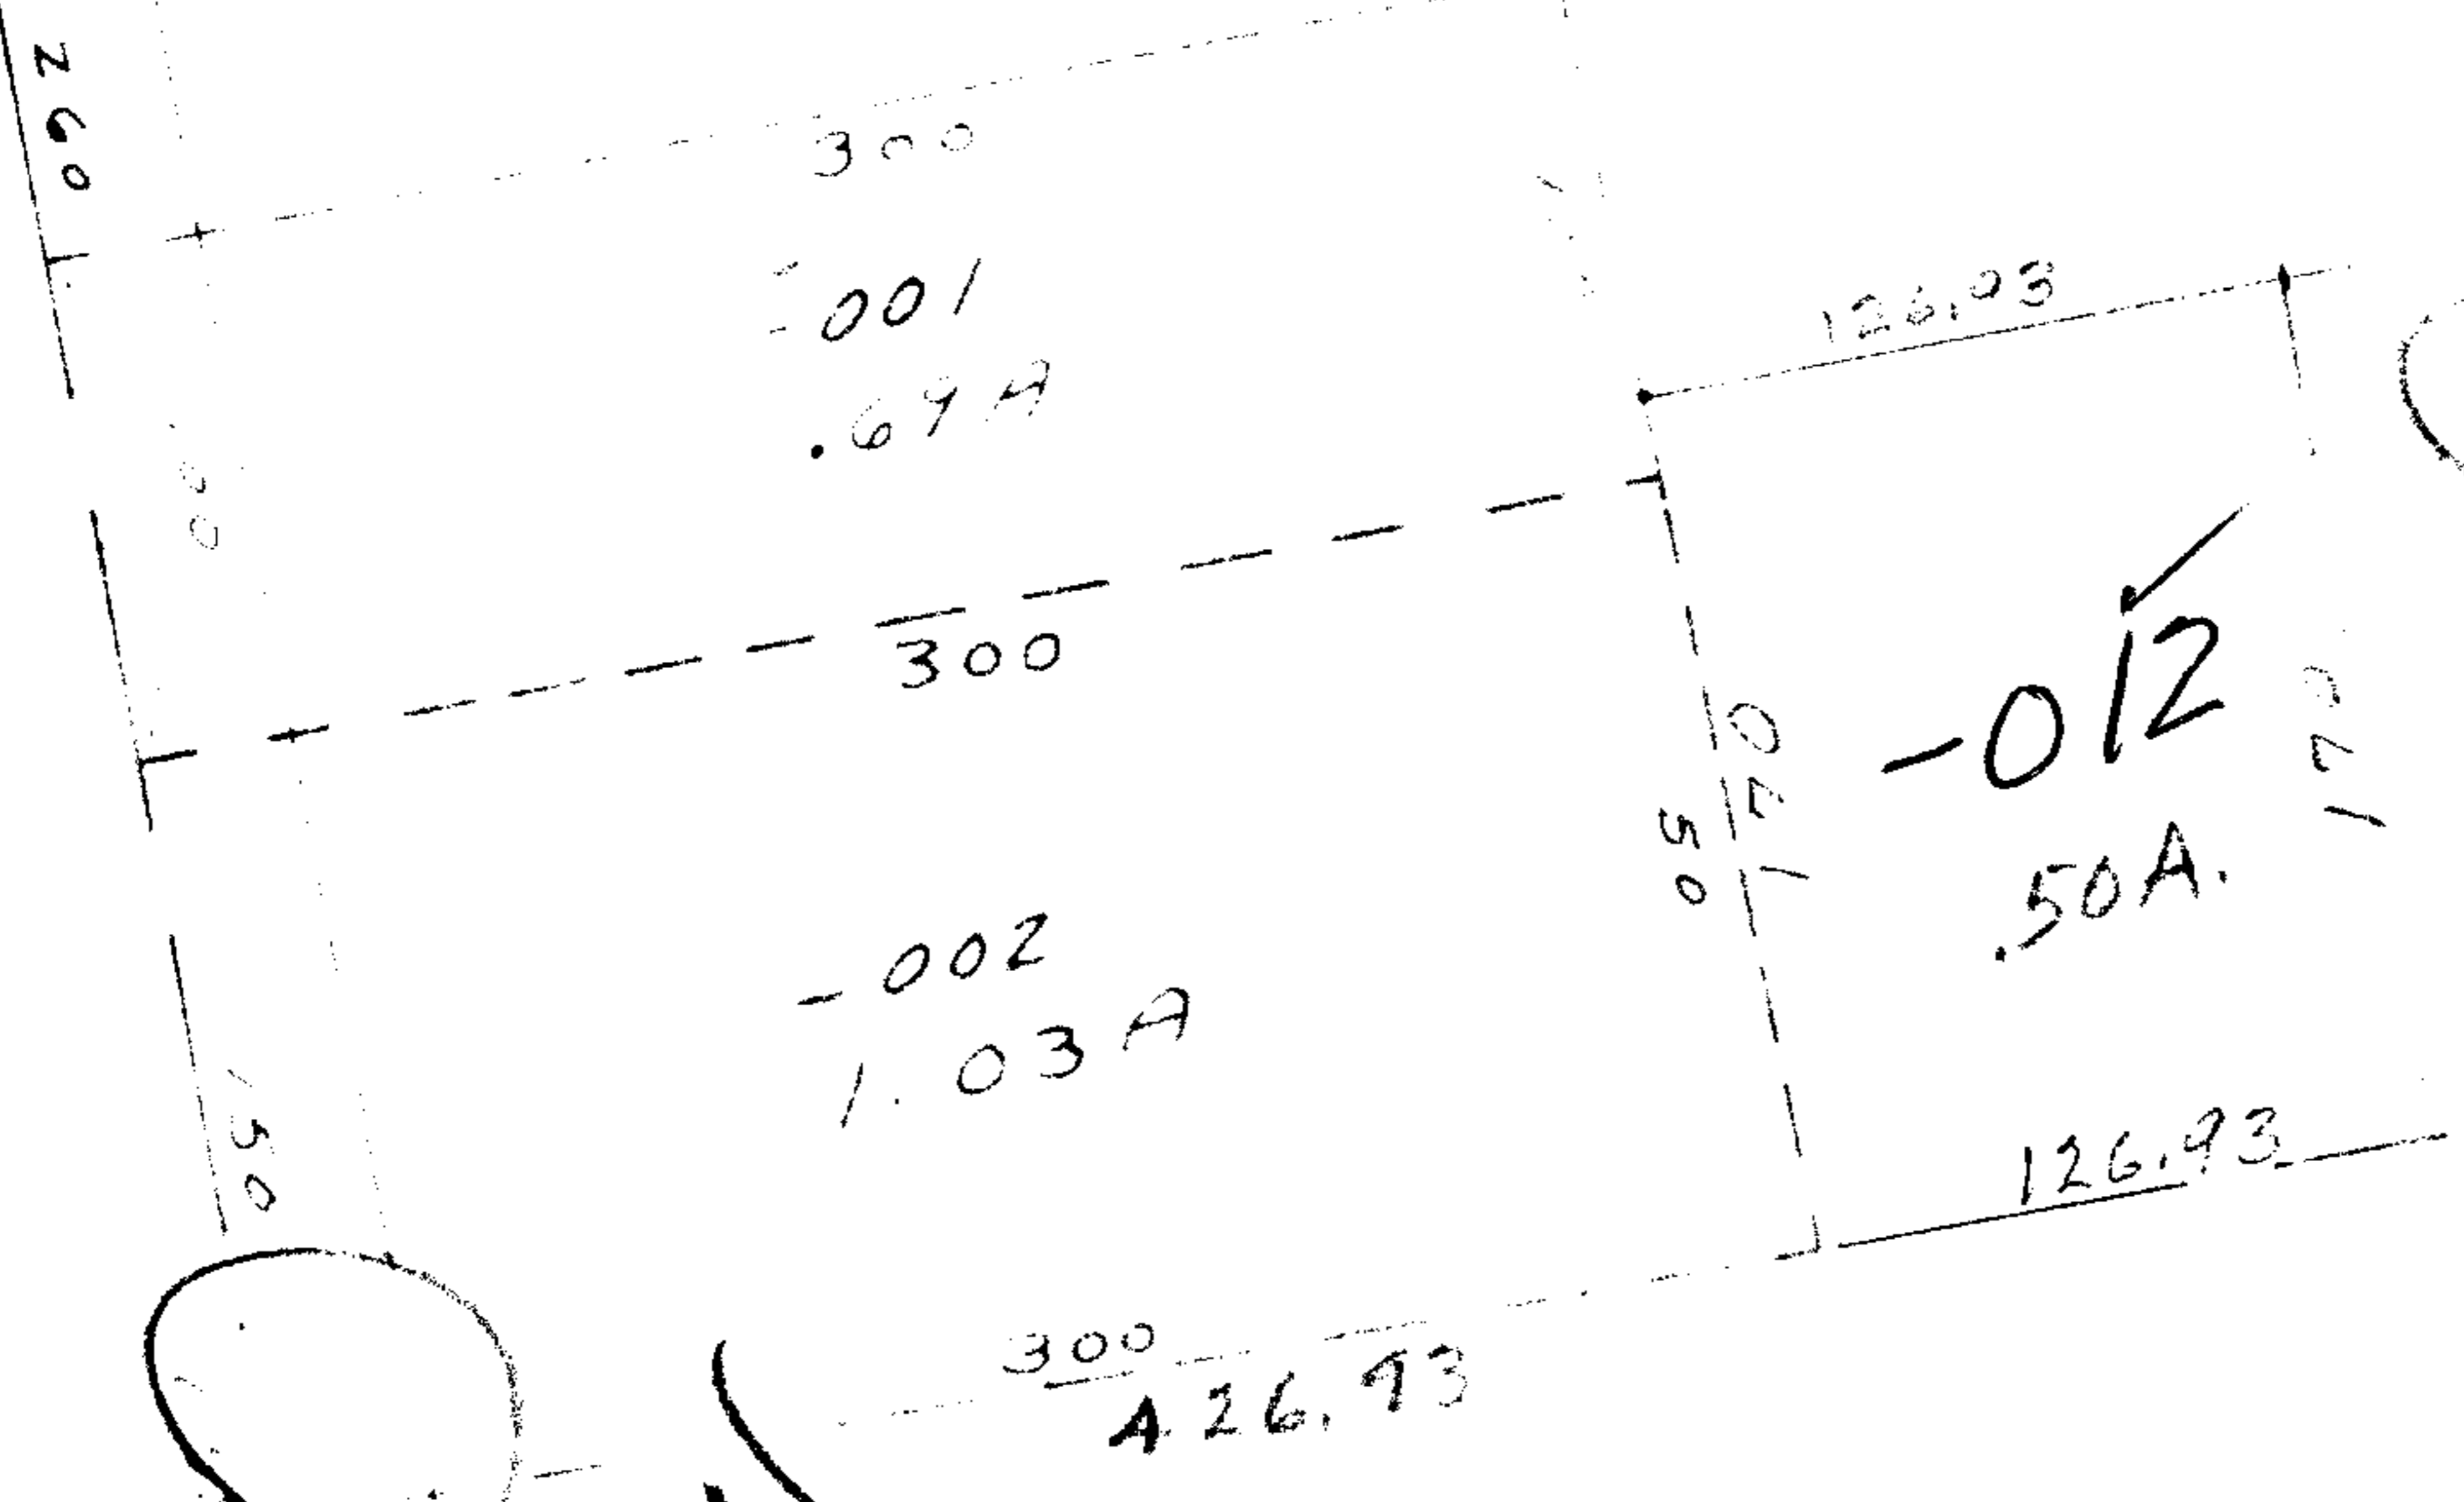


5929

APPROVED
LORAIN CO.
MAP DEPT.
DATE 5/26/72
6-110
BY
R. J. Kelley

RD.

103°45'

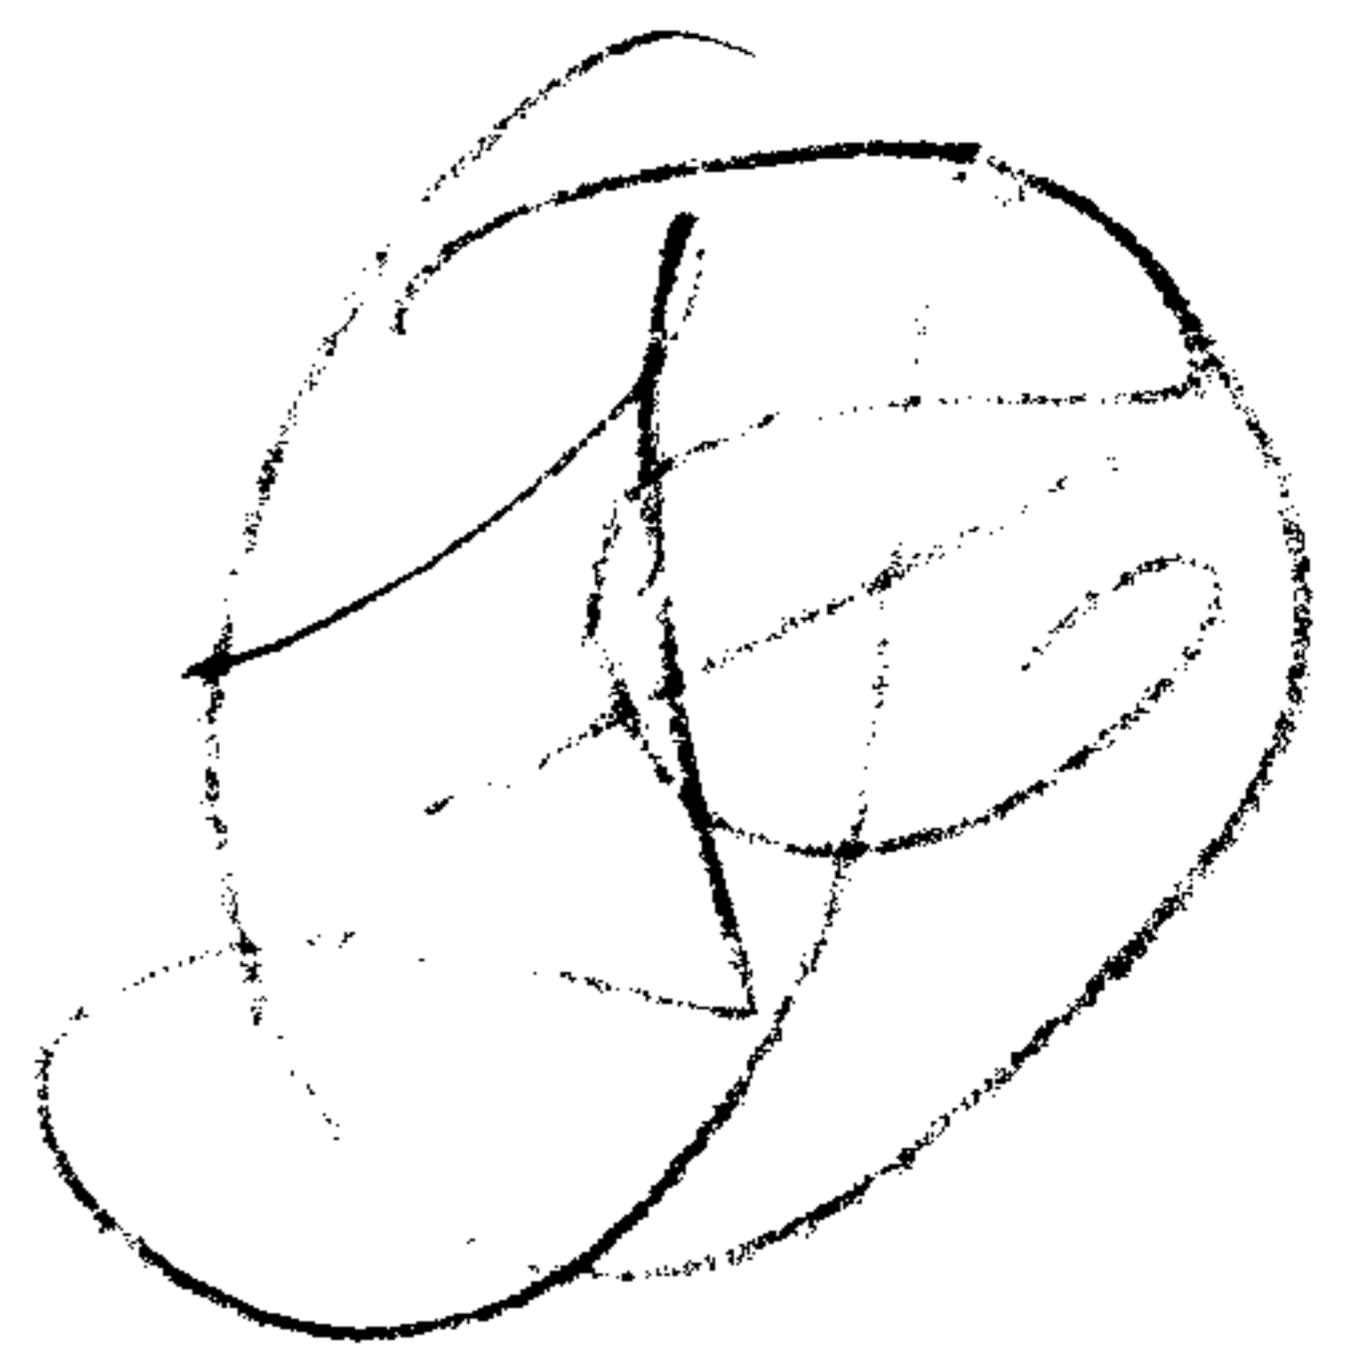

This Line
may have
to be shifted

Note This Line may have to be shifted

051
1.51A

052
1.60A

3