

48.60 A.

5933

89°33' 90°47'
395.24

146.7

14

90°09'

-001
11.40 A.

-002
12.00 A. Dup.
12.74 A. Deed

346.8

346.5

89°34'

437.50

90°49'

410.5

1436.82

1791.9

994.62

-016

986

16.31 A.



195.09

89°16'

2783.13

-012

15.01 A.

2781.96

235.01

235

-013

30.00 A.

470.02

470

~~810~~


~~111.69 A.~~

2779.64

33

470.16

5933

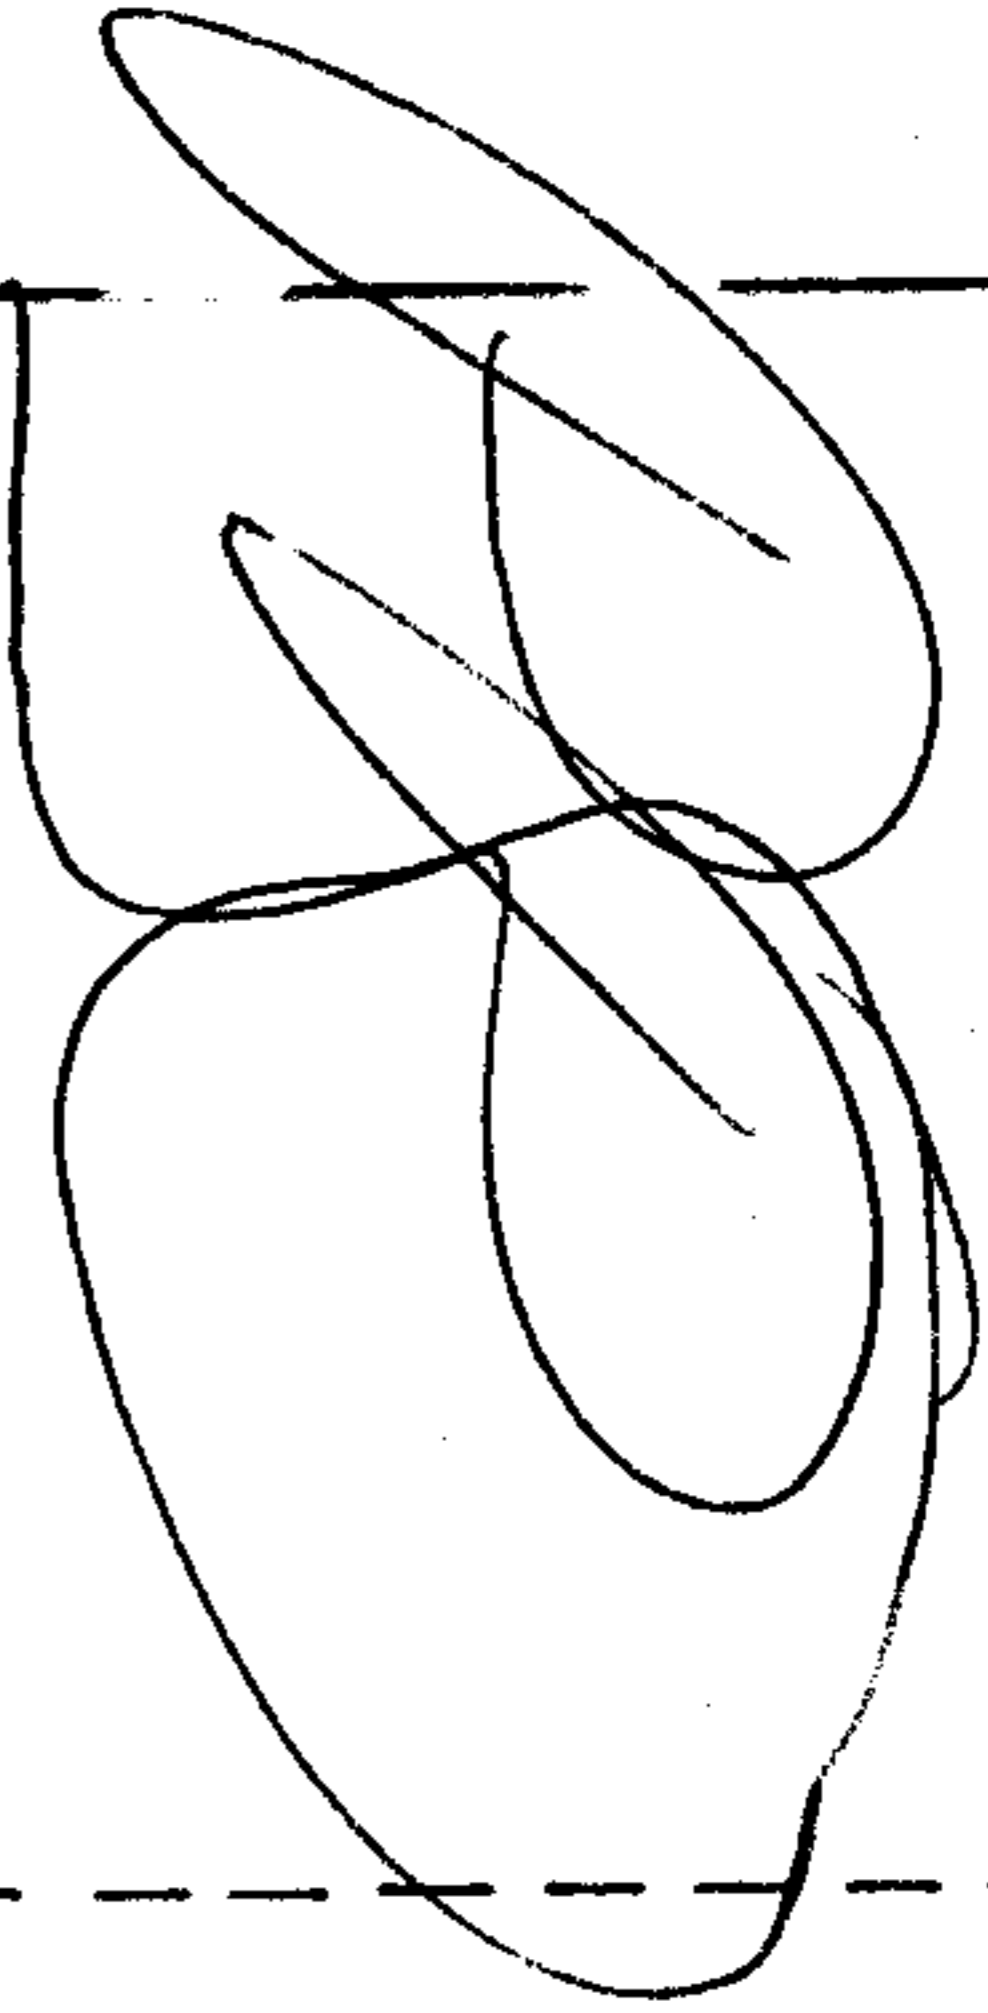

~~514~~

-015

50.37 A.

~~66.68 A.~~

800.04

700

APPROVED

LORAIN CO.

MAP DEPT.

DATE 5-31-72

16-D

BY

Richard

2495.68

2771.97

-011

37.95 A.

597.30

597.3

90°31'

89°19'

2772.66

485.76

200

66.68

50.37

16.31

485.76

-001
6.54 A.

586.74

5.84 A.

786.74

-016

685.76

200

-031

38.40 A.

1318.687

16 D

-005 sec
46.00 A. 5875
5876

Before This Split

1397.30

280
100
100
100
100

7-29-86 h.k.