


5940

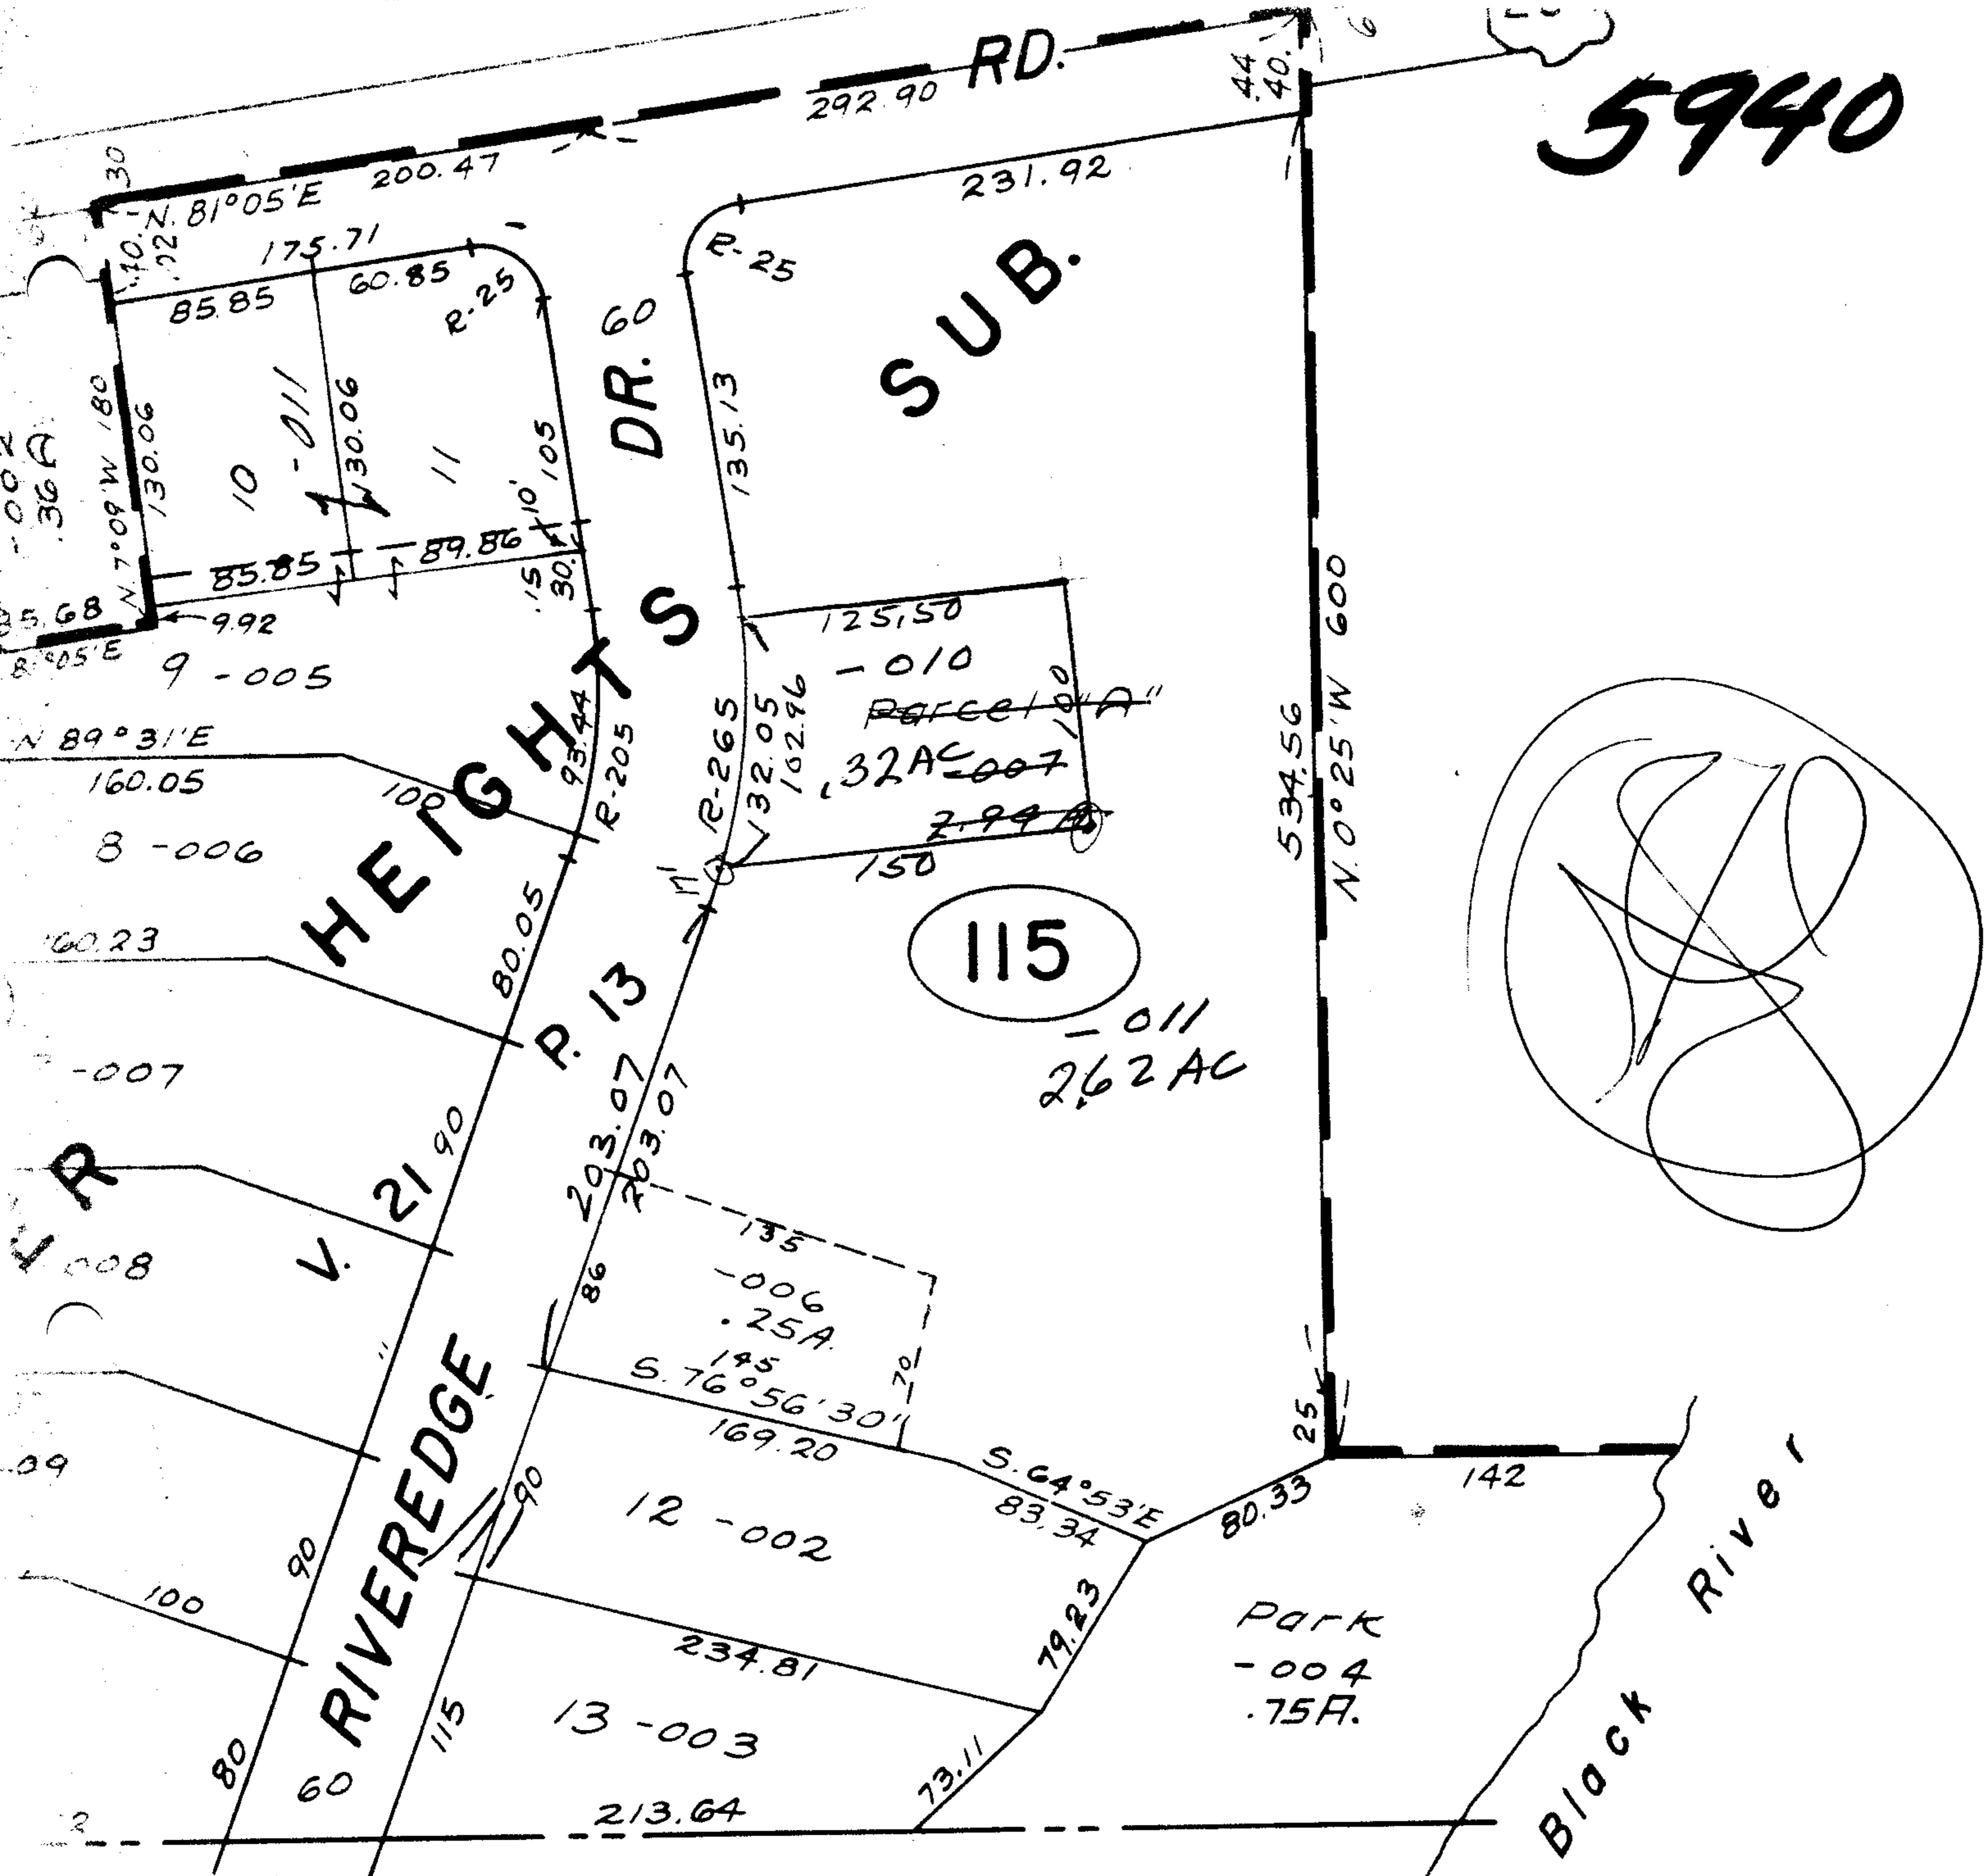

5940  
**APPROVED**  
**LORAIN CO.**  
 5-31-72  
 03-00-075B  
 LWHall

7-21-86  
5.5

9/18-72  
91

Copyright 1964  
REV. 2-27-61

LOTS 75 & 76

3-00-075-B