

447.30  
Pt. -063  
Pt. 1.62A.

793.95  
-016  
1.89A.

~~Pt. 059~~  
~~Pt. 2.09A.~~

273.95

520  
-050  
1.21

Pt. -072  
Pt. 3.22A.

~~Pt. 060~~  
~~Pt. 2.45A.~~

-071  
1.27A.

202.58  
101.27

Kramer  
Wakefield

-02  
1.2  
52.

1602.05  
1601.71

273.95

Pt. -061  
Pt. 1.53A.

101.27

-023  
1.83A.

5942

-055  
2.25A.

-054  
1.47A.


APPROVED  
LORAIN CO.  
MAP DEPT.  
DATE 6-2-72  
4-00-018-J  
BY *[Signature]*

101.27

1596.79

630

Pt. -025  
Pt. 9.78A.

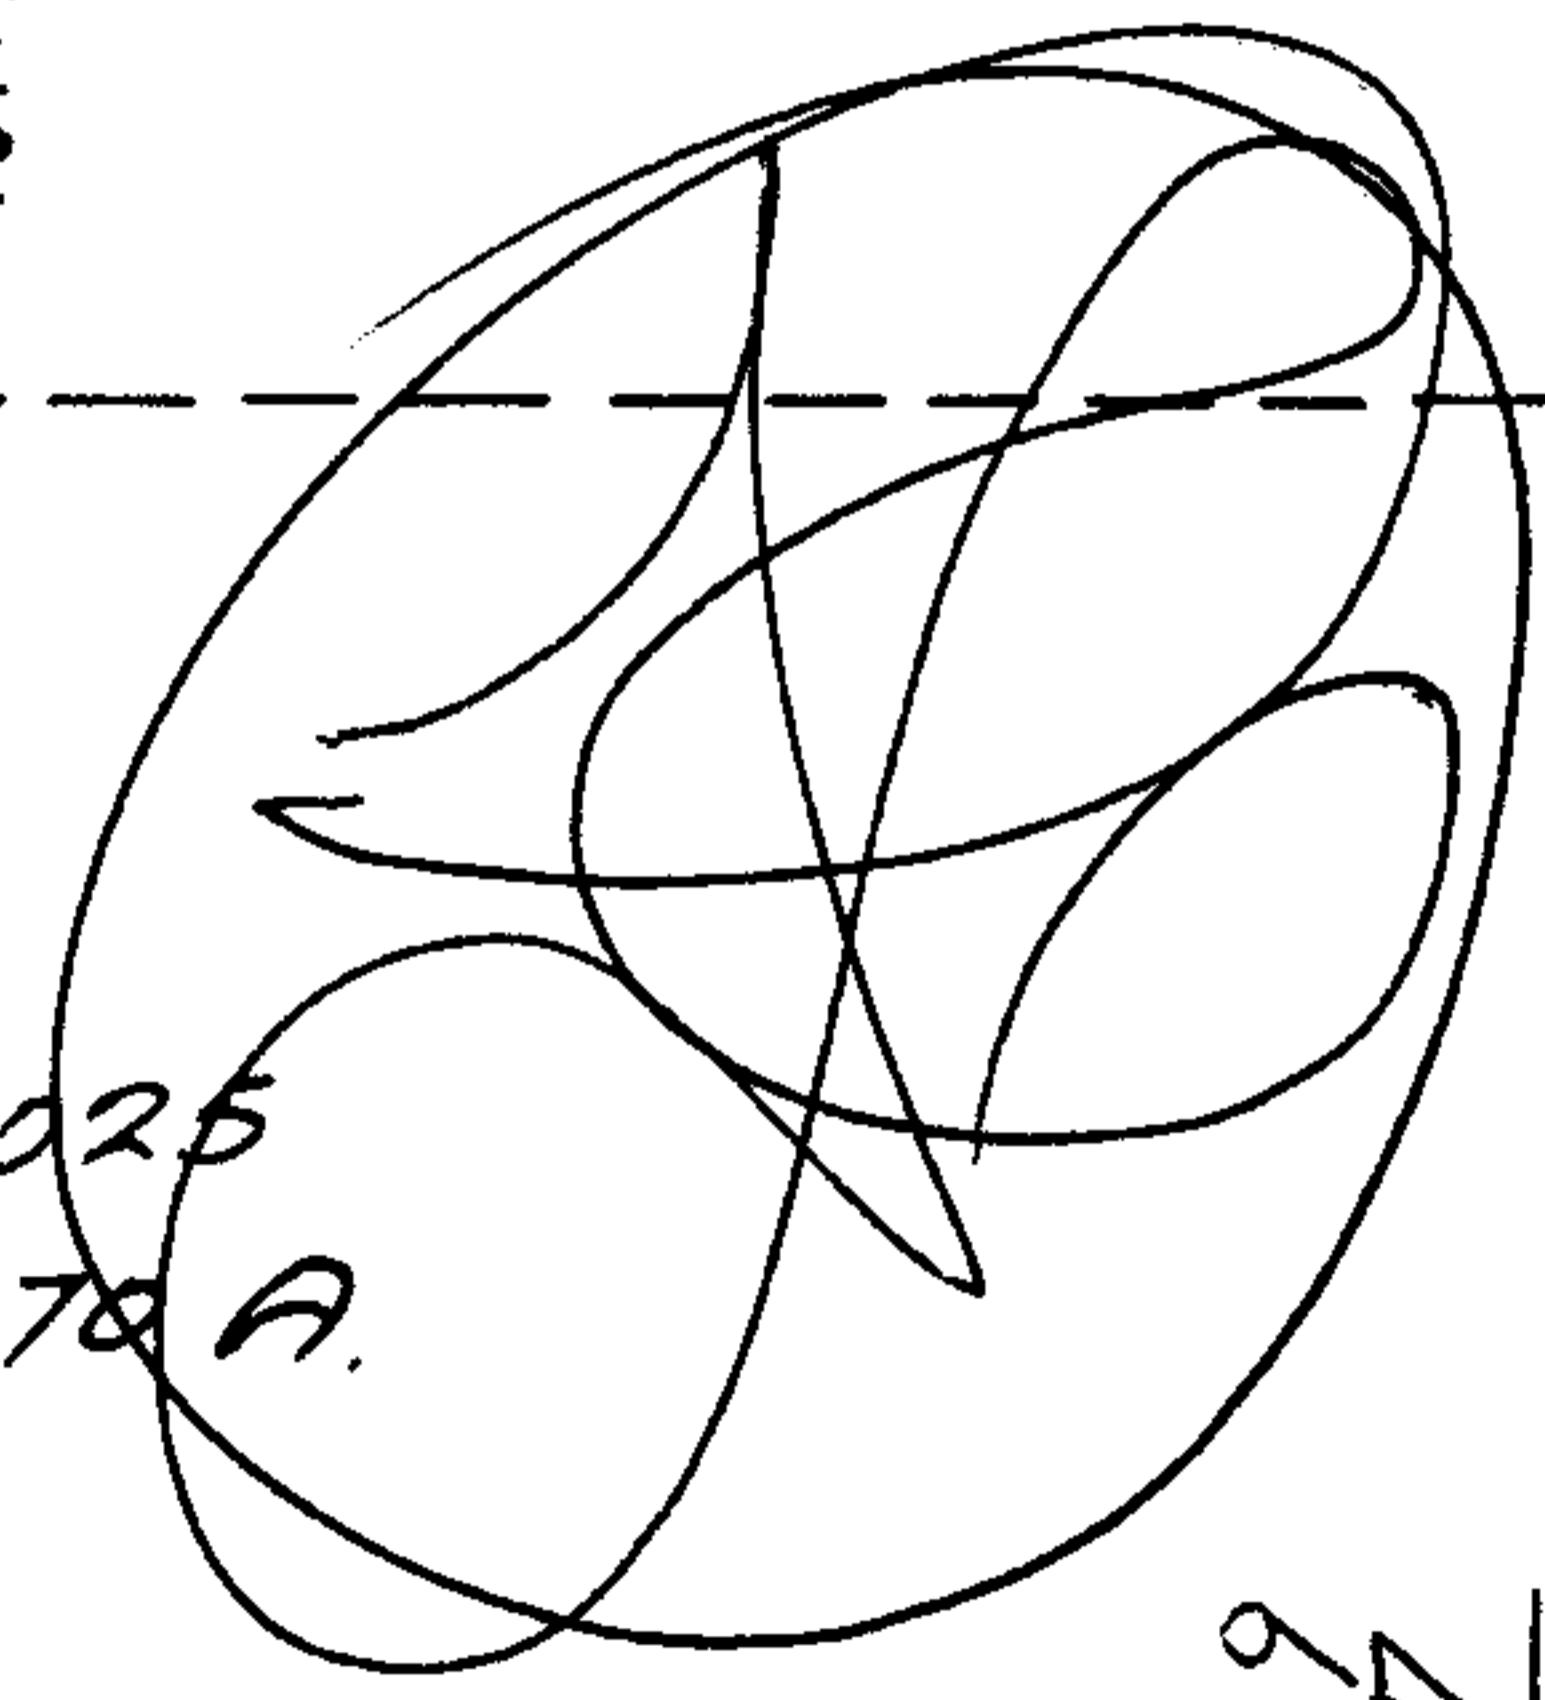

449  
127  
3.22

4-00-018J

7-21-86 L

2353.03

5942