

5950
5950

-030
~~-014~~
~~19.47A.~~
16.64 A.

19.47
2.83
16.64

5950

APPROVED
LORAIN CO.
MAP DEPT.
DATE 6-2-72
5-00-052-B
BY *[Signature]*

7-21-86 L.L.

OBERLIN

198.97

617.70

-029
2.83 A.

615.35


200
60

110

222

-02
1.20

25

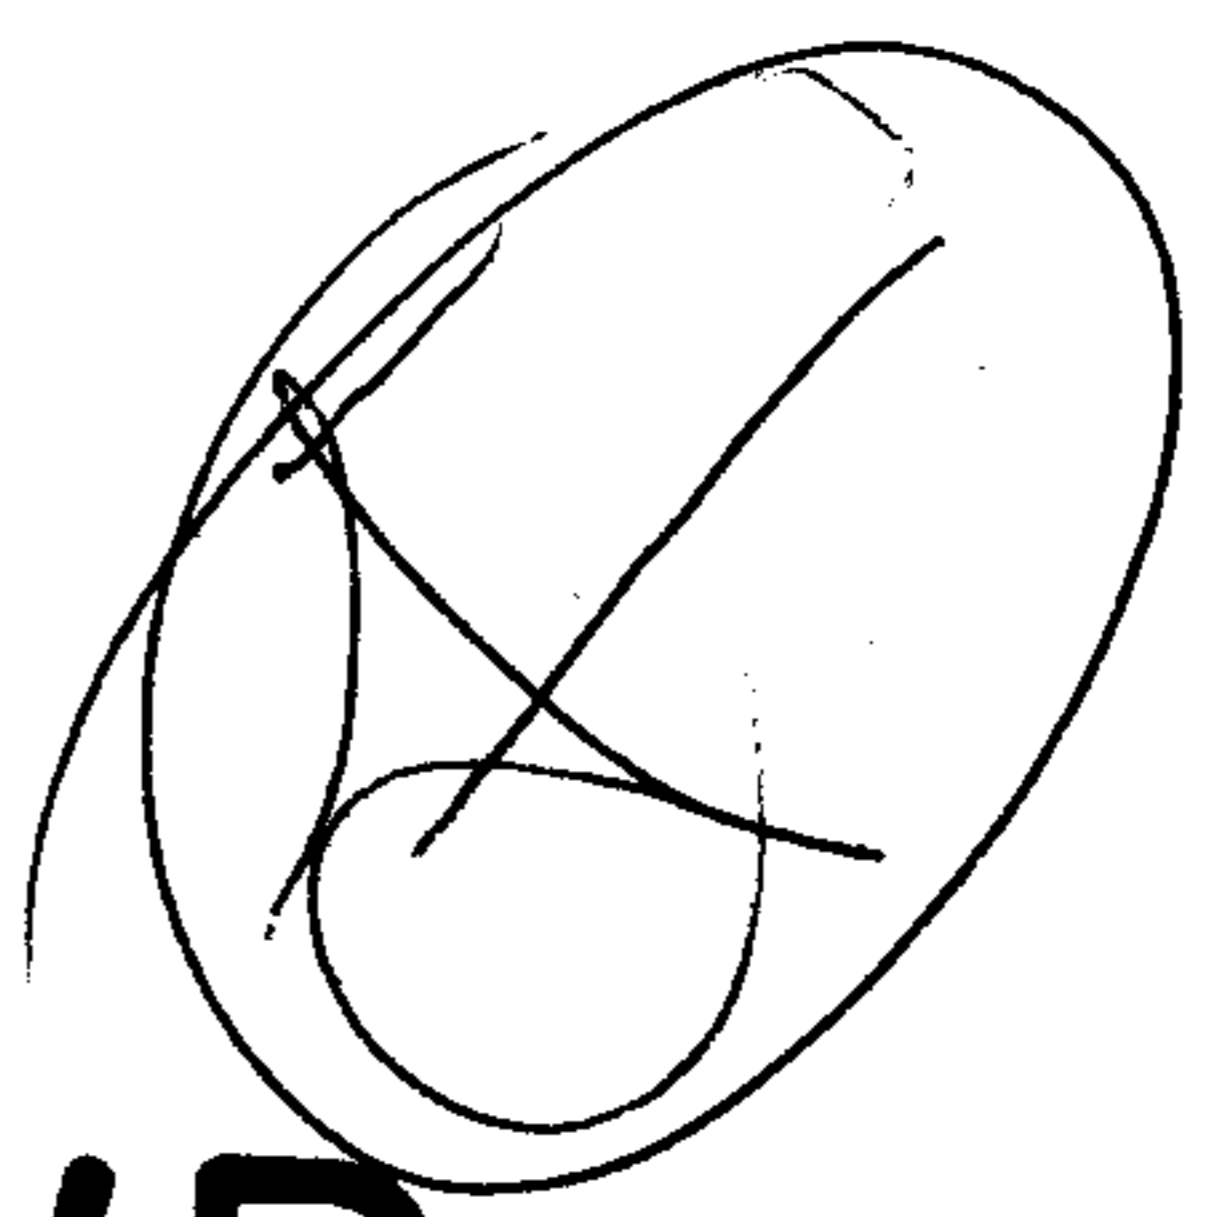

AMHERST TWP.

SCALE: 1" = 100'

5-00-052B