

PT-014
PT 449A

-024
10.28A.

Move Line To Match
7-00-023-B →

218.53

APPROVED
LORAIN CO.
MAP DEPT.
DATE 6-8-72
7-00-023-D
BY <i>[Signature]</i>


5976

PT-015
PT 1600A

152910
123710

7-21-80
L.L.

SEE 7-00-014-C

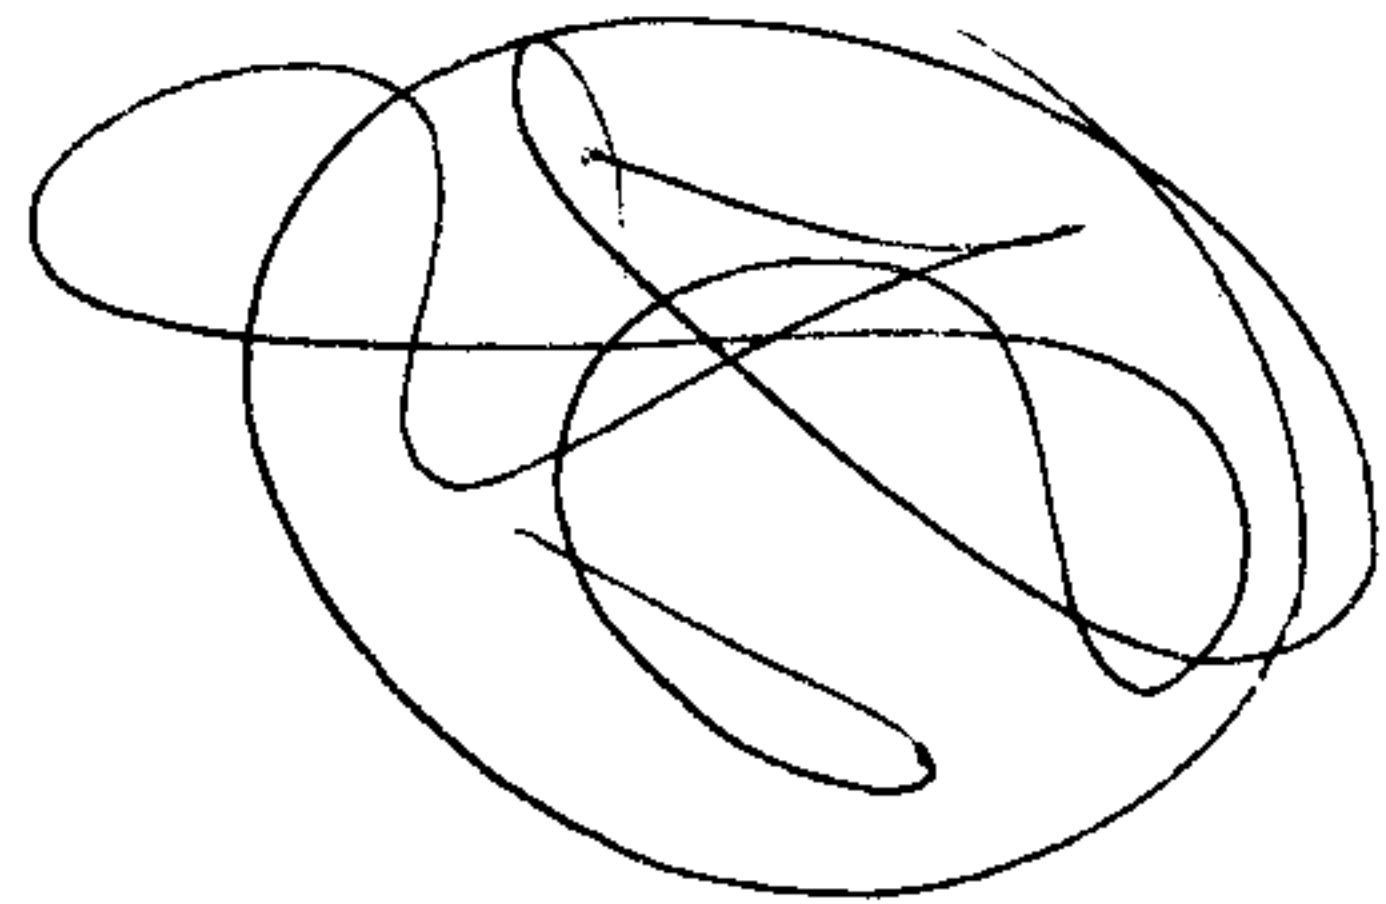

5976

9/20/72