

5981
5981

-013
13.00 A.

025
40.08 A.

22

2673.0

400

-030

~~-014~~
-031
-031

-030

55.00 A.

400

233
-015
1.52 AC
1.52

53.48 AC
5348

2685.0

2687.0

-021
23.73 A

5981

APPROVED
LORAIN CO.
MAP DEPT.
DATE 6-7-72
10 F
BY LWH/HA


-017
88.00 A Dup.
93.00 A. (Deed)

P. 8-5-86

10 F

2124

WHITEHEAD

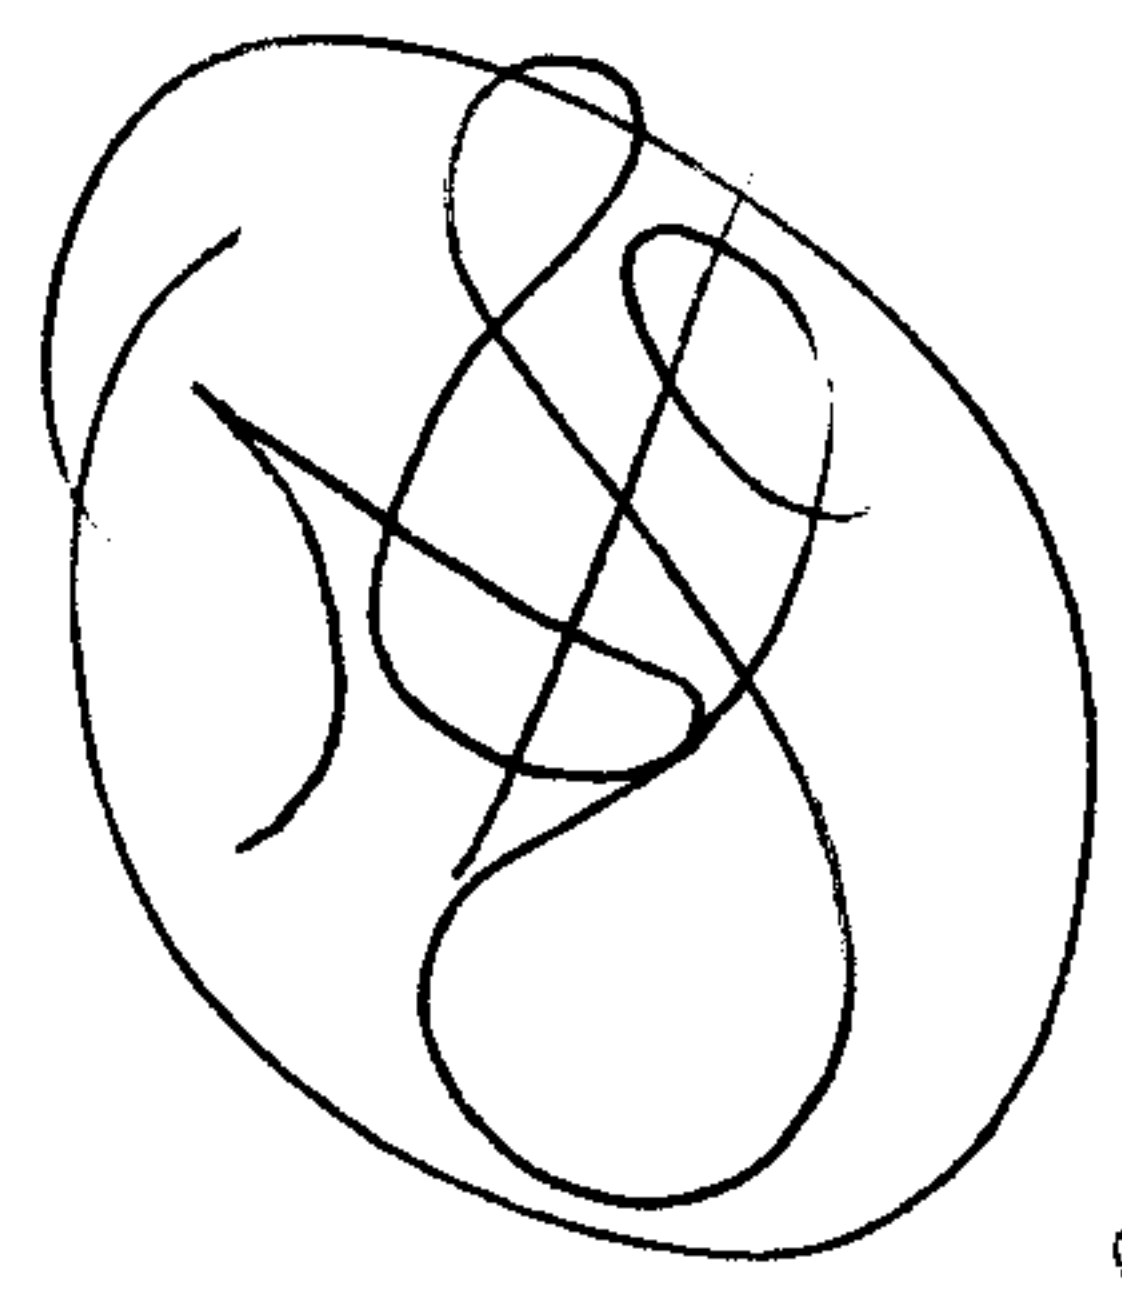

89°49'

89°25'

90°30'

89°41'

88°22'

1951.0

1949.5

1953.50

1519.57

944.8

935

398.25

52.30
7.23

-024
2.92 A.

400

378.02

502.90

1200

431

271.78

271.78

935.6

607.47

90°30'

89°25'

435

89°55'

1953.50

1519.57

765

435.60
-020 1.33 A
429.60

1951.0

1949.5

40°35'

558.2

167

275

275

167

167

