


5993



5993

APPROVED
LORAIN CO.
MAP DEPT.
DATE 6/13/72
18-00-021-D
BY
R. J. Kelling

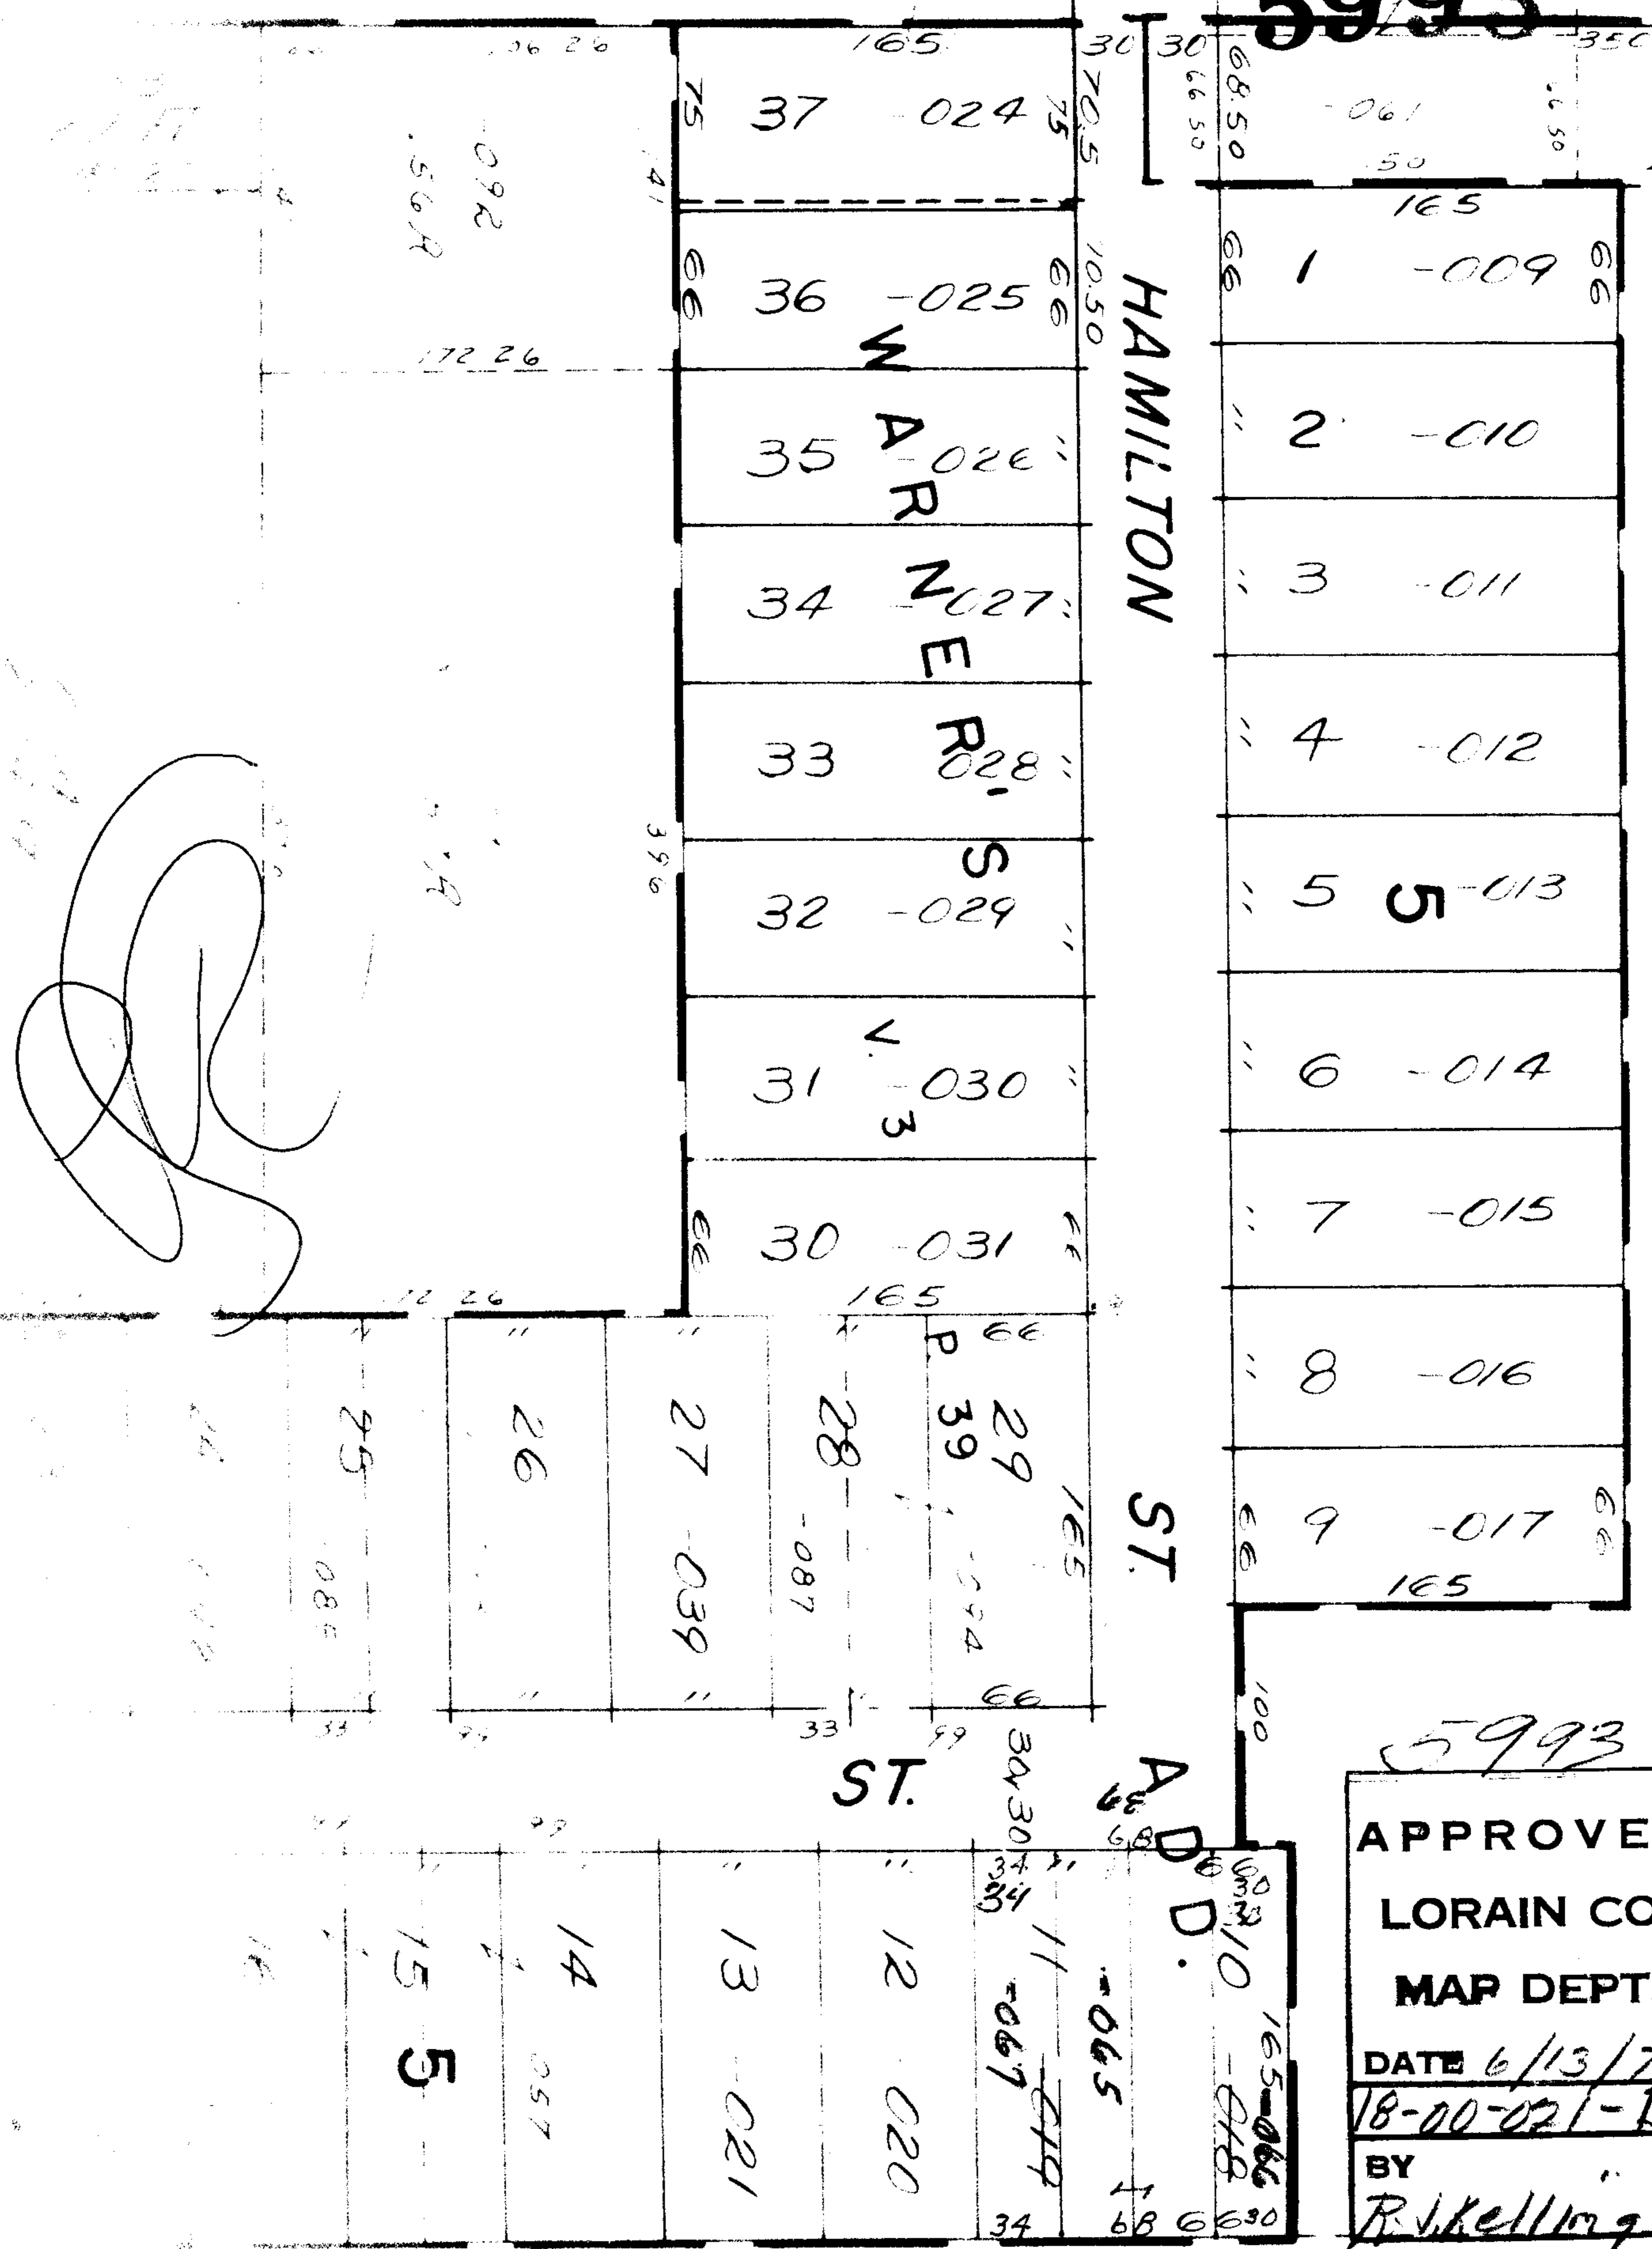